


REFERENCE SOUND/VIDEO BACK BOX SCHEDULE FOR EXTENDED WIRING INFORMATION & REQUIREMENTS.

NOTE:  
THEATRE WORK (SOUND, VIDEO AND INTERCOMMUNICATIONS WORK, TERMINATION OF THEATRE LIGHTING AND INSTRUMENTS, THEATRE DIMMER WORK, STAGE RIGGING, STAGE DRAPERIES) IS NOT PART OF THIS CONTRACT. IT IS INCLUDED FOR INFORMATION AND COORDINATION PURPOSES ONLY.

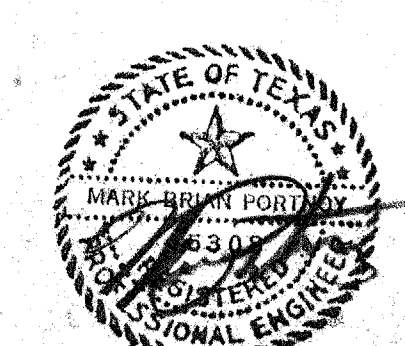

# ACC ADDISON ACT

OWNER	LANDSCAPE	STRUCTURAL	HISTORIAN	Issue	Category	Subcategory	Sheet
Town of Addison	The Williams Group 317-776-417	Elmer Turner 214-891-8283	Alan Mason 214-691-782	ISSUE FOR BID 6-17-80	10	2	1
ARCHITECT	MEP	THEATRE CONSULTANT	MEP SYSTEMS	LIGHTING			
Cunningham Architects 2700 Fairmount Dallas, Texas 75201 214-855-5772	MEP Systems 214-754-4789	Theatre Projects 203-431-3949 214-855-5772	Panela Hall Wilson 214-823-8642	Panela Hall Wilson 214-823-8642			
INTERIORS	CIVIL	CHSS	GRAPHICS				
713-552-2000	Kurtz & Associates 214-680-3322		Notetimed Design 214-654-8178				

AVI  
D