




A 2 CIR 20A 2P&G RECEPTACLES
BACK BOX 6" x 4" x 4"

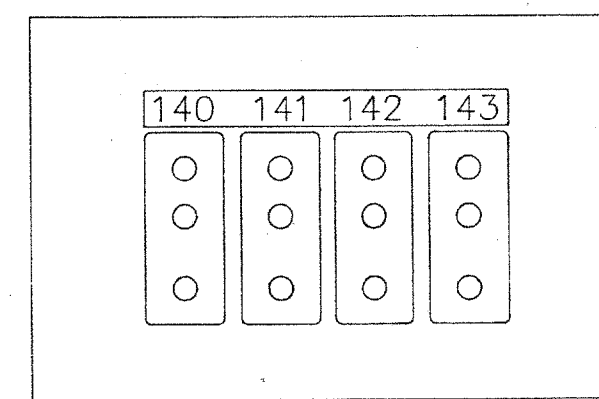


B 4 CIR 20A 2P&G RECEPTACLES
BACK BOX 6" x 4" x 4"

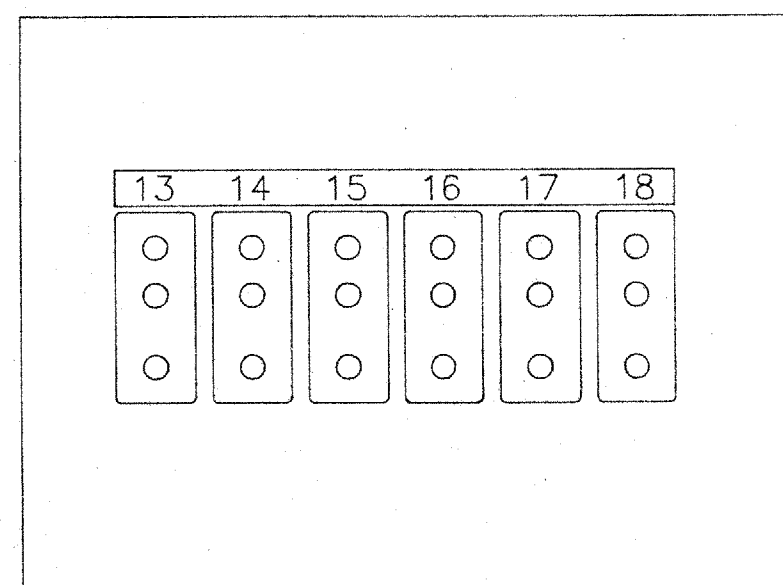


C 6 CIR 20A 2P&G RECEPTACLES
BACK BOX 8" x 6" x 4"

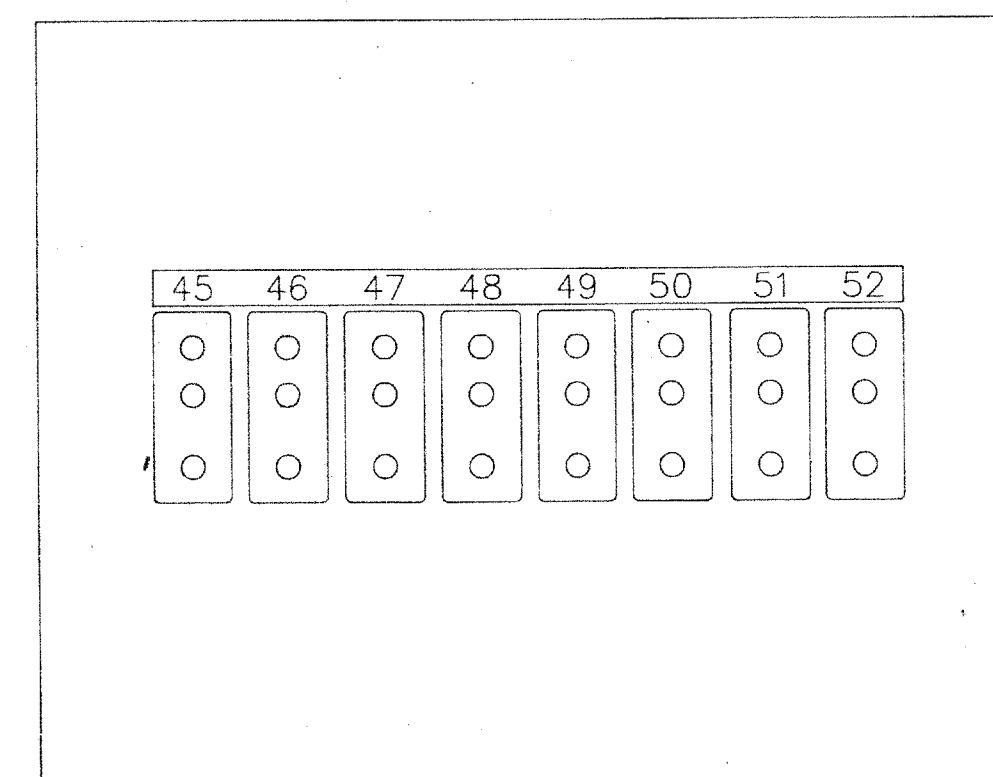


D 8 CIR 20A 2P&G RECEPTACLES
BACK BOX 8" x 10" x 4"

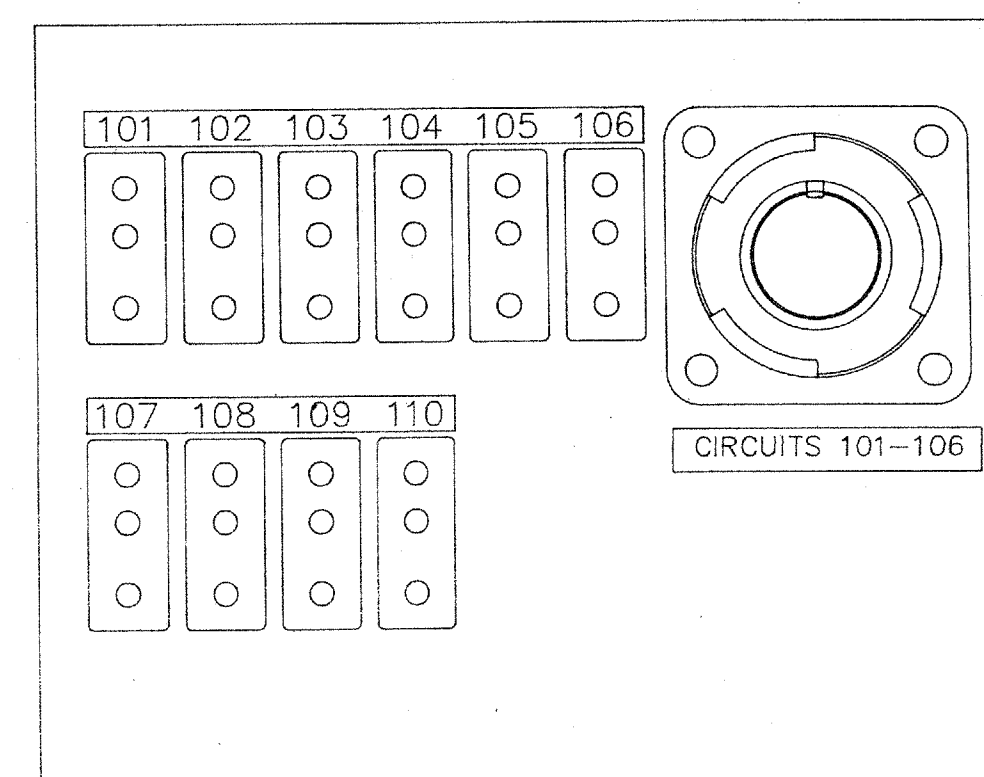


E 10 CIR 20A 2P&G RECEPT W/6 CIR VEAM
BACK BOX 10" x 8" x 4"

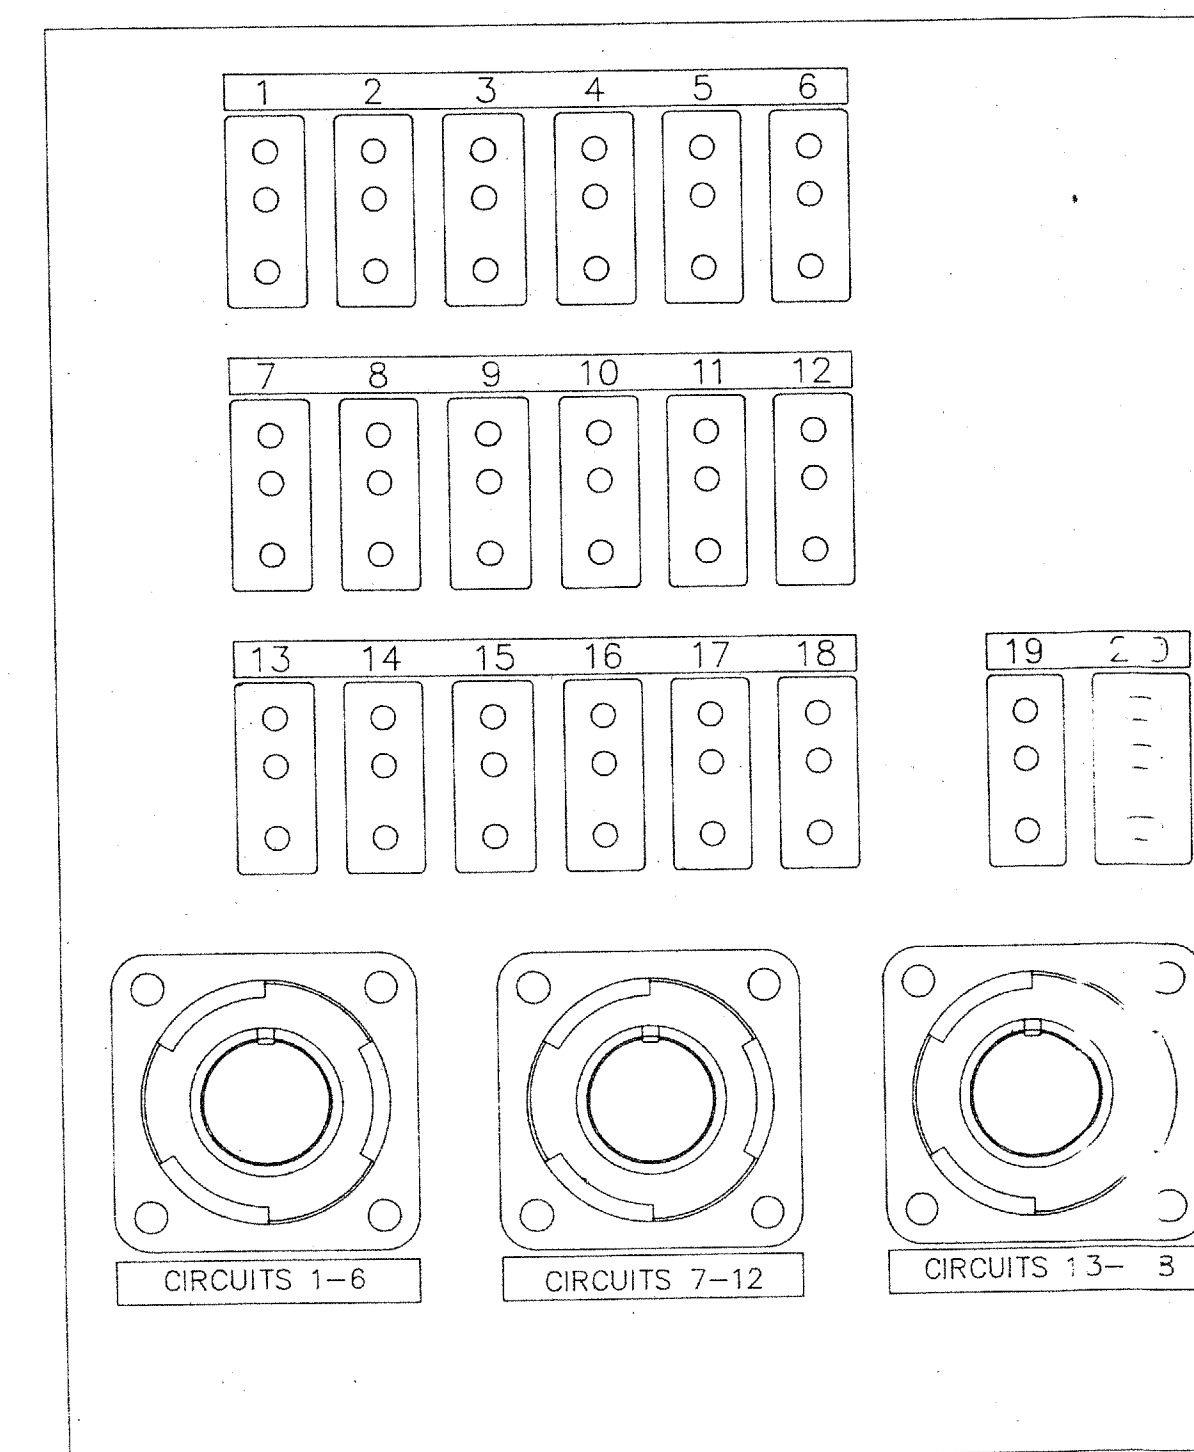


F 20 CIR 20A 2P&G RECEPT W/3 6 CIR VEAM
BACK BOX 12" x 15" x 4"

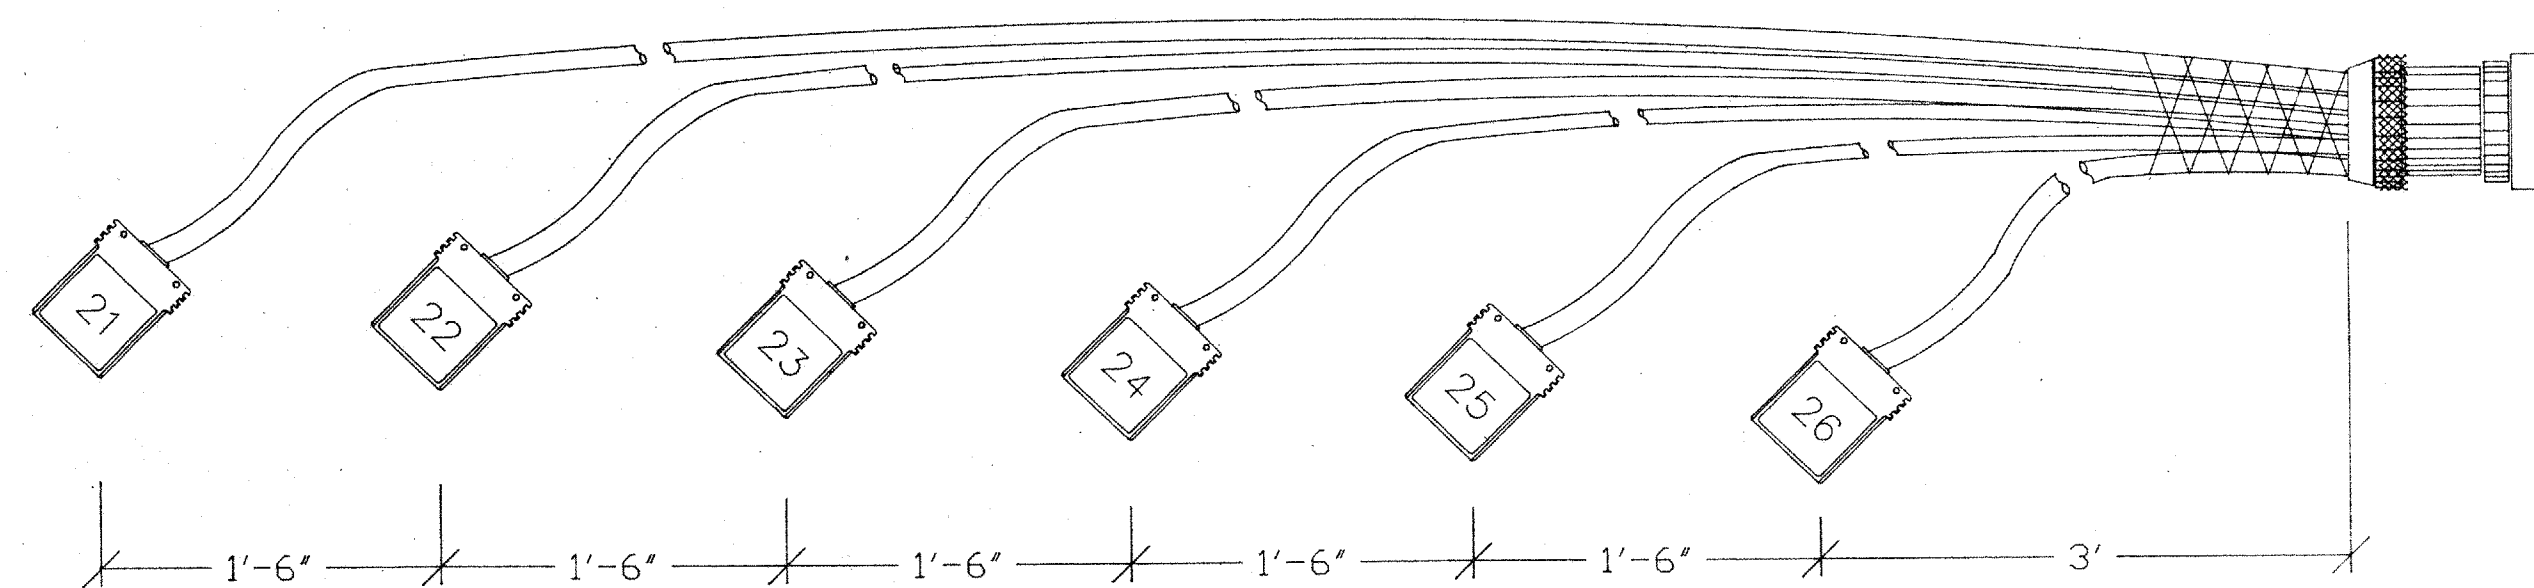


G 6 CIRCUIT 2P&G MULTICABLE BREAKOUT

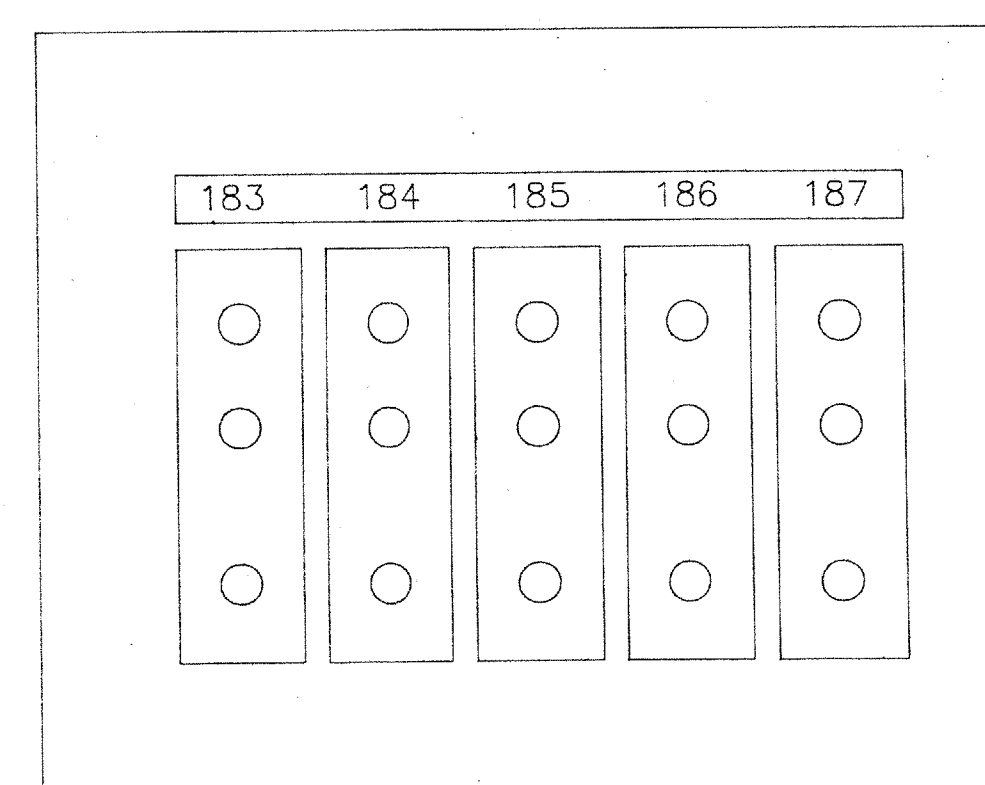

J 5 CIR 50A 2P&G RECEPTACLES
BACK BOX 8" x 10" x 4"

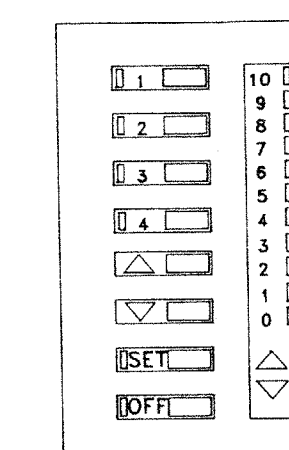

K ARCHITECTURAL LTG. CTRL. LOCAL
BACK BOX 1 GANG

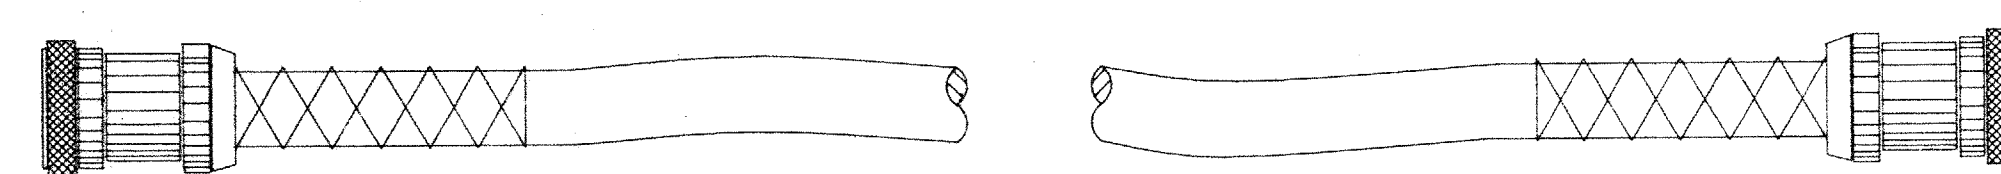

H 6 CIRCUIT 2P&G MULTICABLE EXTENSION W/6 CIR VEAM
REFER TO SCHEDULE FOR LENGTHS

NOTE:
THEATRE WORK (SOUND, VIDEO AND
INTERCOMMUNICATIONS WORK, TERMINATION OF
THEATRE LIGHTING AND INSTRUMENTS, THEATRE
DIMMER WORK, STAGE RIGGING, STAGE
DRAPERIES) IS NOT PART OF THIS CONTRACT.
IT IS INCLUDED FOR INFORMATION AND
COORDINATION PURPOSES ONLY.

THEATRICAL LIGHTING DETAILS