


A INTERCOM RECEPTACLE
BACK BOX 2 GANG


B SPEAKER RECEPT.
BACK BOX 1 GANG

C SPEAKER RECEPT.
BACK BOX 2 GANG

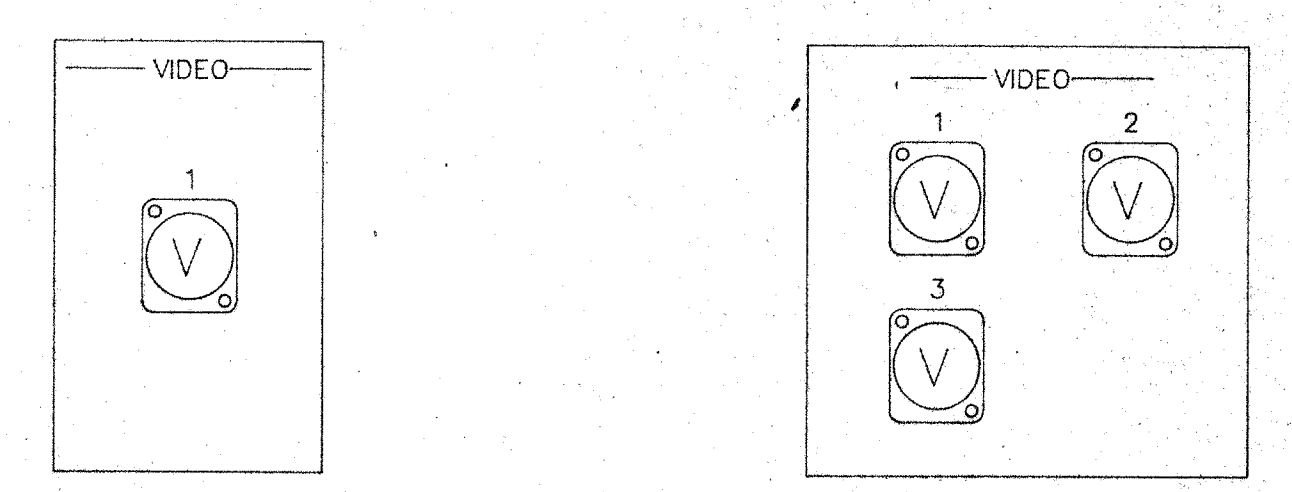


D VIDEO RECEPT.
BACK BOX 1 GANG

E VIDEO RECEPT.
BACK BOX 2 GANG

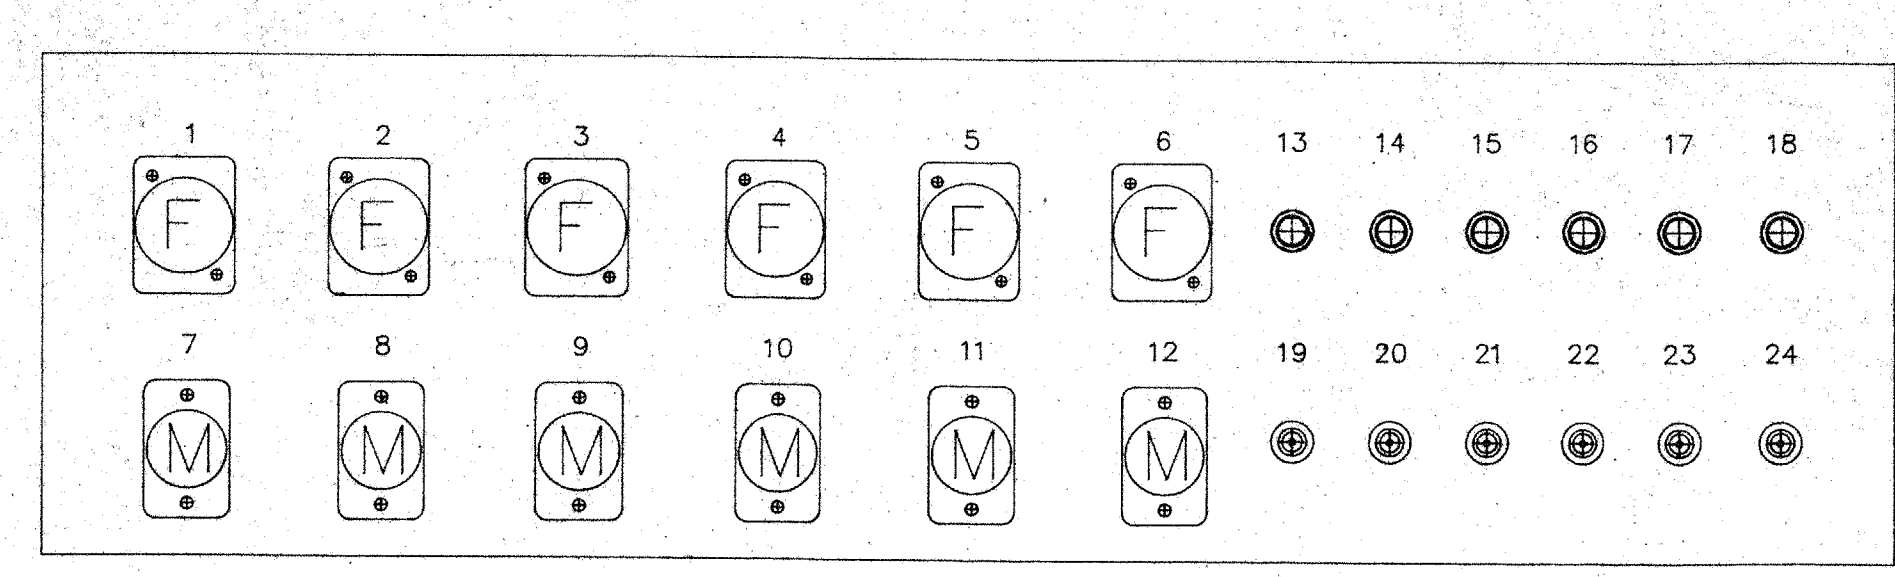


LOCAL TIE BAY
19" RACK X 3 RACK UNITS

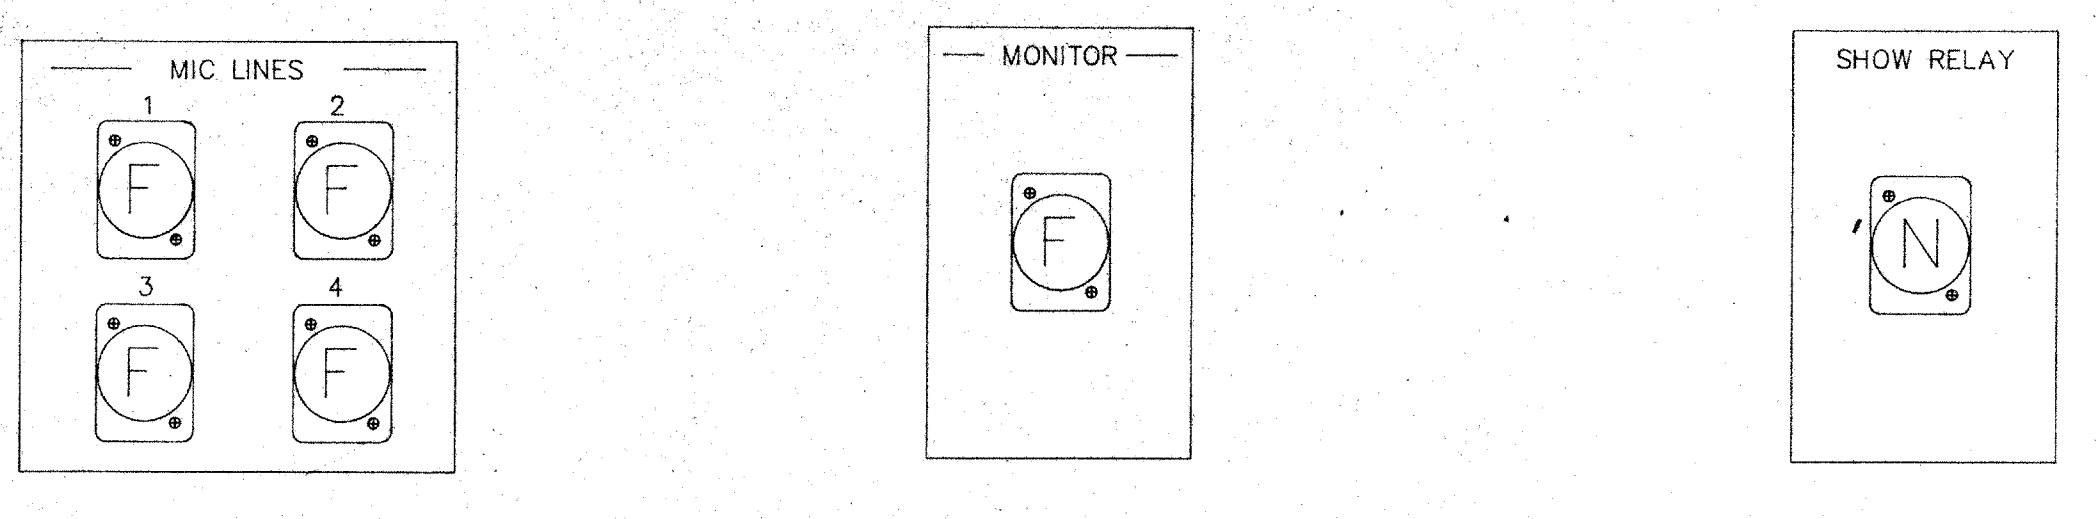

F MIC RECEPT.
BACK BOX 2 GANG

G SHOW RELAY MIC.
BACK BOX 1 GANG

H SHOW RELAY SPEAKER
BACK BOX 1 GANG

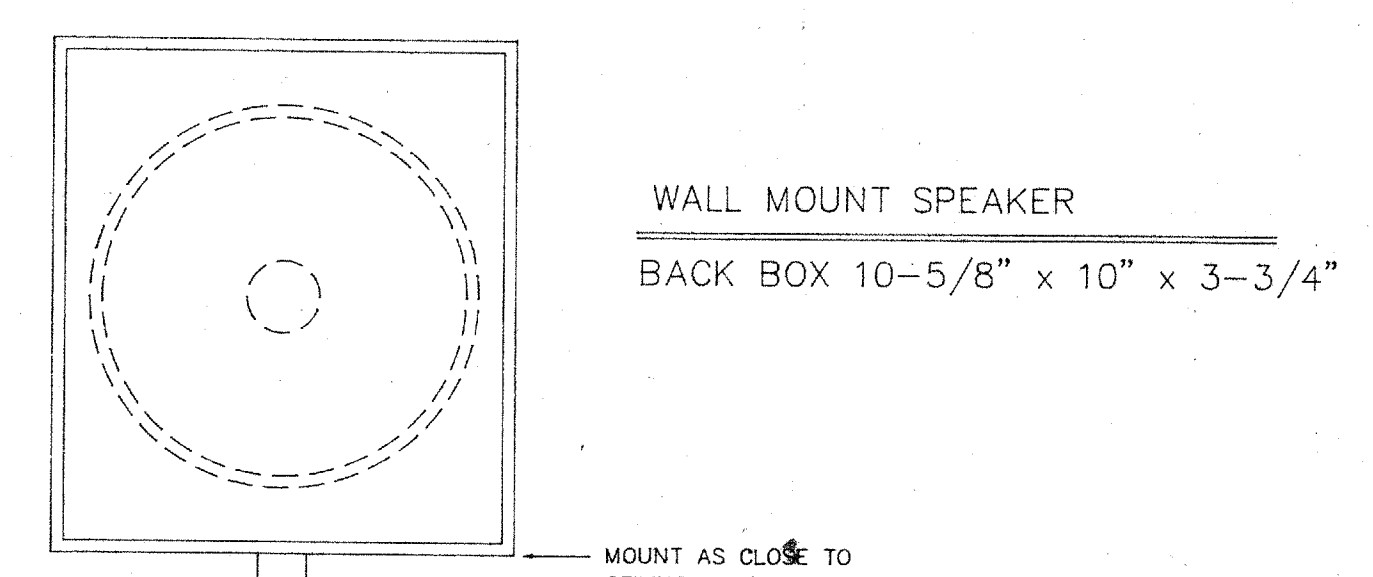


WALL MOUNT SPEAKER
BACK BOX 10-5/8" x 10" x 3-3/4"


MOUNT AS CLOSE TO CEILING AS POSSIBLE

58" AFF


J PAGE SPEAKER WITH VOLUME CONTROL
BACK BOX 1 GANG
SCALE: 1:4

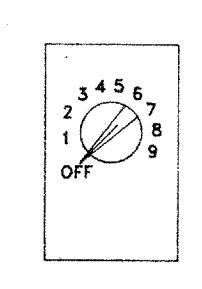


K PAGE VOLUME CONTROL
BACK BOX 1 GANG
SCALE: 1:4

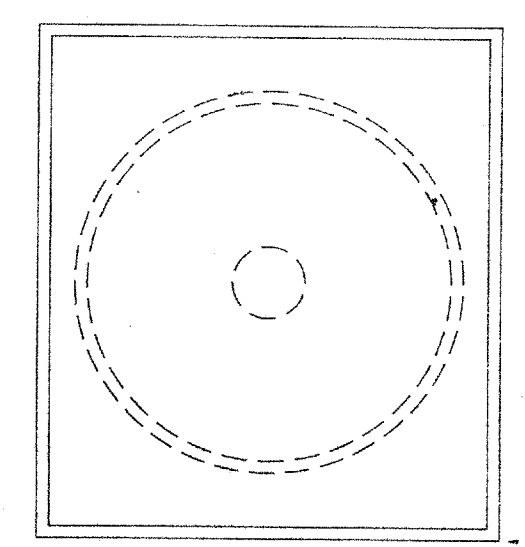


L PAGE SPEAKER
BACK BOX 10-5/8" x 10" x 3-3/4"
SCALE: 1:4

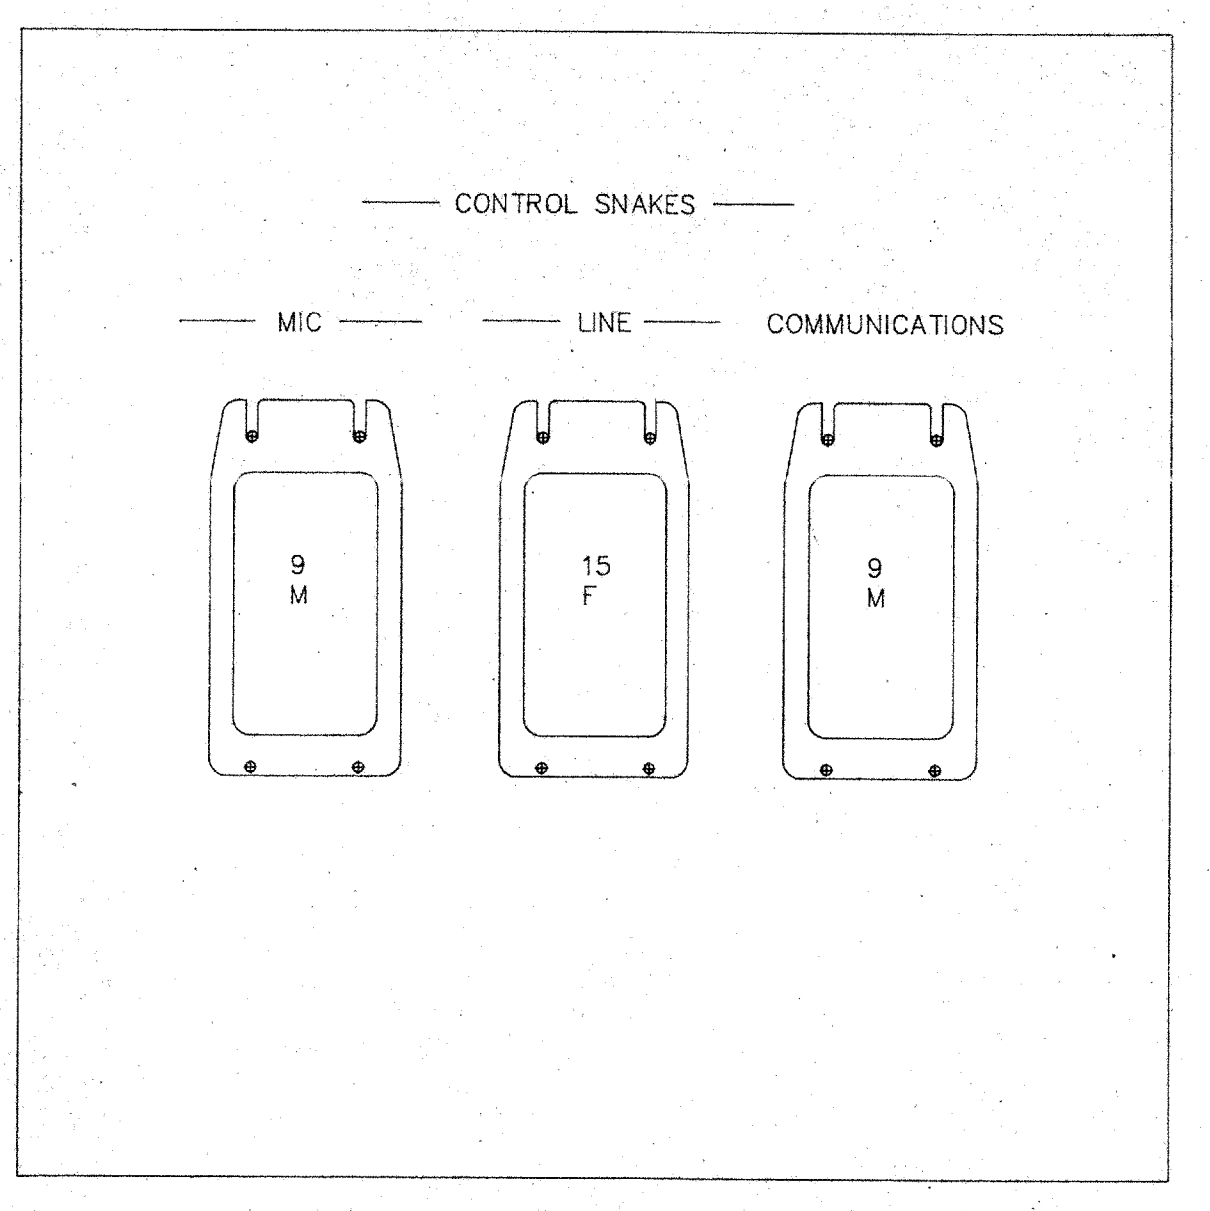


M CONTROL SNAKES
12" x 12" x 6"

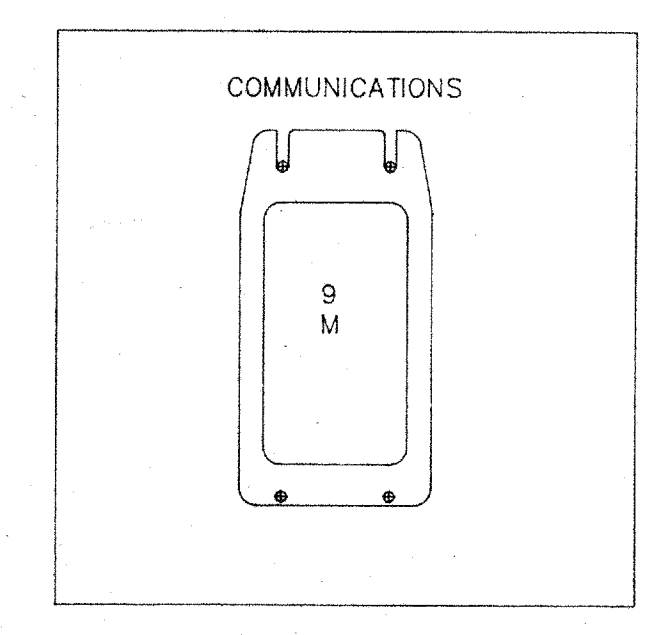


P STAGE MANAGER STATION
BACK BOX 6" x 6" x 4"

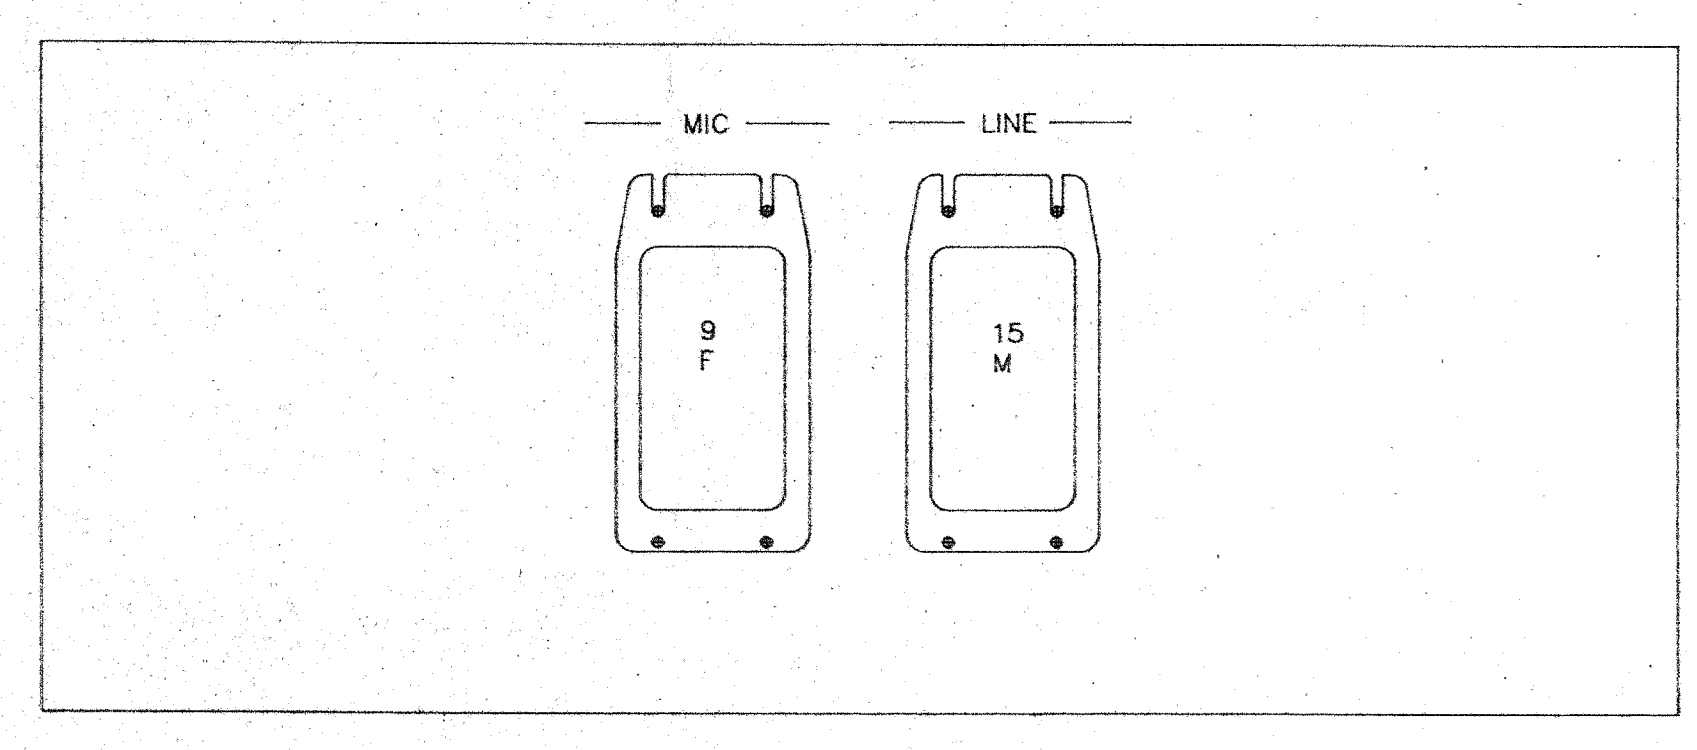


CONTROL BOOTH TIE BAY
19" RACK x 4 RACK SPACES

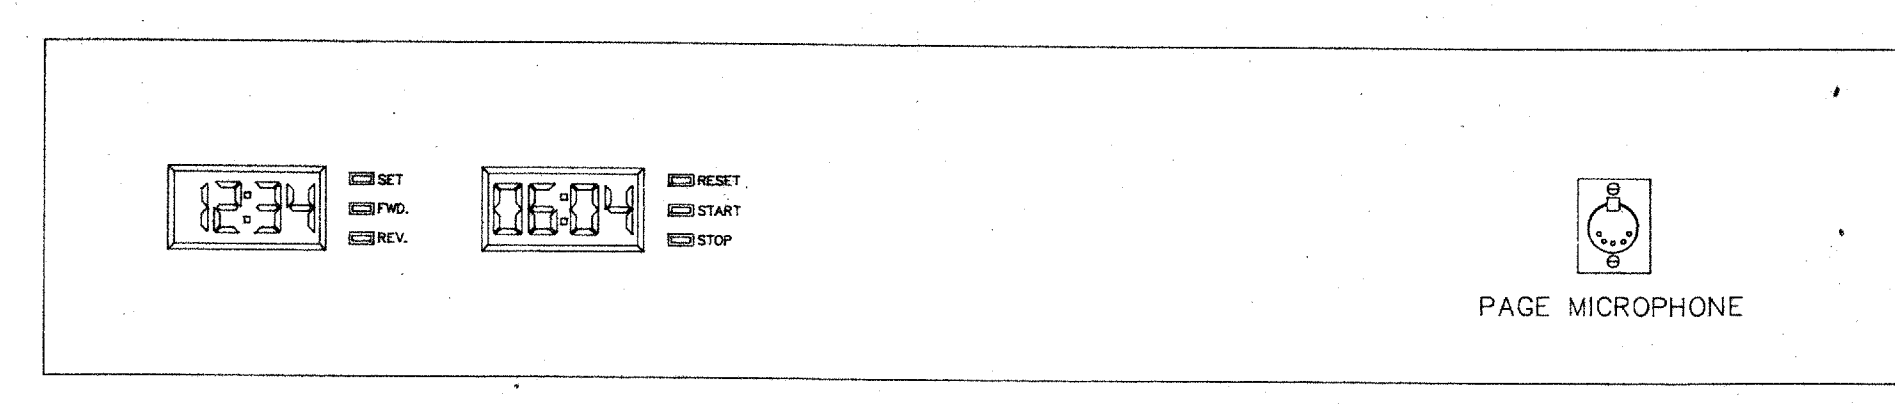

PAGING/CLOCK MODULE
19" RACK X 2 RACK UNITS






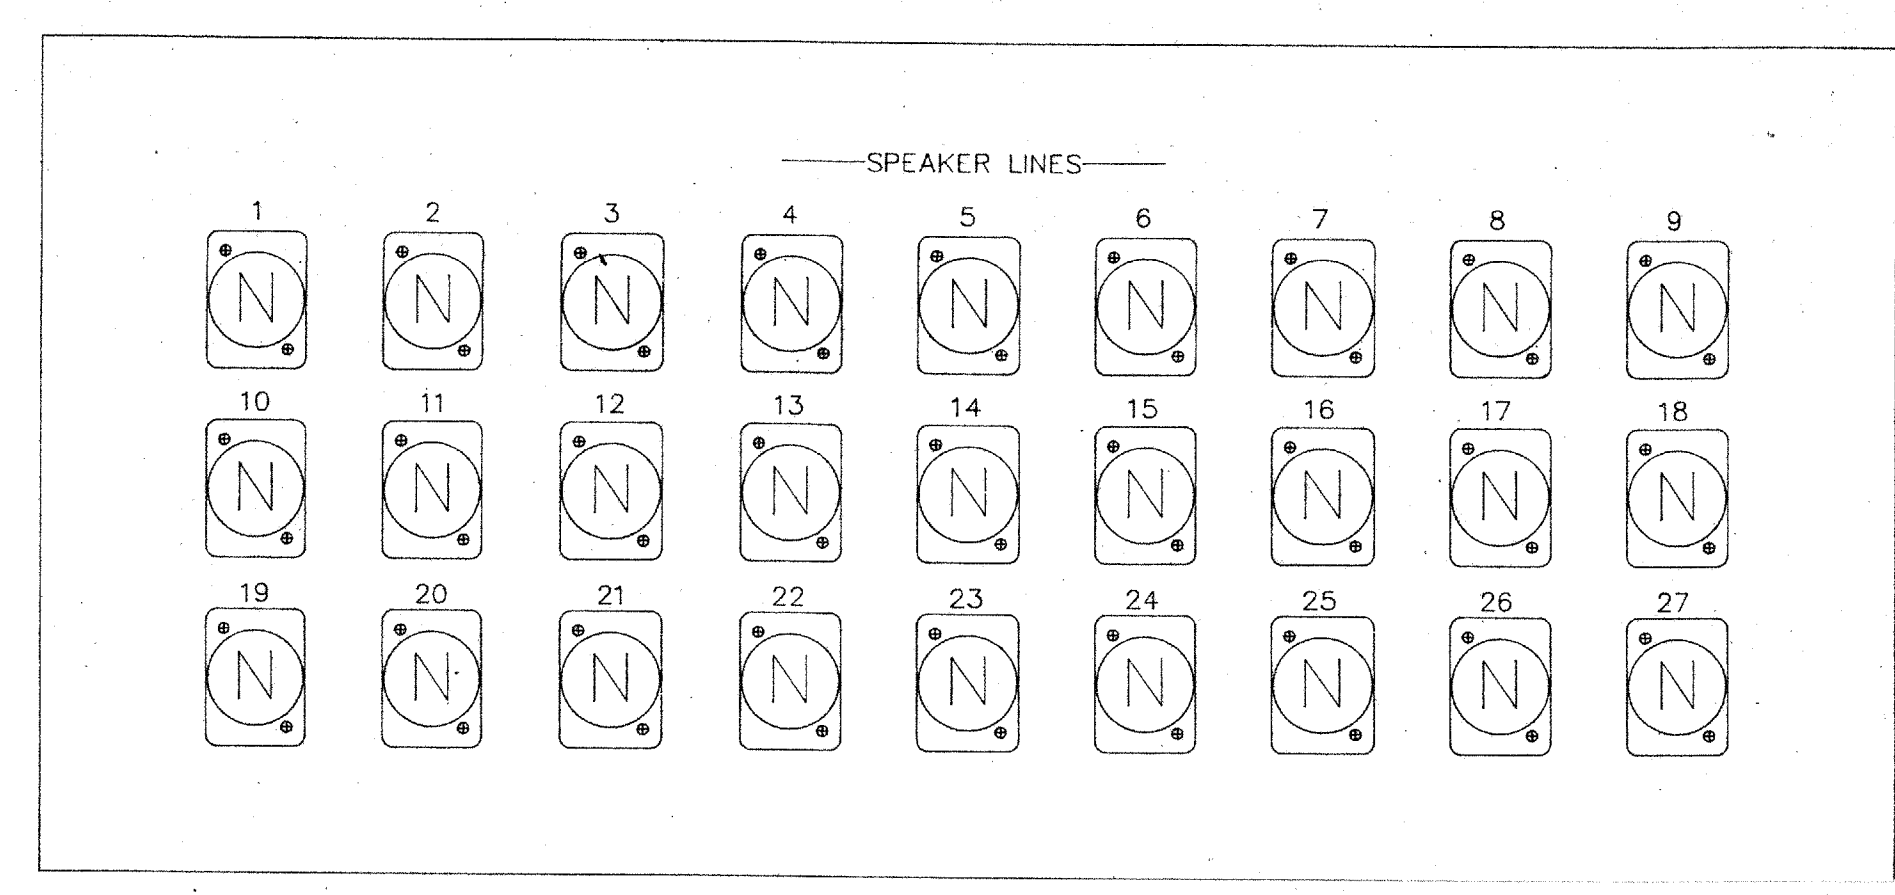


SPEAKER SECTION - 19" RACK X 5 RACK UNITS

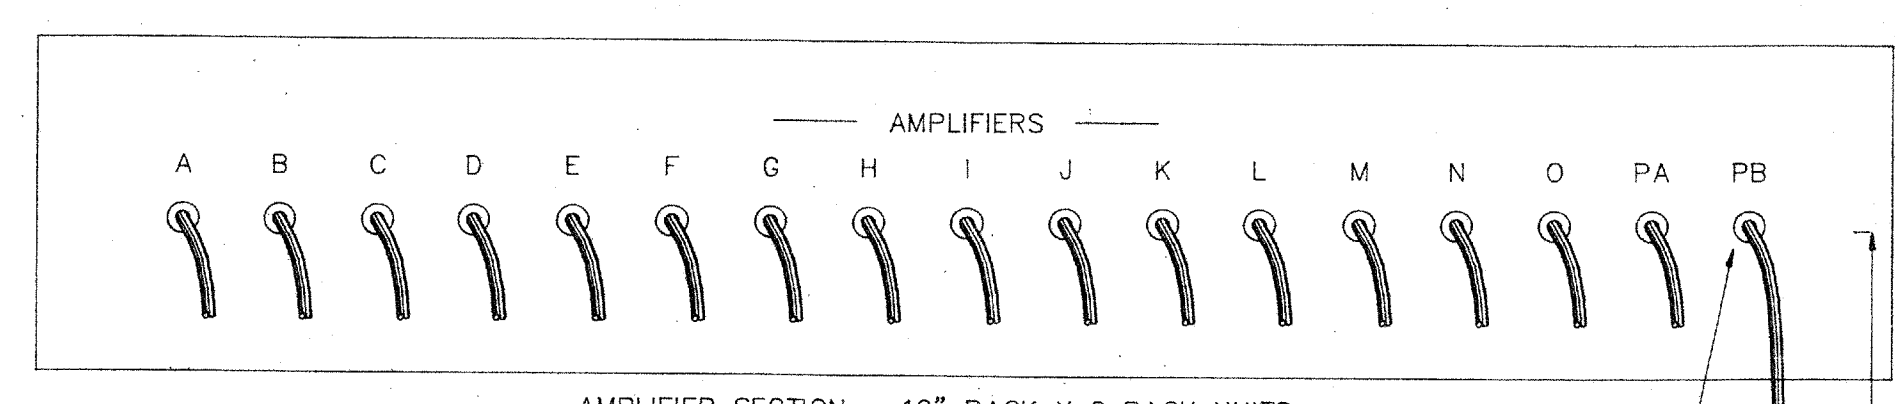


AMPLIFIER SECTION - 19" RACK X 2 RACK UNITS

SPEAKER PATCHBAY

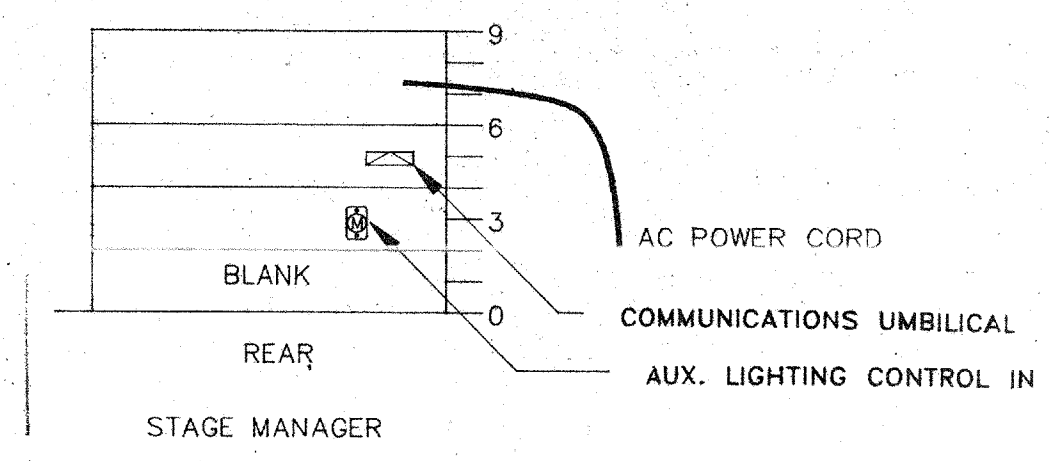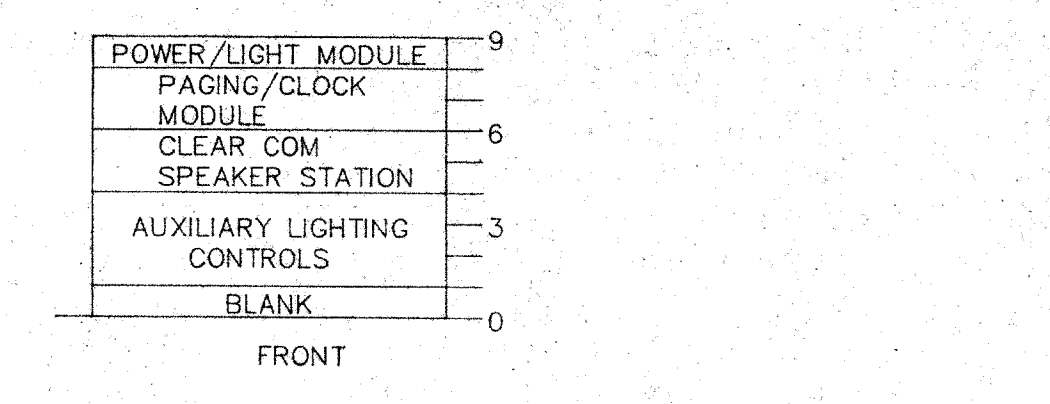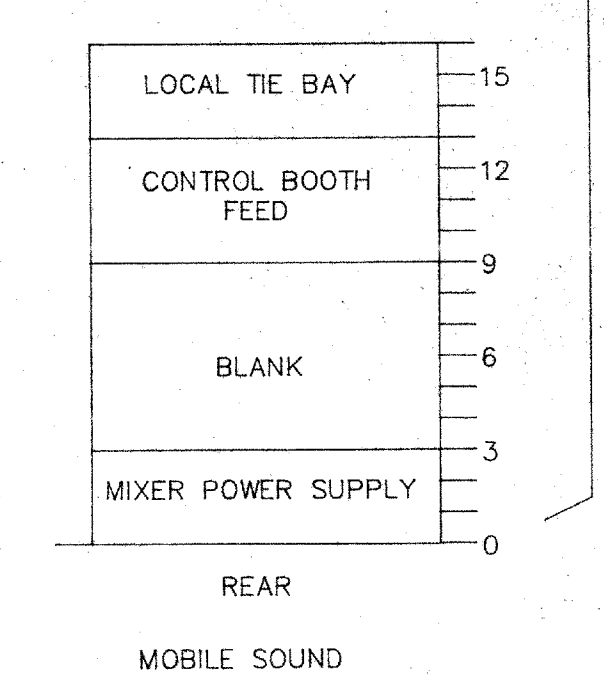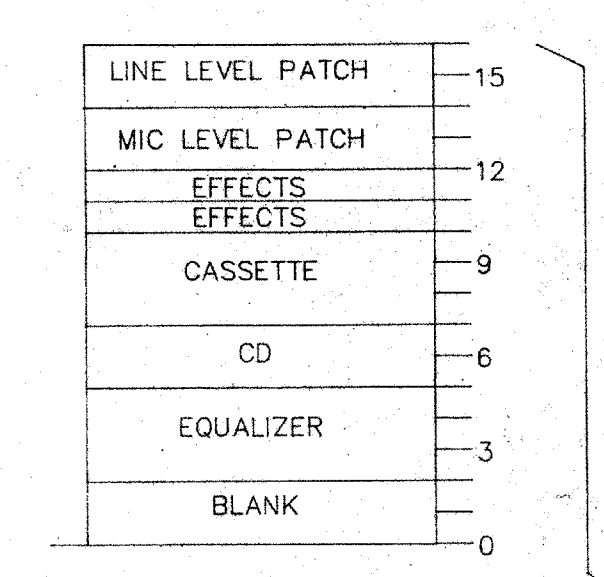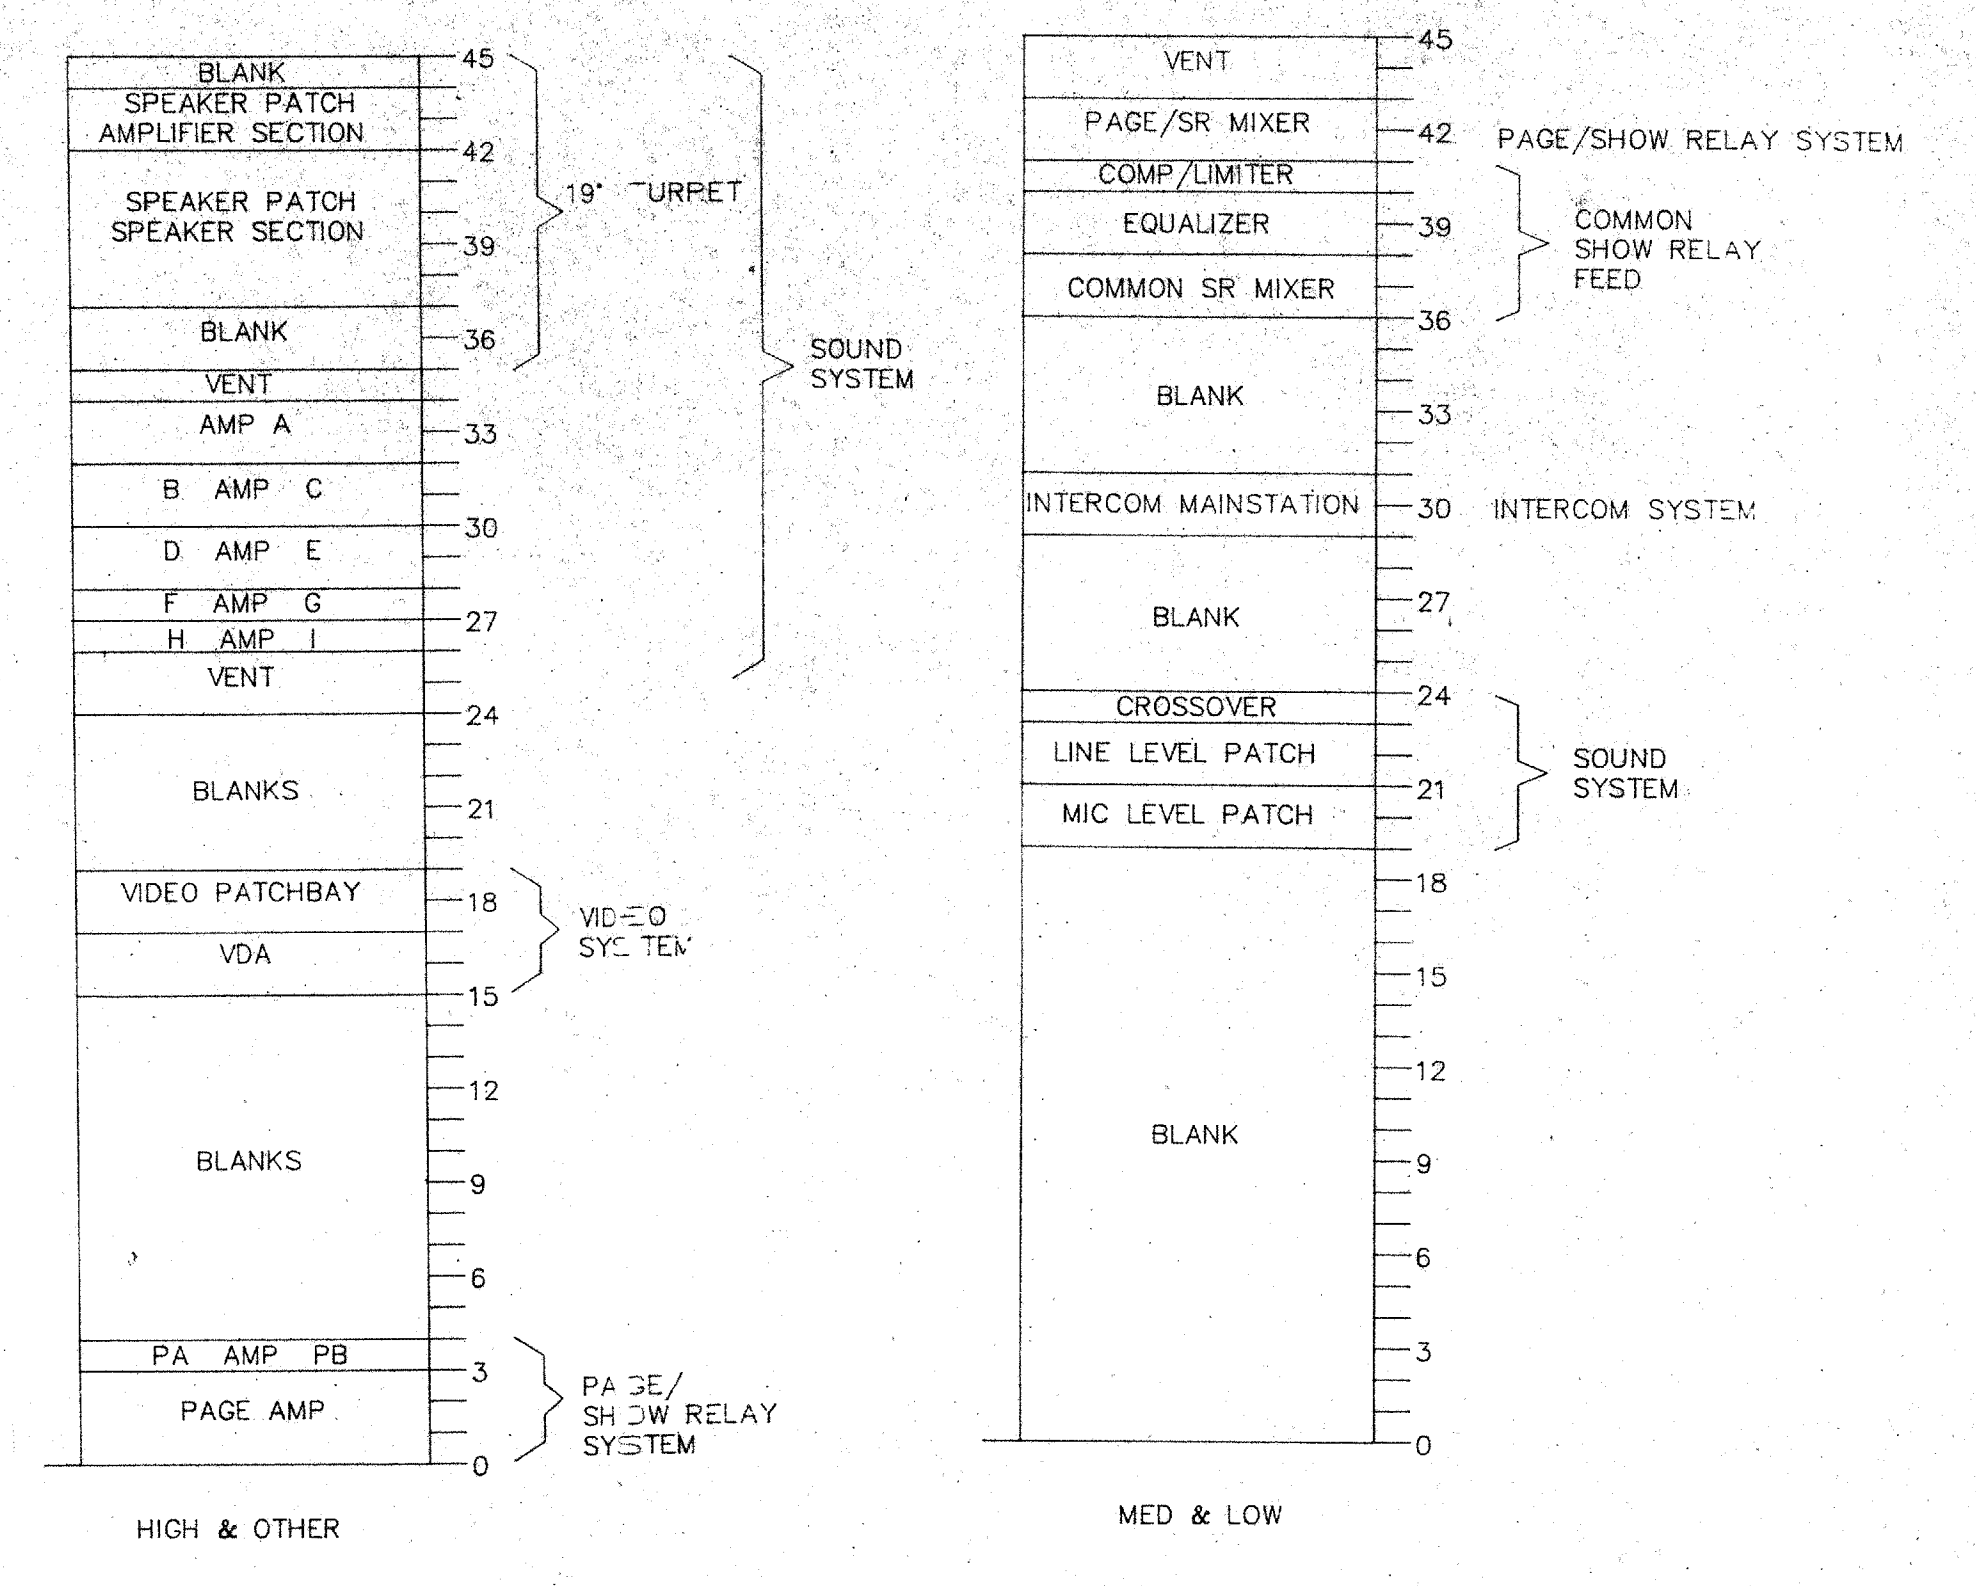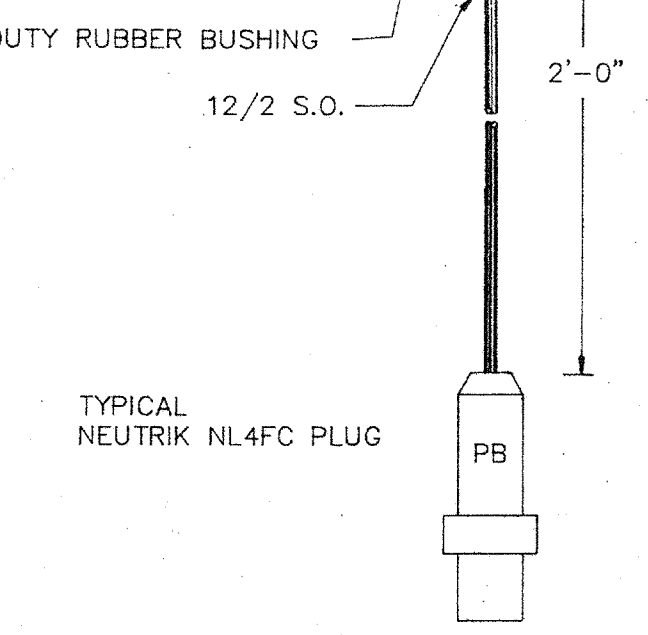

RACK ELEVATIONS

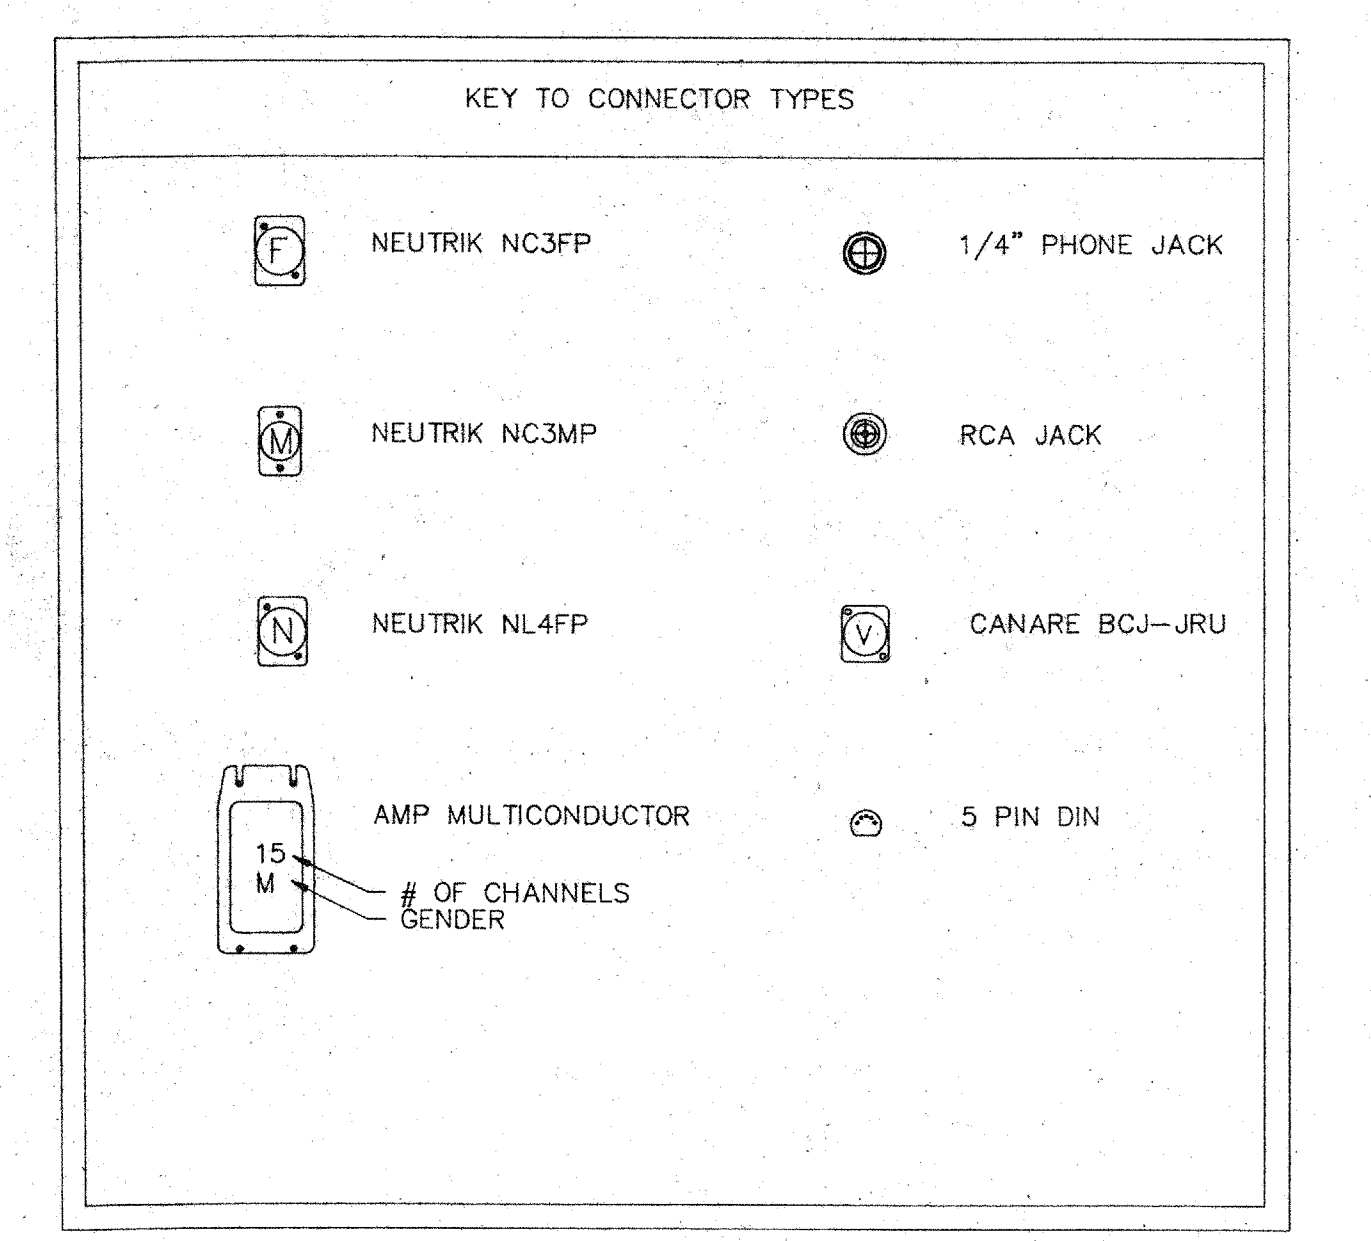

THEATRICAL SOUND DETAILS

FACEPLATE NOTES:

1. MATERIAL: 1/8" THICK LAMACOD.
2. FINISH: BLACK WITH WHITE FILL.
3. ENGRAVING TO BE 3/16" HIGH CHARACTERS WITH NON-YELLOWING WHITE FILL.
4. ALL CIRCUITS TO HAVE UNIQUE NUMBERS.

NOTE:
THEATRE WORK (SOUND, VIDEO AND INTERCOMMUNICATIONS WORK, TERMINATION OF THEATRE LIGHTING AND INSTRUMENTS, THEATRE DIMMER WORK, STAGE RIGGING, STAGE DRAPERIES) IS NOT PART OF THIS CONTRACT. IT IS INCLUDED FOR INFORMATION AND COORDINATION PURPOSES ONLY.

THIS SHEET IS NOT PART OF THIS CONTRACT.
INFORMATION IS PROVIDED FOR COORDINATION PURPOSES ONLY.