


A REH. ROOM EAST TRACK ELEVATION
SCALE: 1/4"=1'-0"

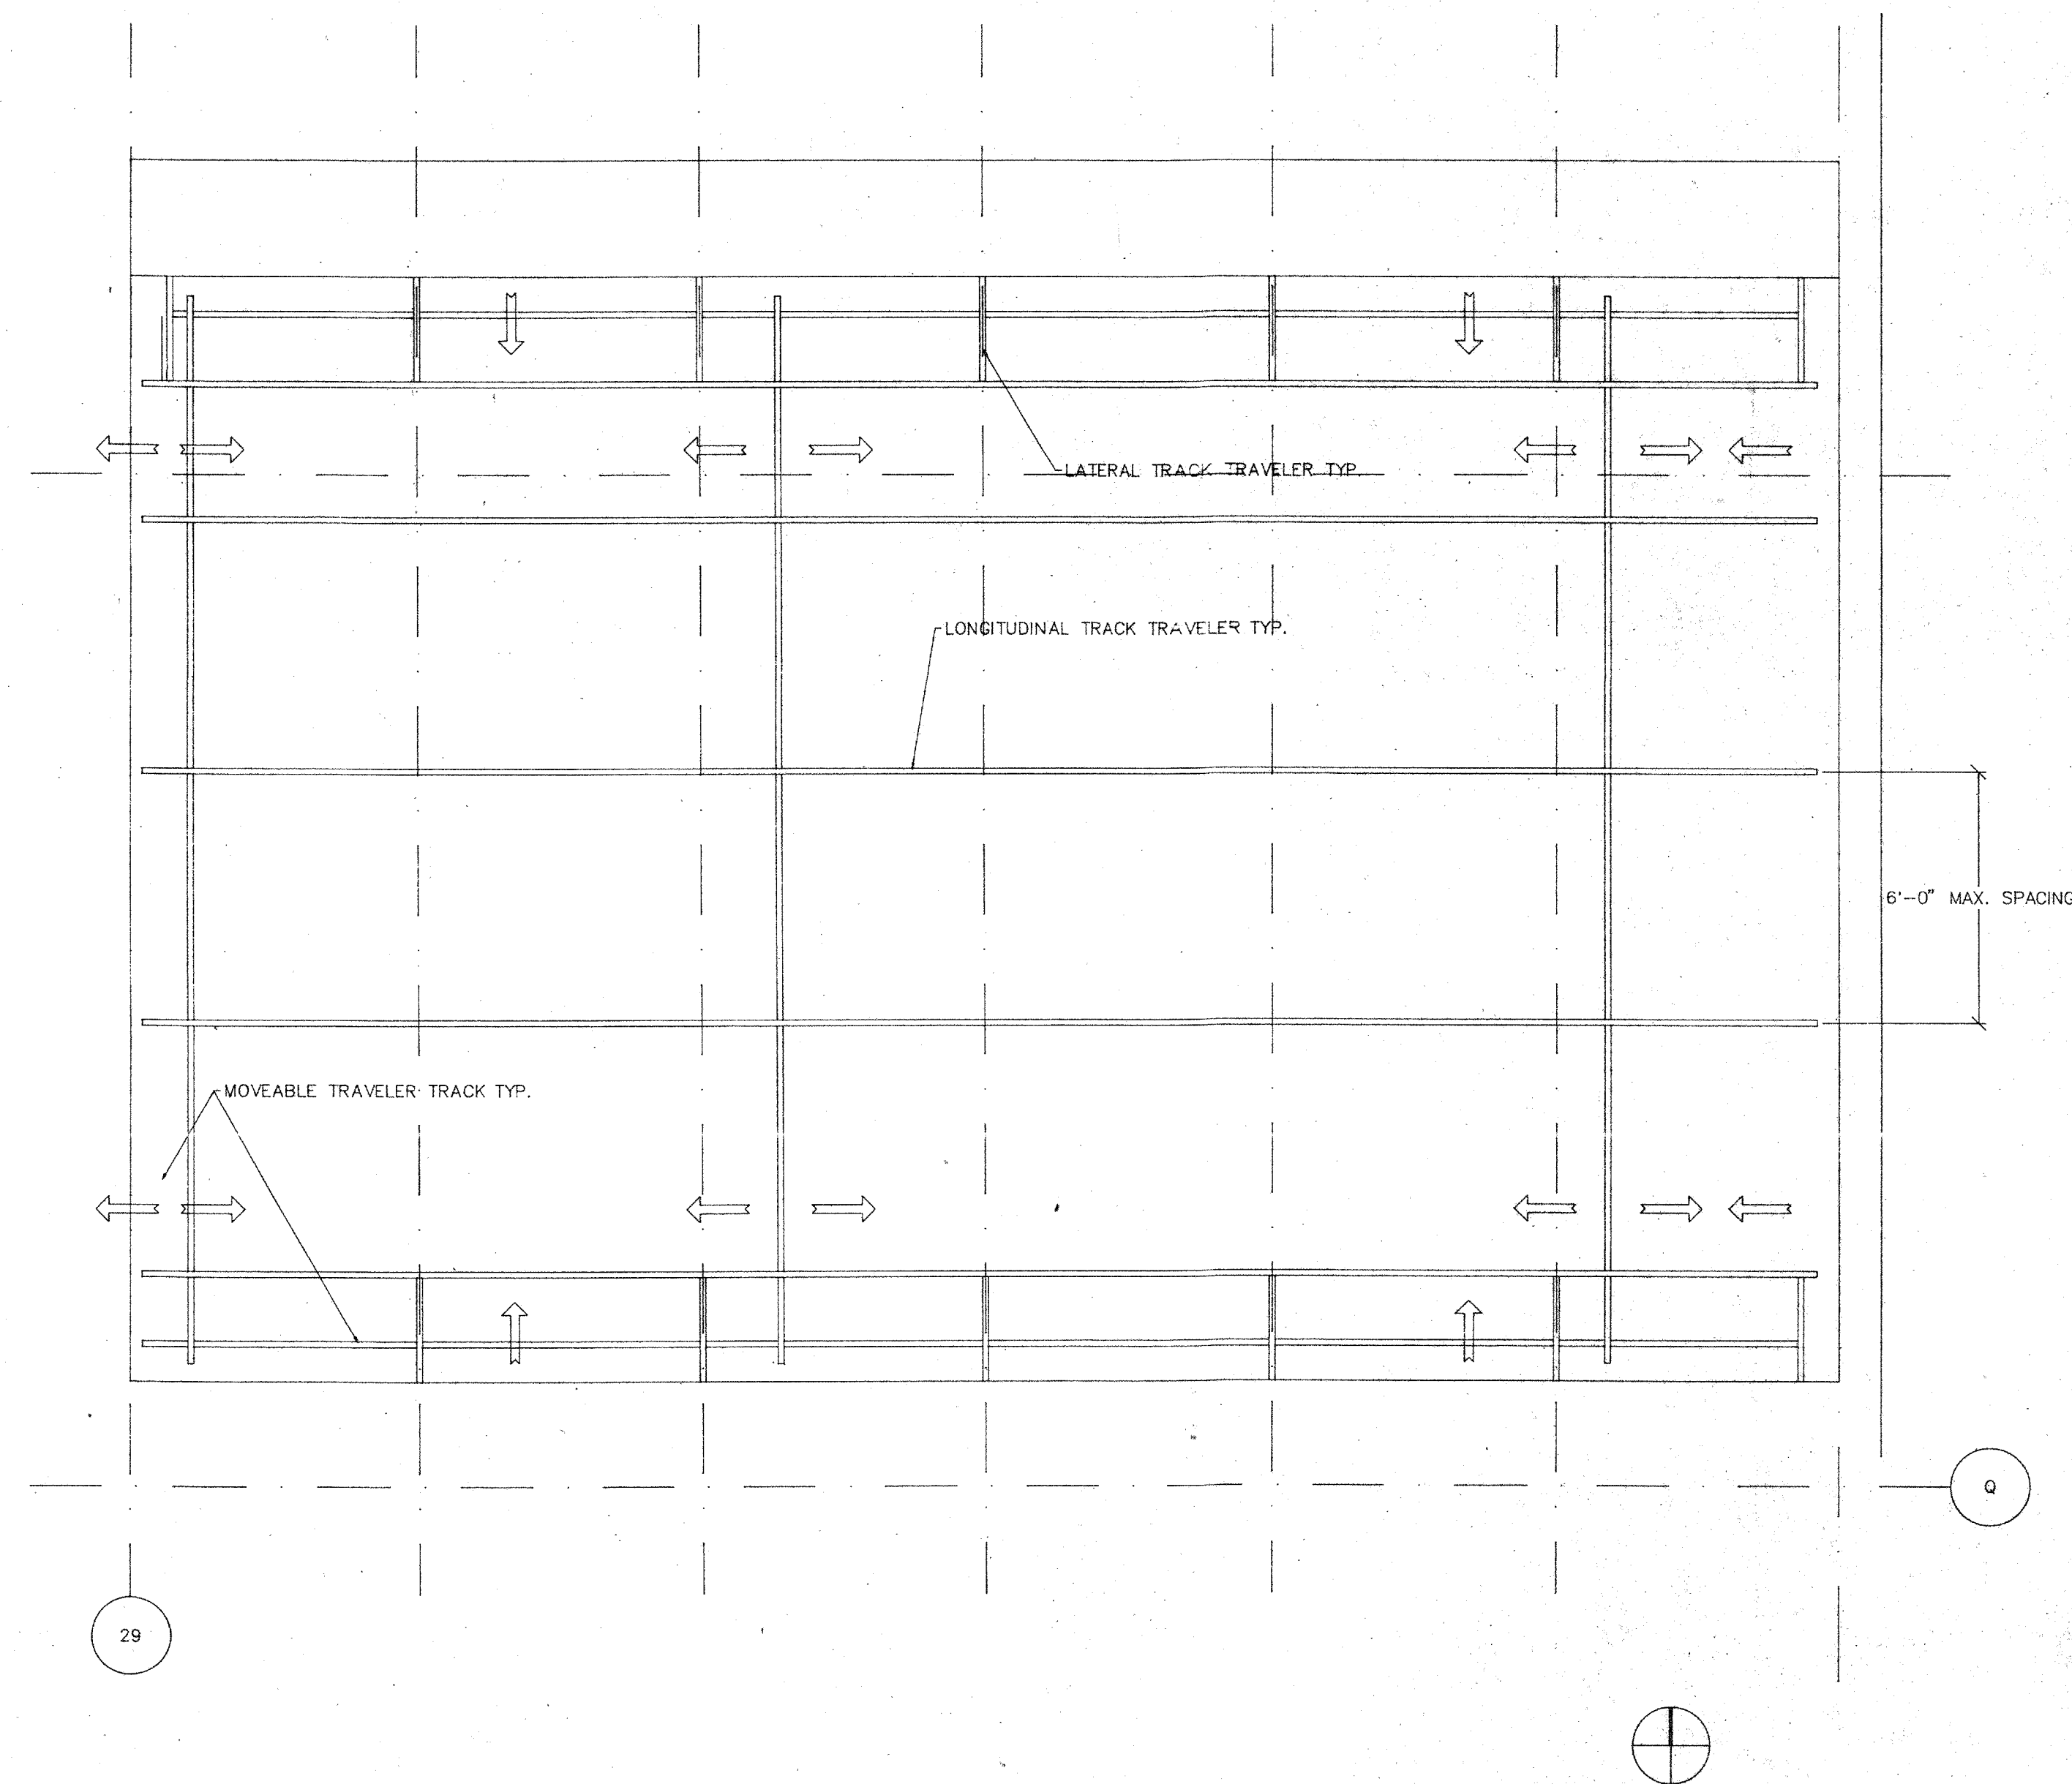

B REFLECTED CEILING PLAN SHOWING TRAVELLER TRACK
SCALE: 1/4"=1'-0"

NOTE:
THEATRE WORK (SOUND, VIDEO AND
INTERCOMMUNICATIONS WORK, TERMINATION OF
THEATRE LIGHTING AND INSTRUMENTS, THEATRE
DIMMER WORK, STAGE RIGGING, STAGE
DRAPERIES) IS NOT PART OF THIS CONTRACT.
IT IS INCLUDED FOR INFORMATION AND
COORDINATION PURPOSES ONLY.

THIS SHEET IS NOT PART OF THIS CONTRACT.
INFORMATION IS PROVIDED FOR COORDINATION PURPOSES ONLY.

THEATRICAL CURTAIN DETAILS