


C1 CURTAIN TRACK DETAILS
SCALE: 3/4"=1'-0"

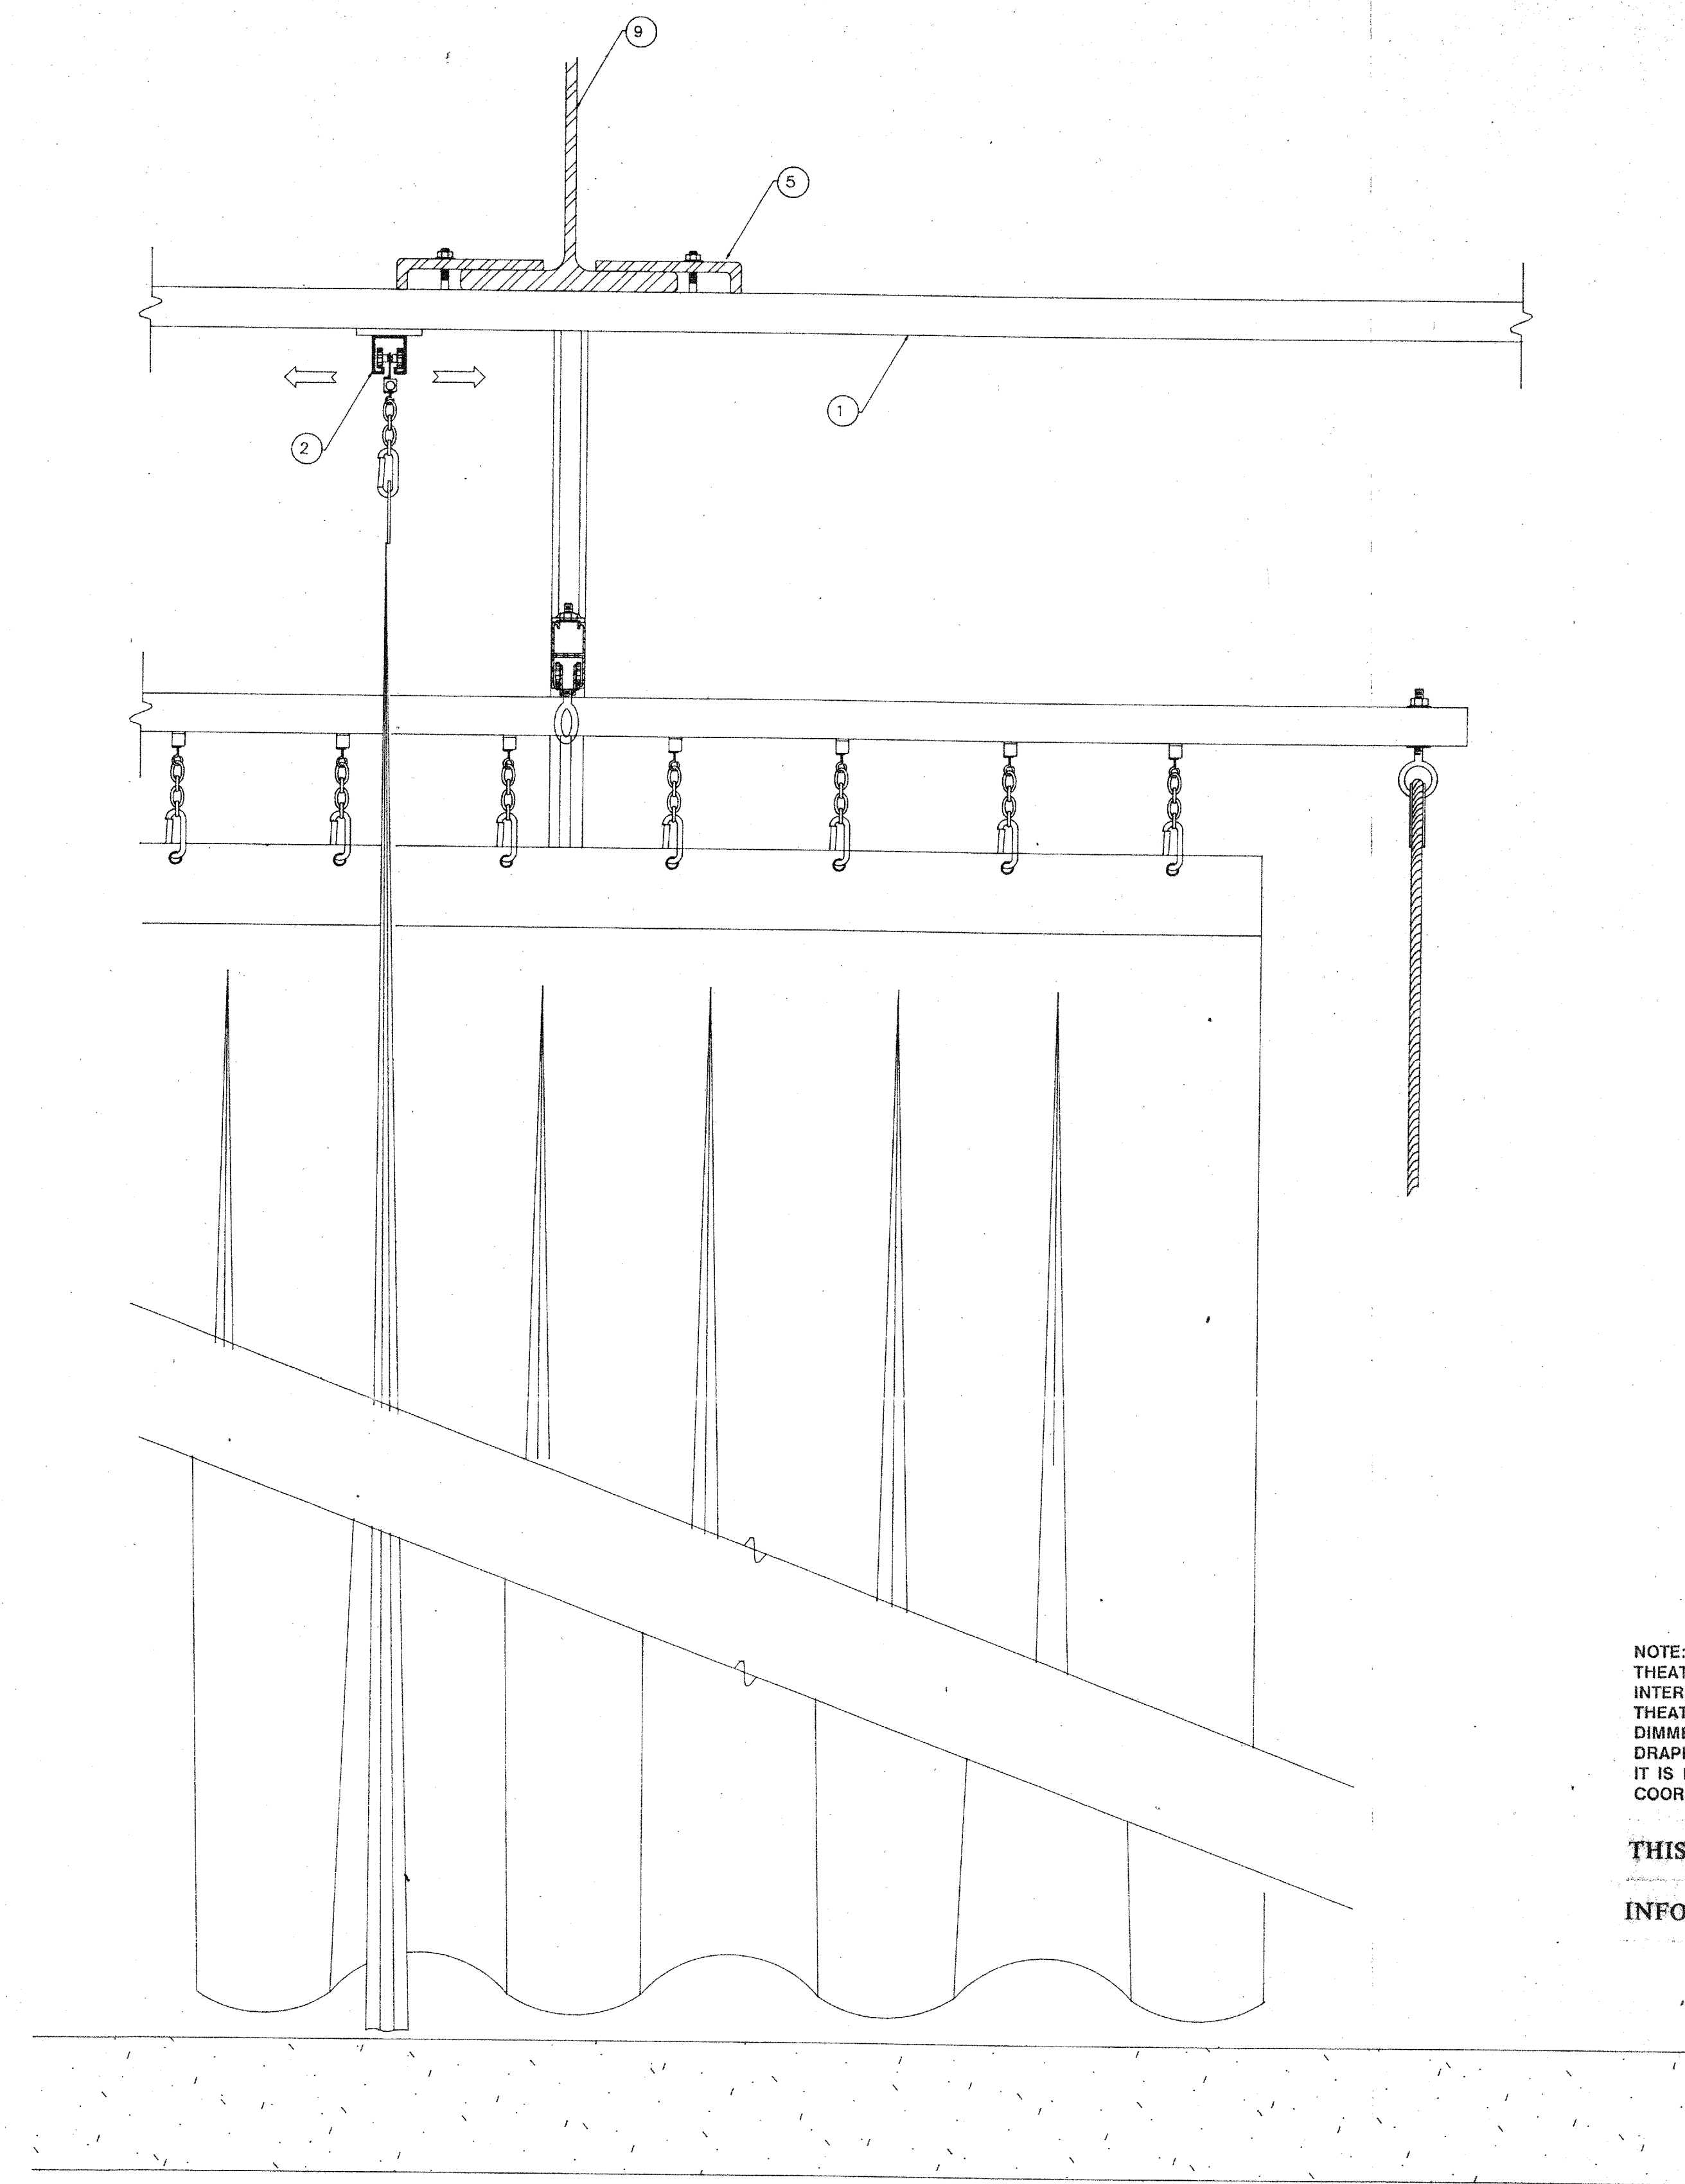

C2 CURTAIN TRACK DETAILS
SCALE: 3/4"=1'-0"

NOTE:
THEATRE WORK (SOUND, VIDEO AND
INTERCOMMUNICATIONS WORK, TERMINATION OF
THEATRE LIGHTING AND INSTRUMENTS, THEATRE
DIMMER WORK, STAGE RISING, STAGE
DRAPERIES) IS NOT PART OF THIS CONTRACT.
IT IS INCLUDED FOR INFORMATION AND
COORDINATION PURPOSES ONLY.

THIS SHEET IS NOT PART OF THIS CONTRACT.
INFORMATION IS PROVIDED FOR COORDINATION PURPOSES ONLY.

THEATRICAL CURTAIN DETAILS

- NOTES:
- 1 Unistrut P1000
 - 2 ADC 170 OR EQUIVALENT
 - 3 3/8" SHOULDERED EYEBOLT
 - 4 VELOUR CURTAIN
 - 5 STEEL BRACKET
 - 6 UNISTRUT P2546
 - 7 PULL ROPE (TO FLOOR)
 - 8 UNISTRUT P2458-18 KNEE BRACE
 - 9 ROOF STEEL