
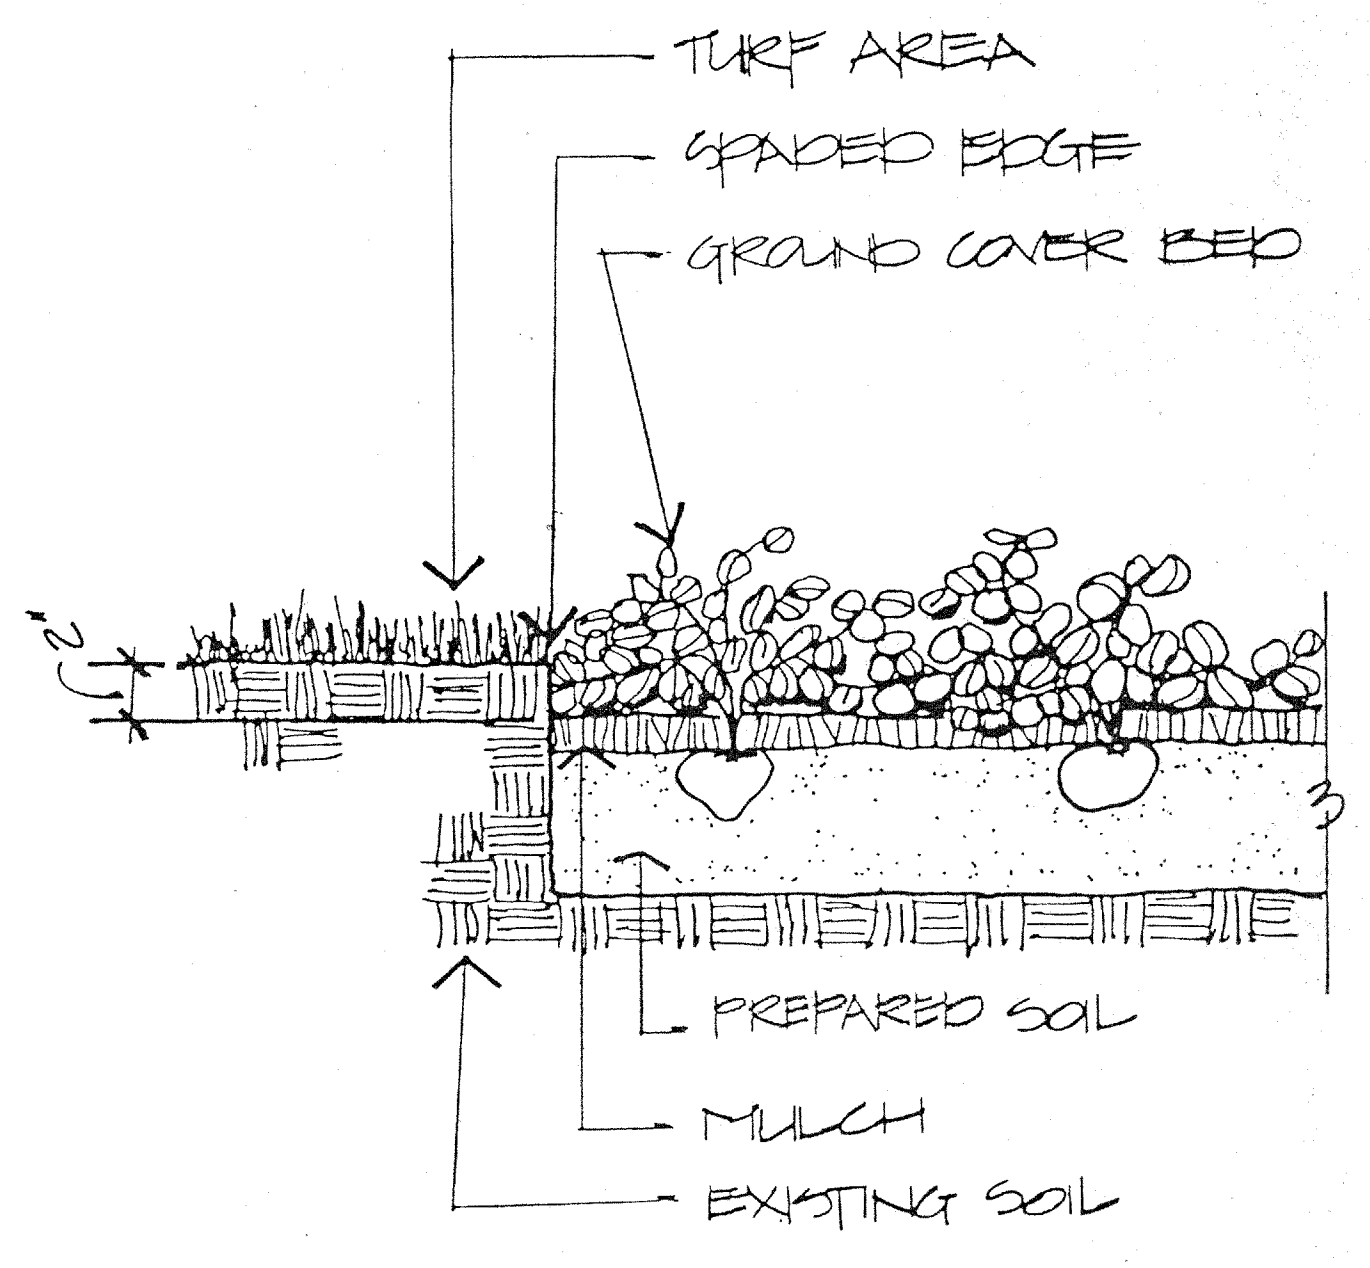
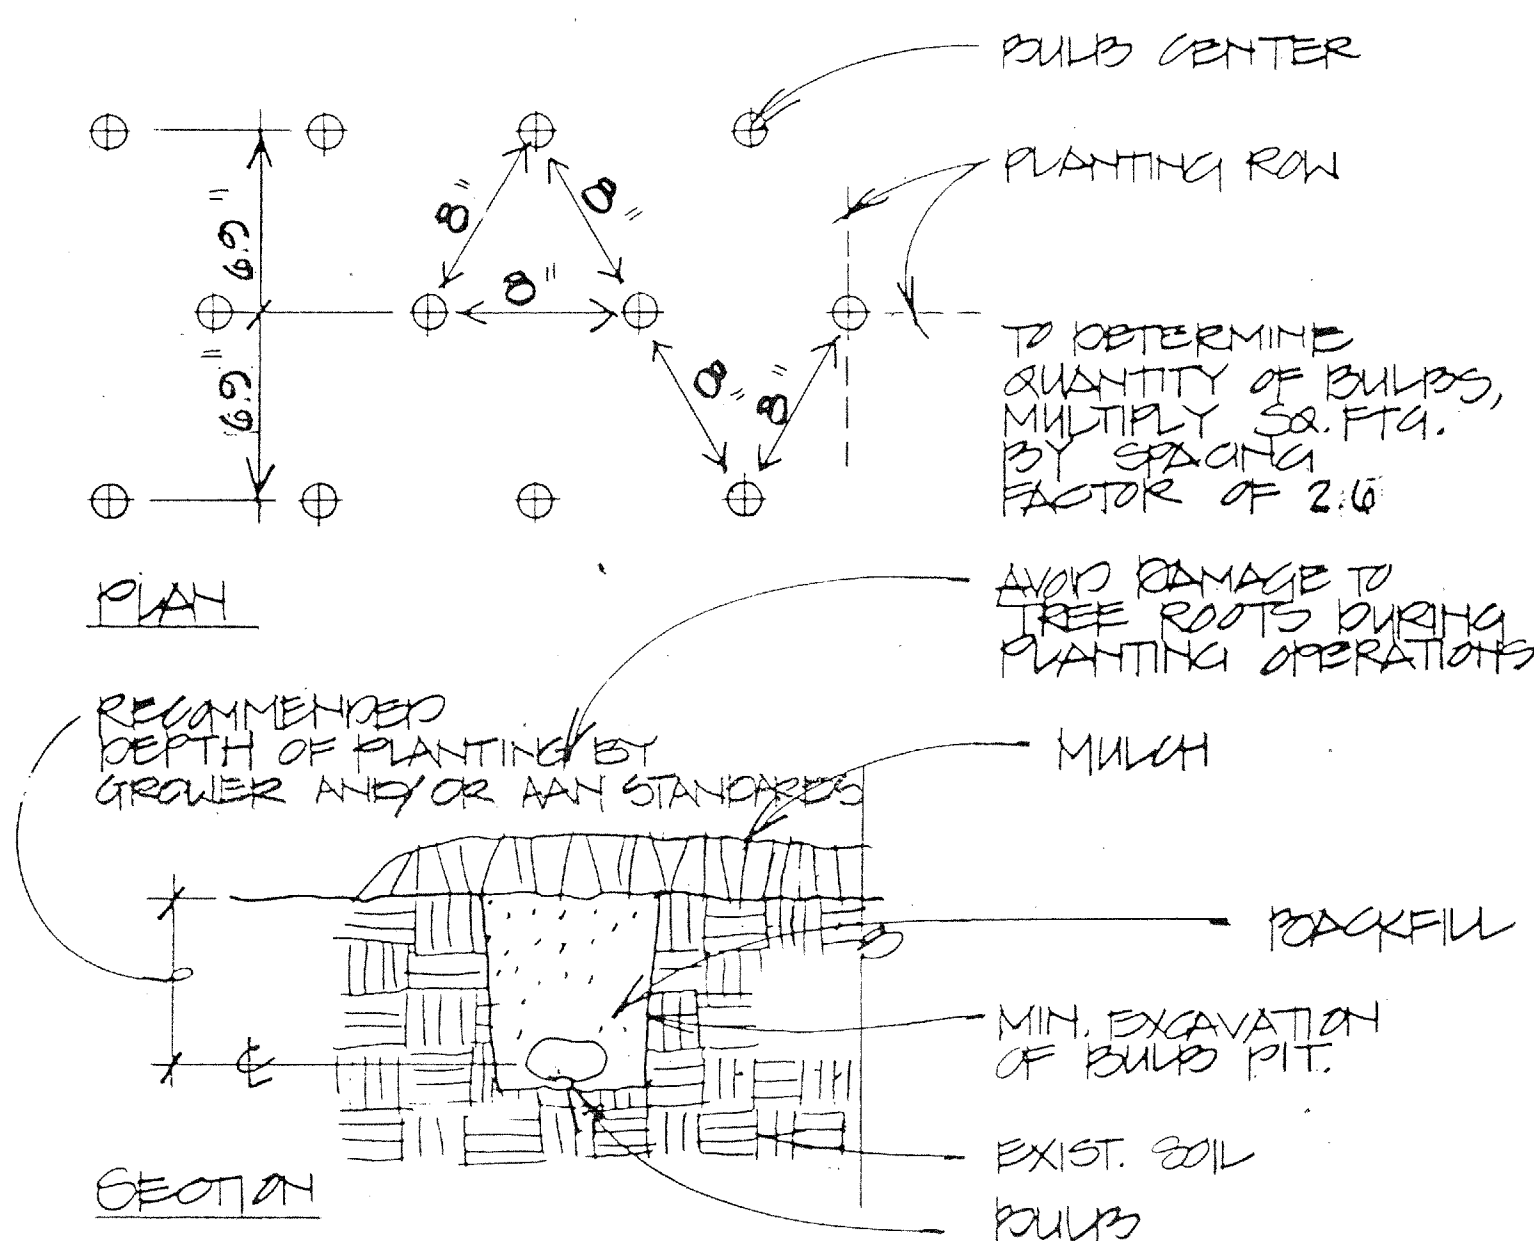
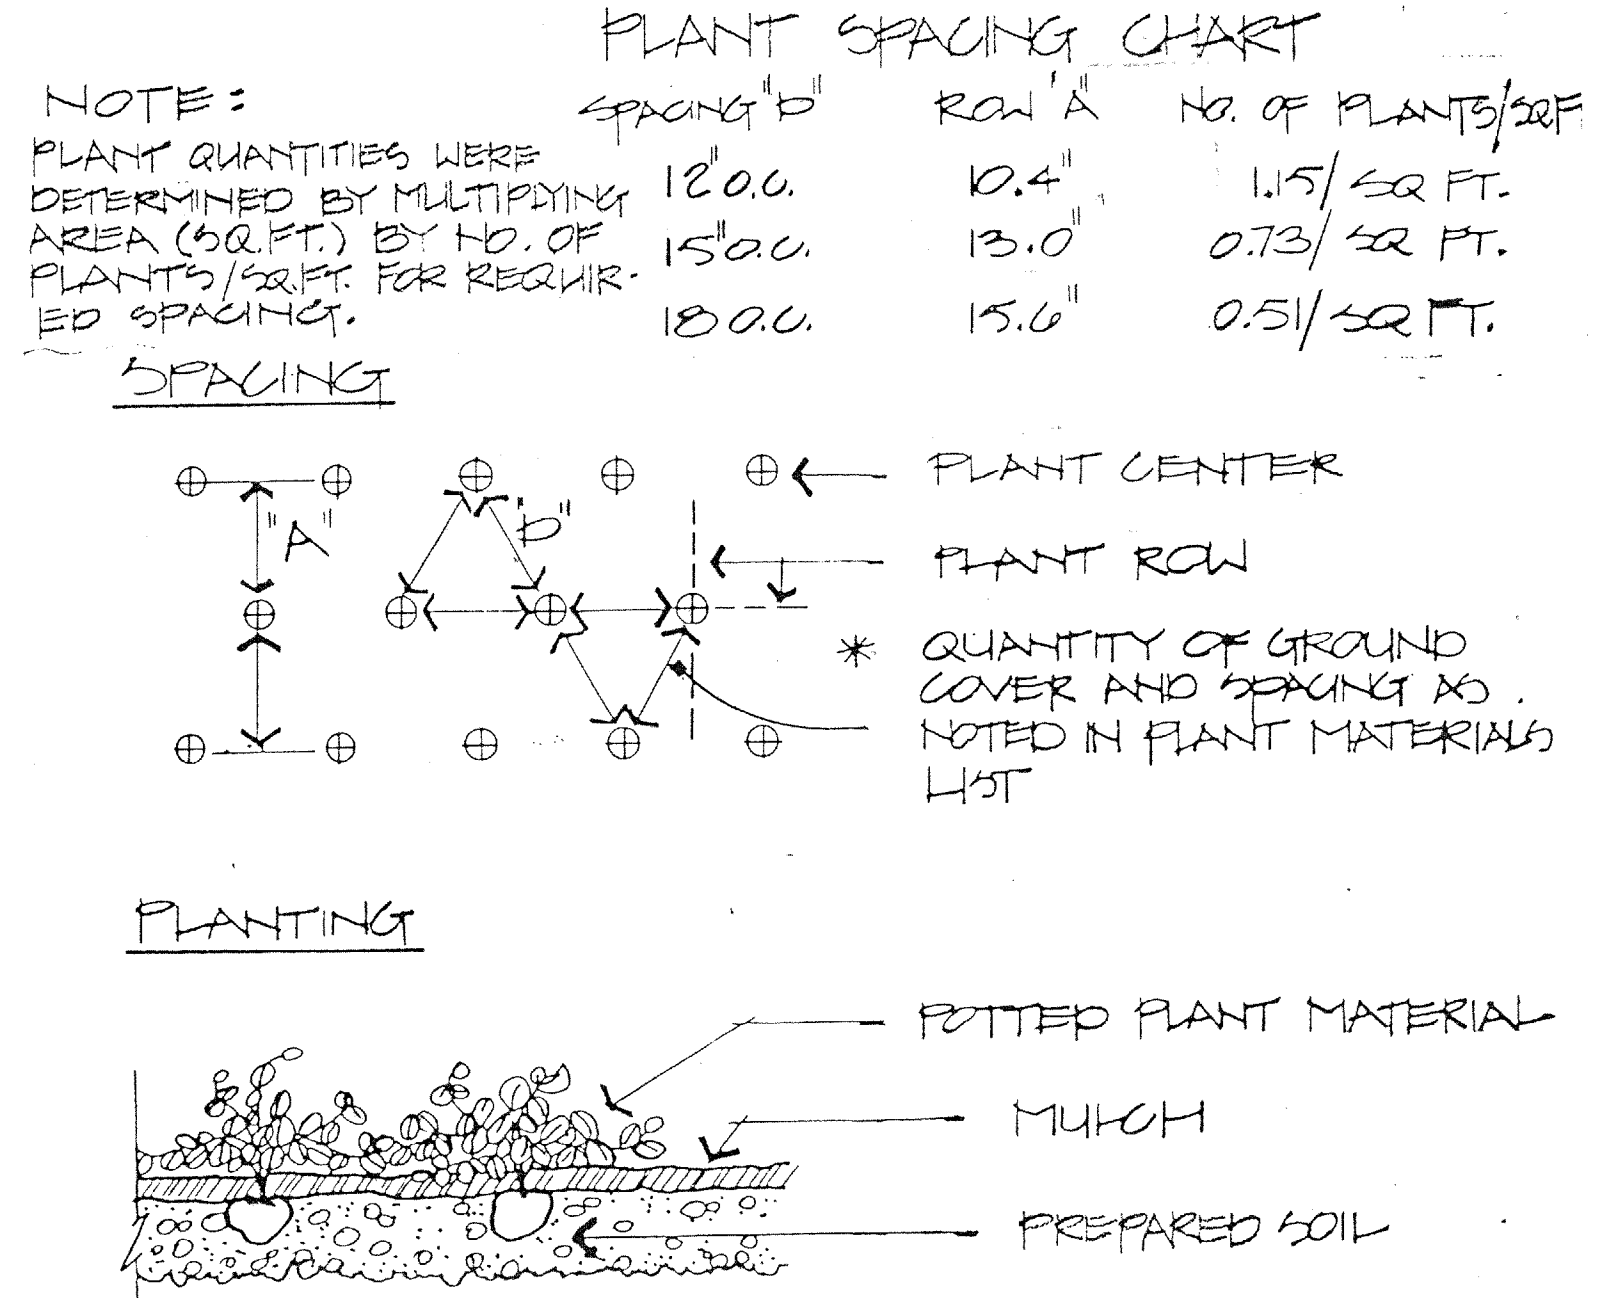


1 Typical Tree Planting

2 Hedge @ Wall

3 Hedge @ Parking Lot

4 Typical Shrub Planting



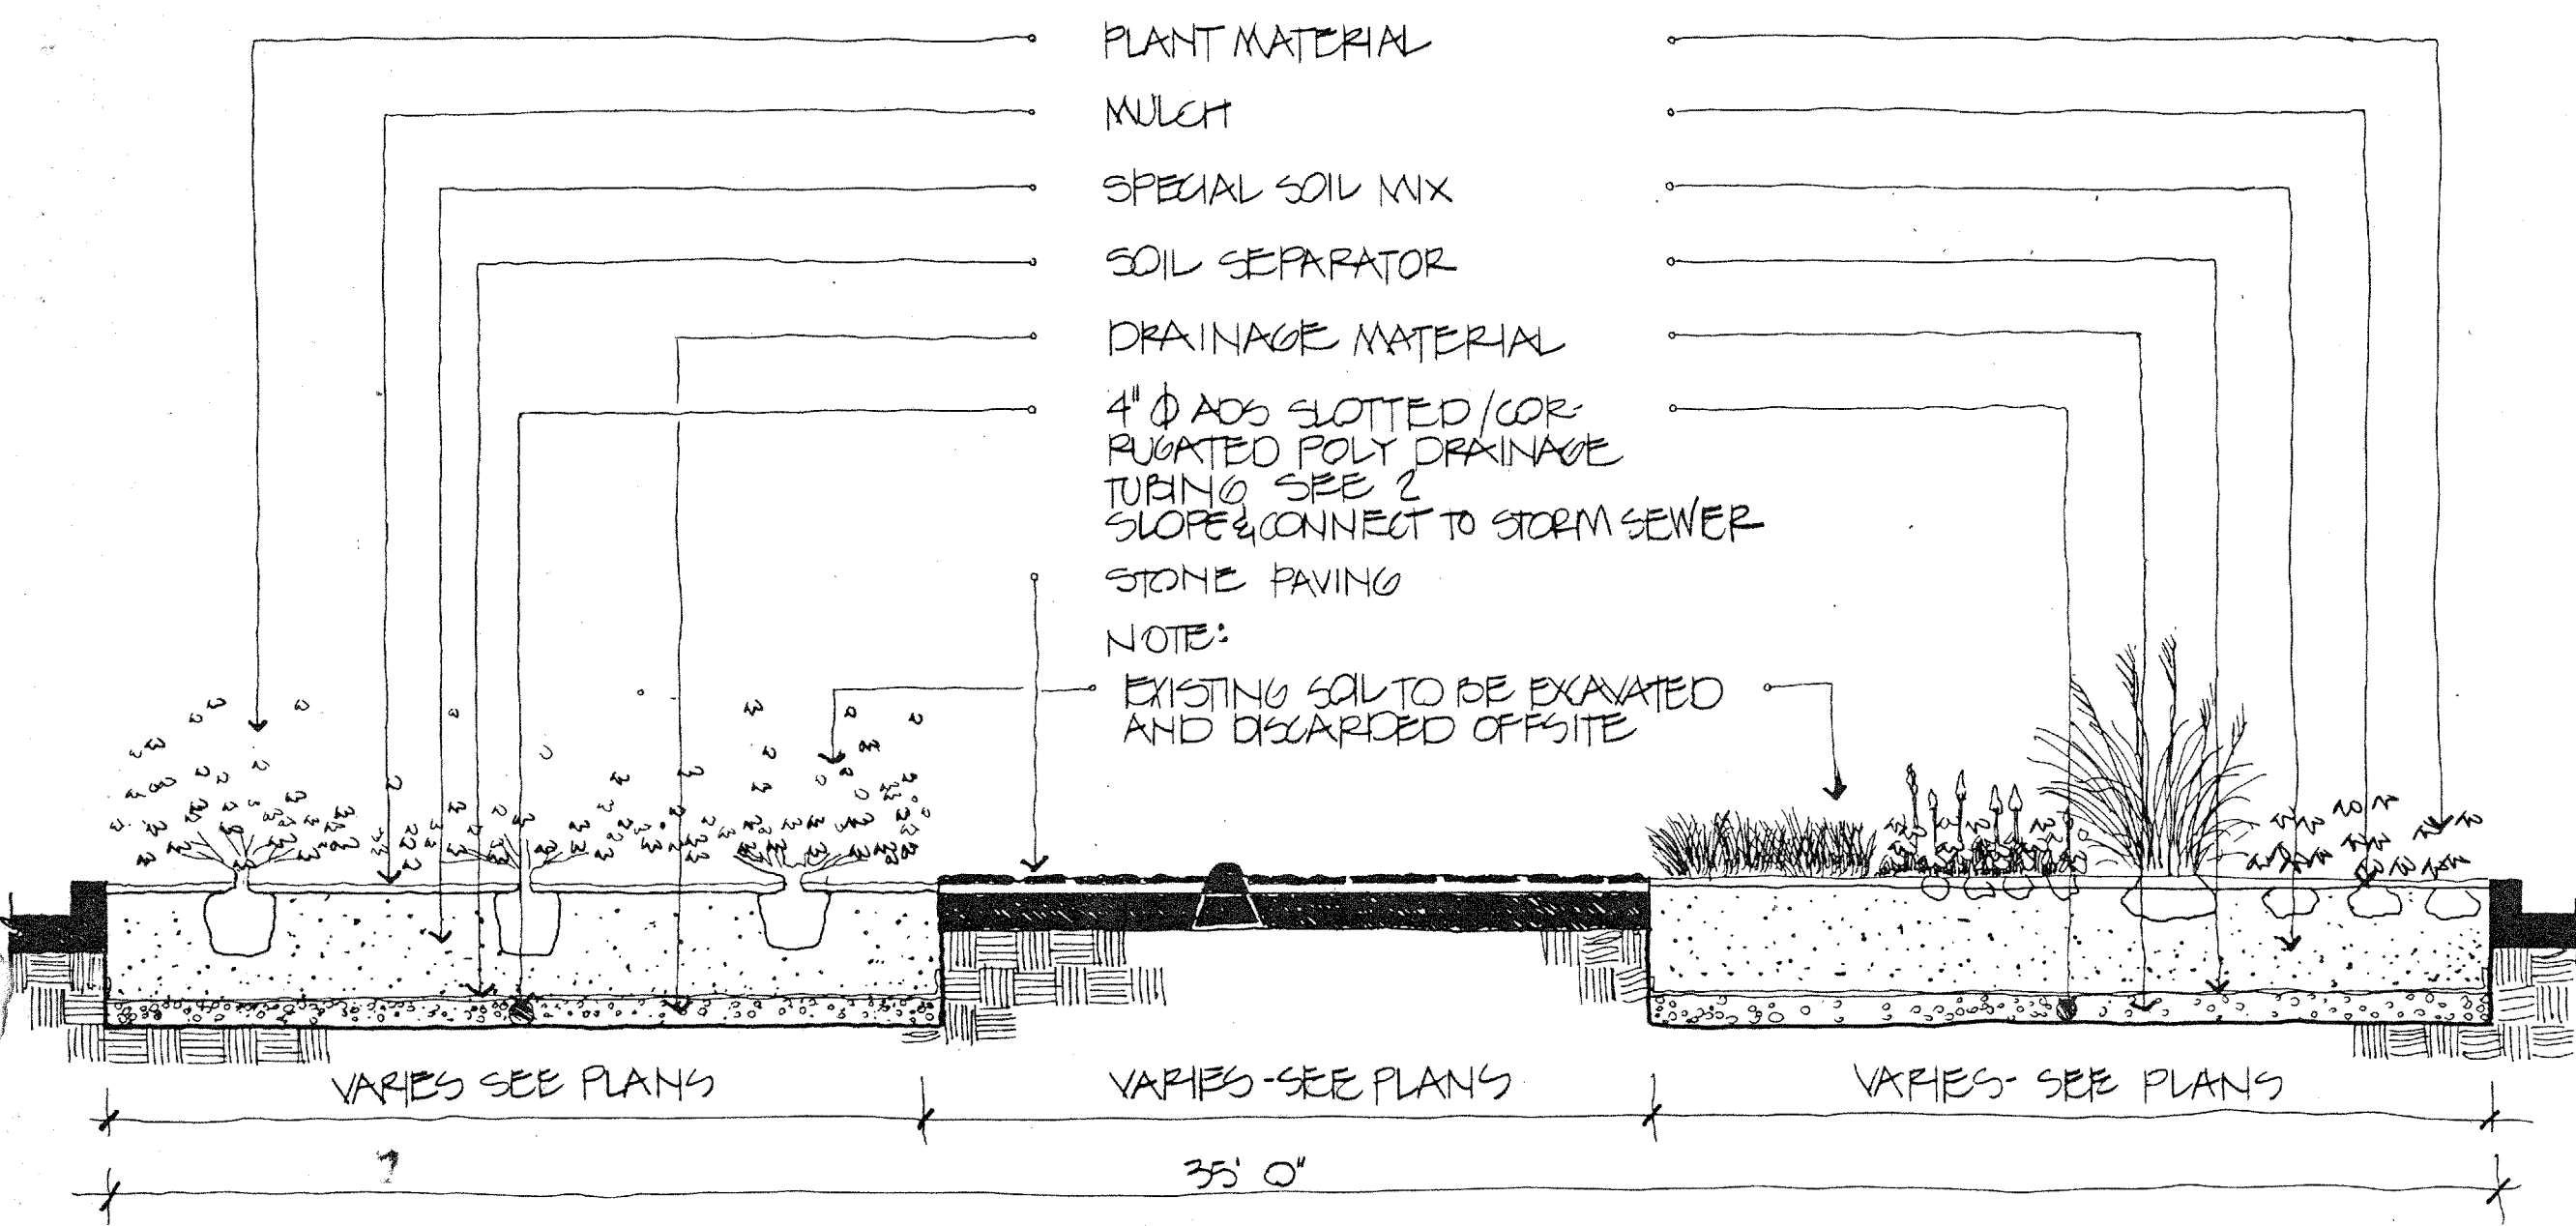


5 Section thru Pedestrian Spine

6 Typical Groundcover Planting

7 Typical Bulb Planting

8 Typical Edge @ Groundcover

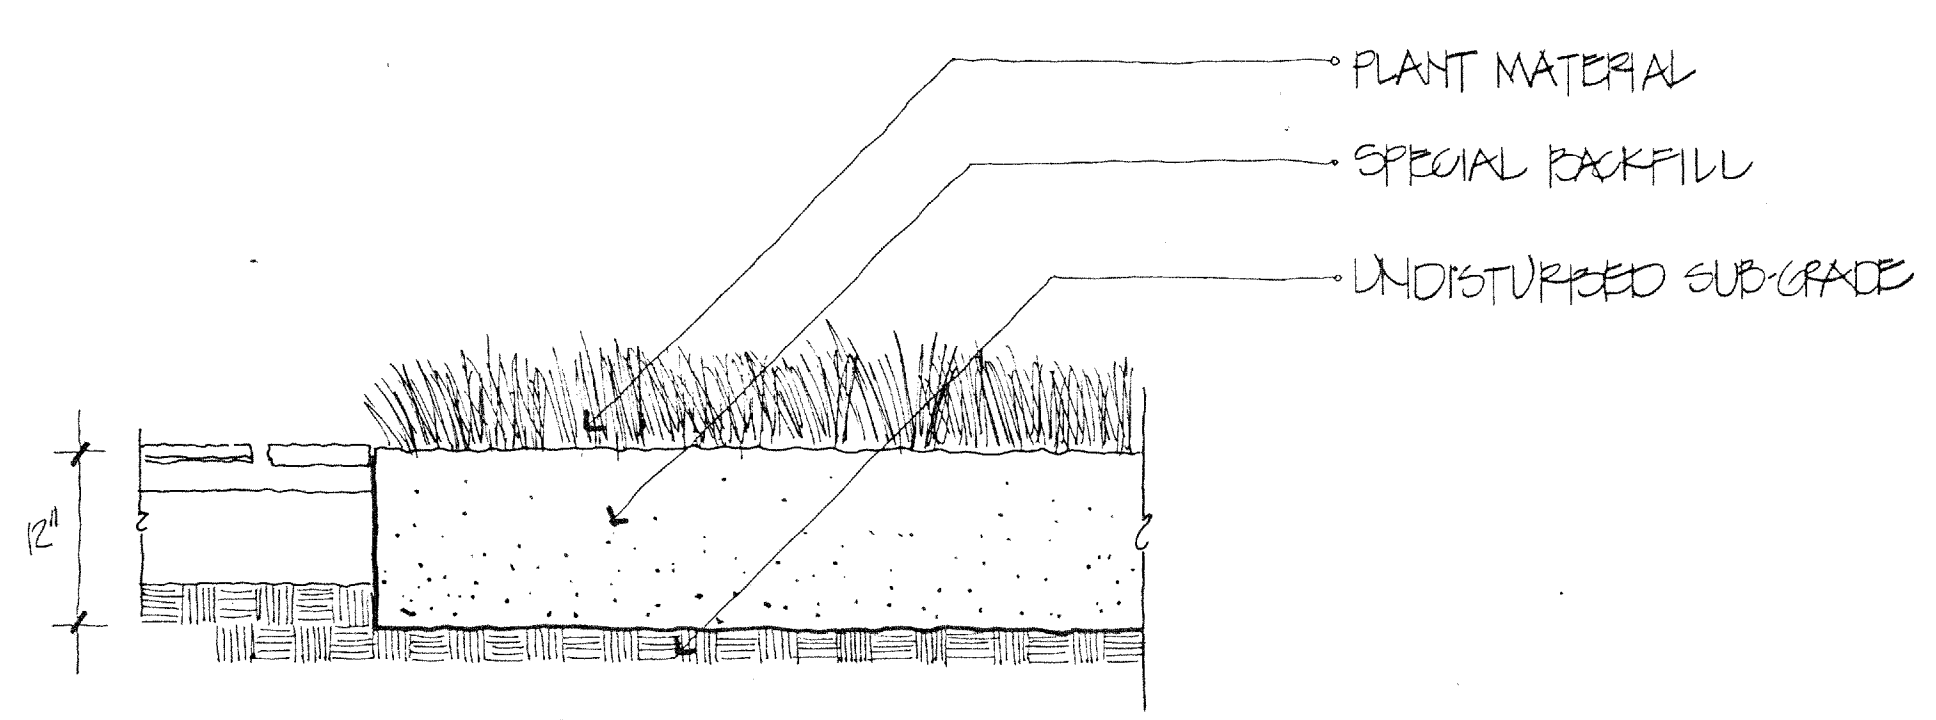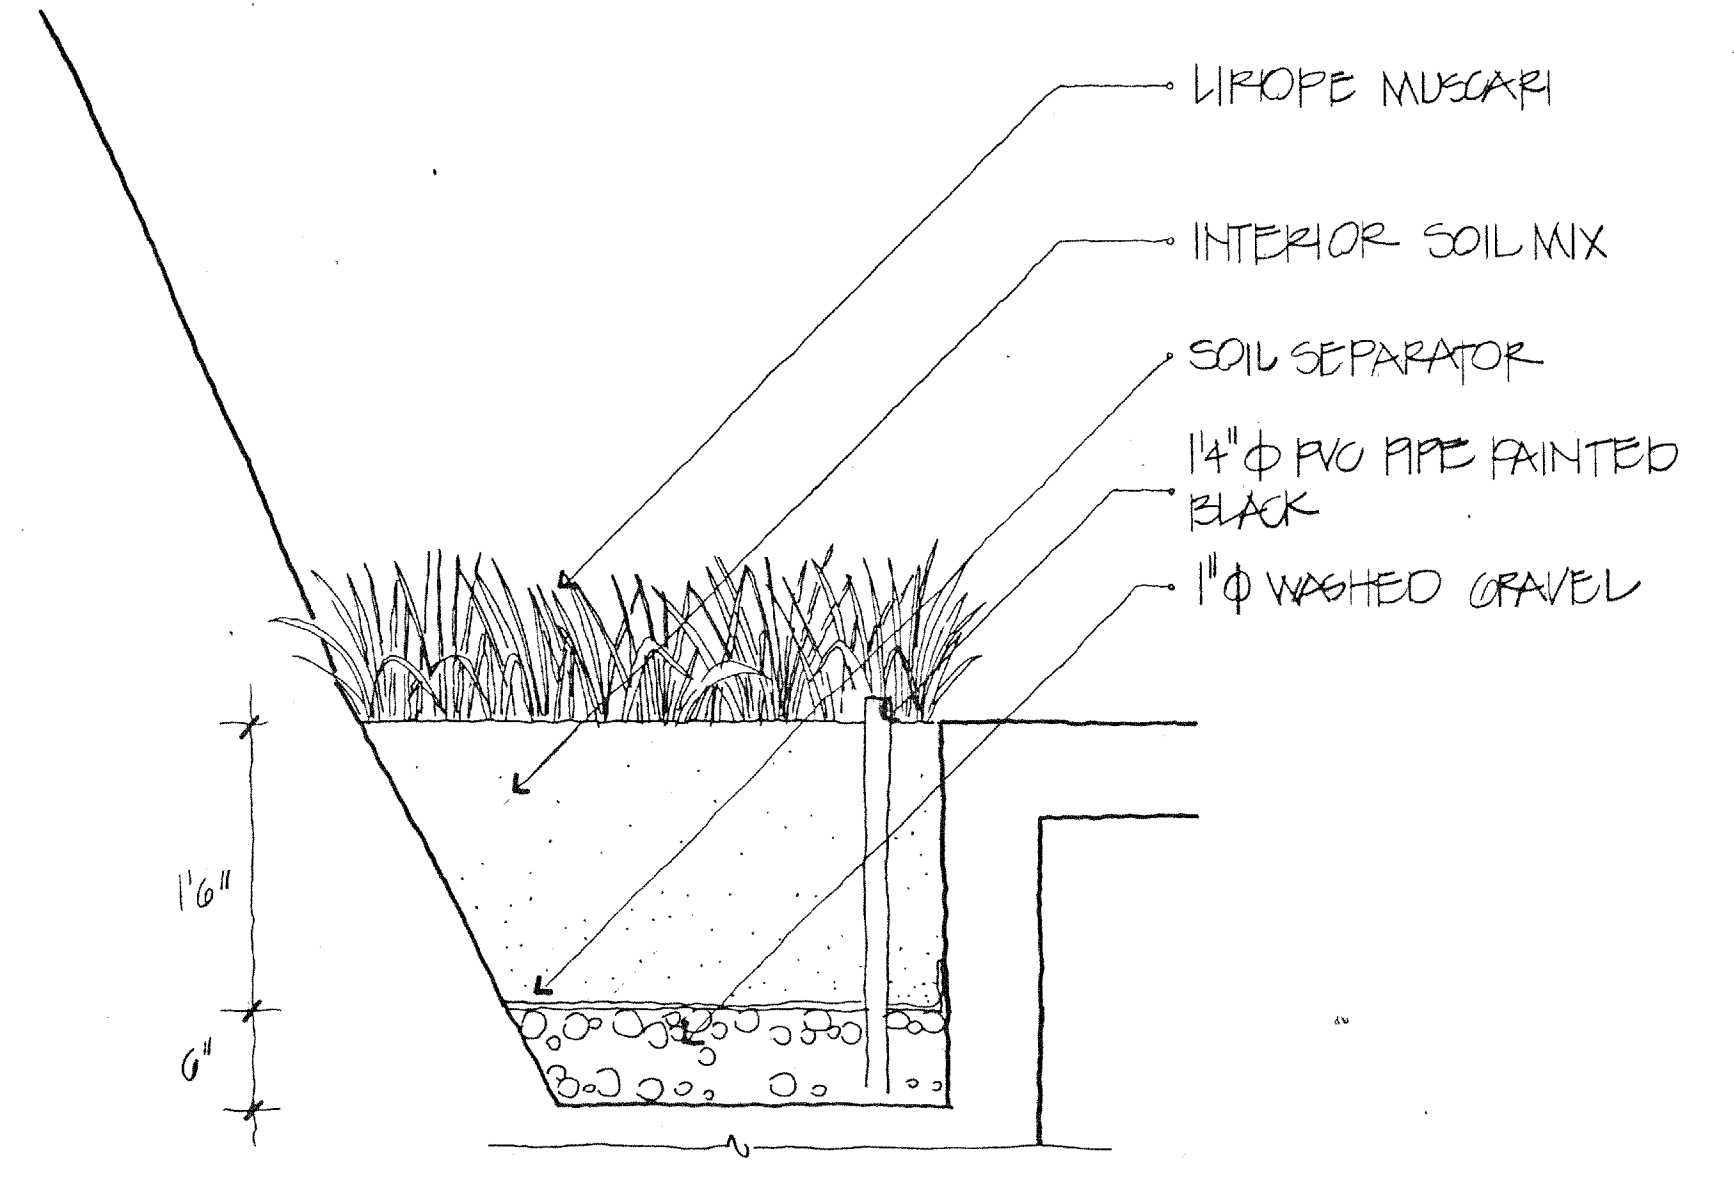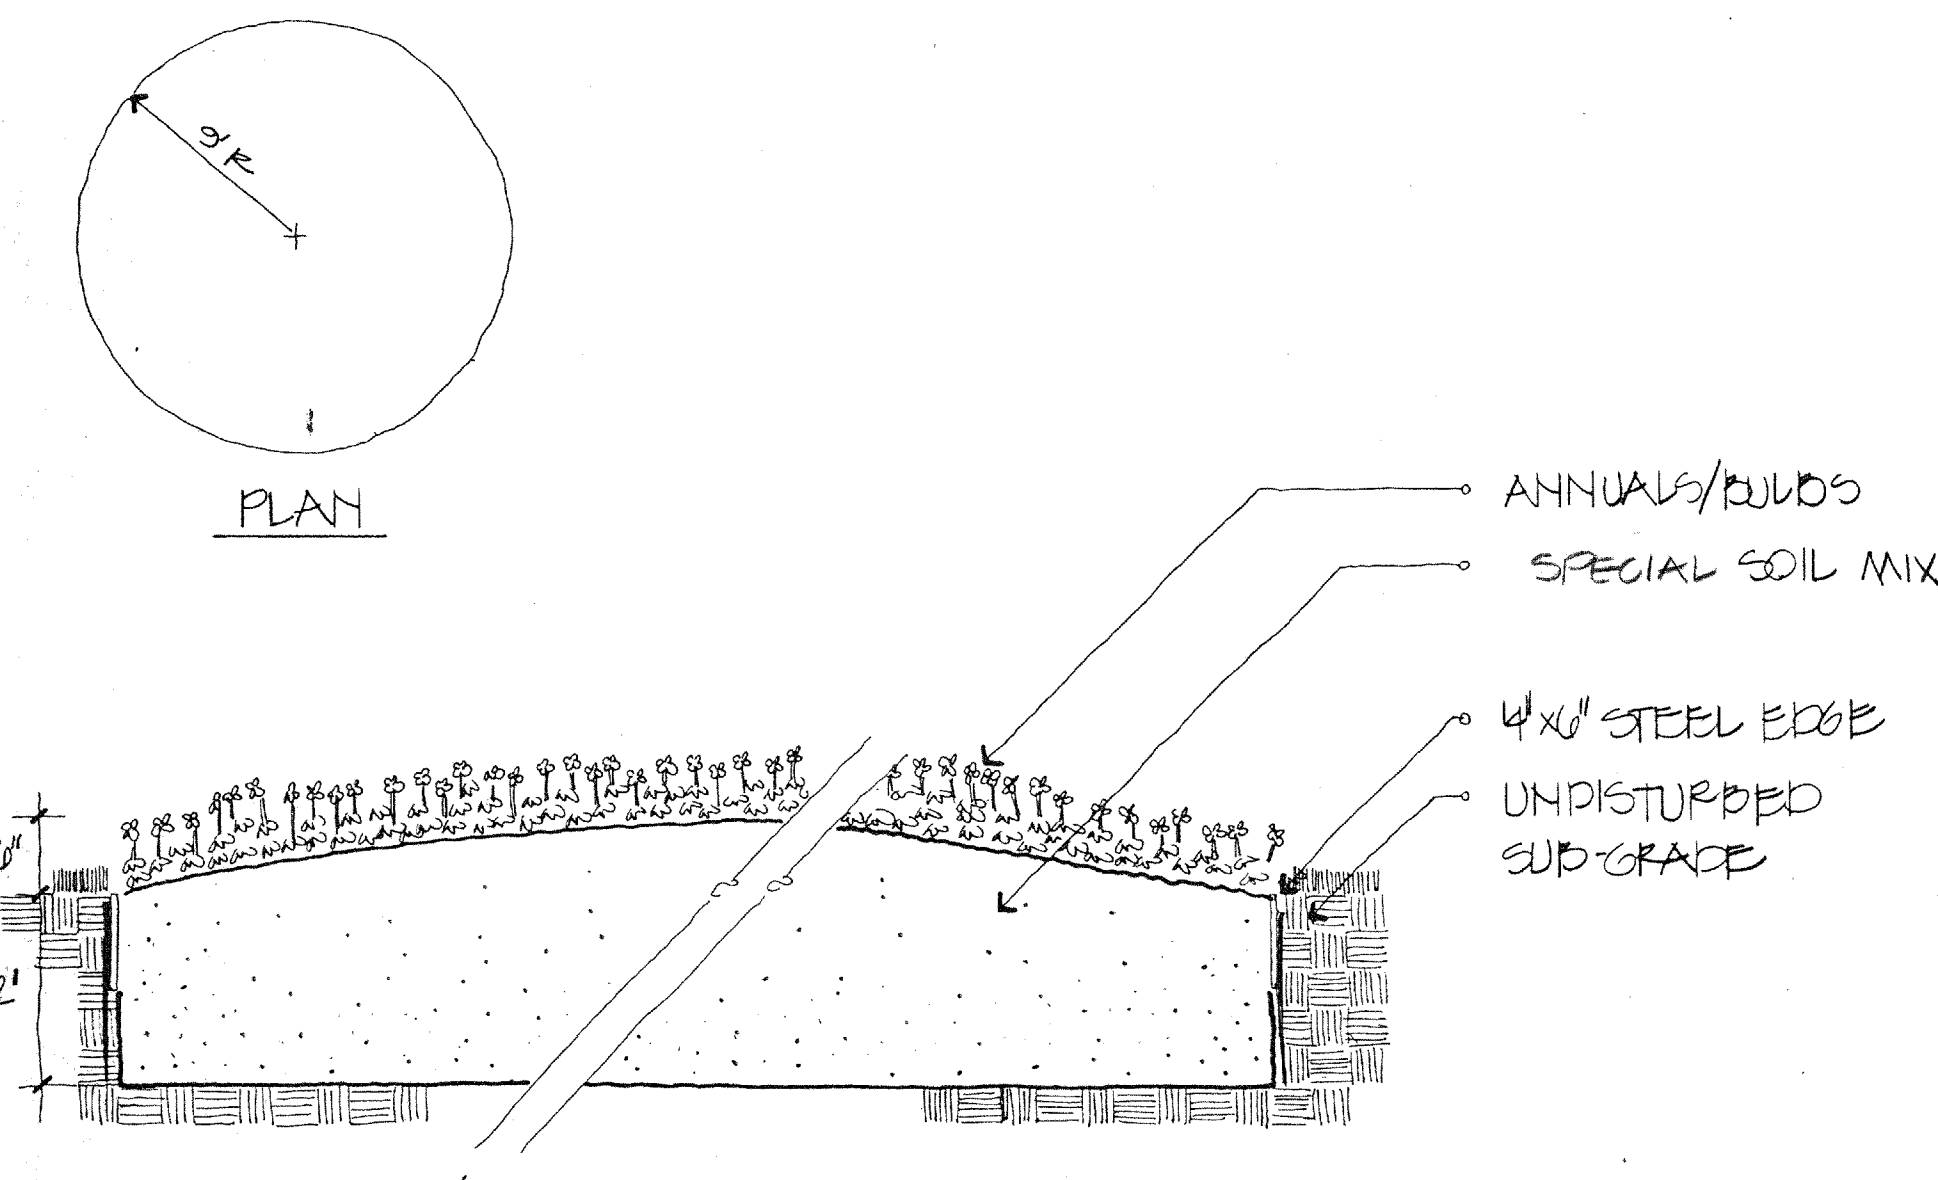

9 Annual Bed Planting


10 Interior Planting

11 Groundcover @ Entry Court

NOTE: LANDSCAPE WORK (SOFTSCAPE, EDGING, GRAVEL WORK AND IRRIGATION) IS NOT PART OF THIS CONTRACT. IT IS INCLUDED FOR INFORMATION AND COORDINATION PURPOSES ONLY.

THIS SHEET IS NOT PART OF THIS CONTRACT.

INFORMATION IS PROVIDED FOR COORDINATION PURPOSES ONLY.

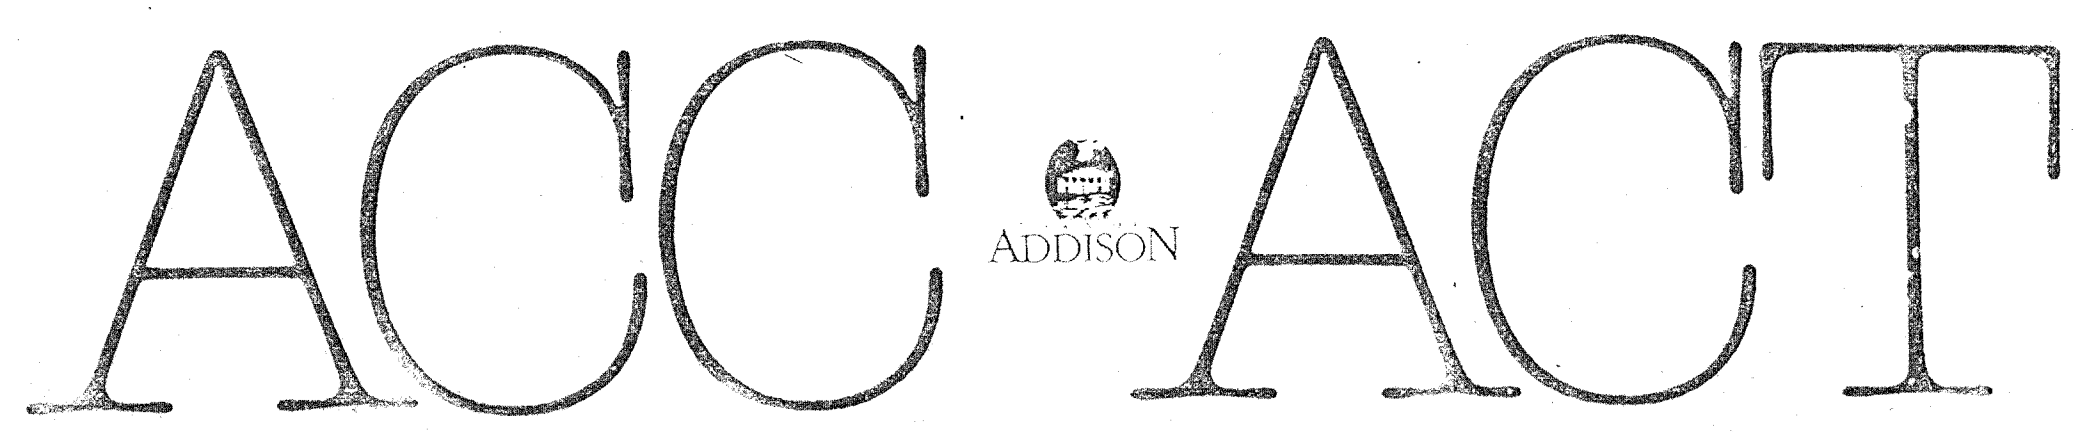

DWG. NO.	LANDSCAPE	STRUCTURAL	HISTORIAN	Issue	Category	Subcategory	Sheet
Town of Addison	The Kellams Group 317.776.1417	Ellisor Tanner 214.387.6393	Alan Mason 214.681.7182		2	5	4
ARCHITECT	Cunningham Architects 2700 Fairmont Dallas, Texas 75201 214.655.5272	THEATRE CONSULTANT Theatre Projects 203.431.3549	M.E.P. MEP Systems 214.754.4741	LIGHTING Pamela Hull Wilson 214.823.6542			
INTERIORS	CISS 713.552.2000	CIVIL Kurtz & Associates 214.690.3322	GRAPHICS Nuttstad Design 214.554.1078				
	ACOUSTICS Johner-Rese Group 214.397.7800						