


Addison Road

Mildred Street

NOTE: WORK IN BUBBLED AREA IS TO BE PRICED UNDER LINE ITEM A: STREET BENCH WORK. WORK INCLUDES THE FOLLOWING:
 CONCRETE PIER WORK
 CONCRETE BOLLARDS
 LIGHTING, WIRING, PANEL BOARD AND ASSOCIATED ELECTRICAL SERVICE (INCLUDING ELECTRICAL WORK ACROSS THE STREET)
 STEEL BENCH SEAT, INCLUDING PAINT WORK
 STEEL EDGING AND CRUSHED GRANITE
 WATER HYDRANTS AND ASSOCIATED PLUMBING WORK
 ASSOCIATED GENERAL CONDITIONS.

REV
 Add 1

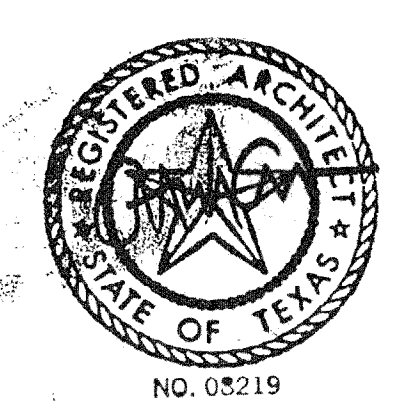

ACC ADDISON ACT

| | | | | | | | |
|---|--|--|--|--------------------------------|---------------|------------------|------------|
| OWNER Town of Addison | LANDSCAPE The Kellams Group 377-776-1417 | STRUCTURAL Ellisor Tanner 214-387-8393 | HISTORIAN Alan Mason 214-691-7182 | Issue ISSUE FOR BID 8-17-00 | Category 2 | Subcategory 3 | Sheet 1 |
| ARCHITECT Cooningham Architects 2700 Fairmount Dallas, Texas 75201 214-855-5272 | THEATRE CONSULTANT Theatre Projects 203-431-3949 | M.E.P. MEP Systems 214-754-4741 | LIGHTING Pamela Hull Wilson 214-823-6542 | | | | |
| INTERIORS CRSS 713-552-2000 | CIVIL Kurtz & Associates 214-490-3322 | GRAPHICS Notrestad Design 214-954-9378 | | | | | |

Layout Plan