

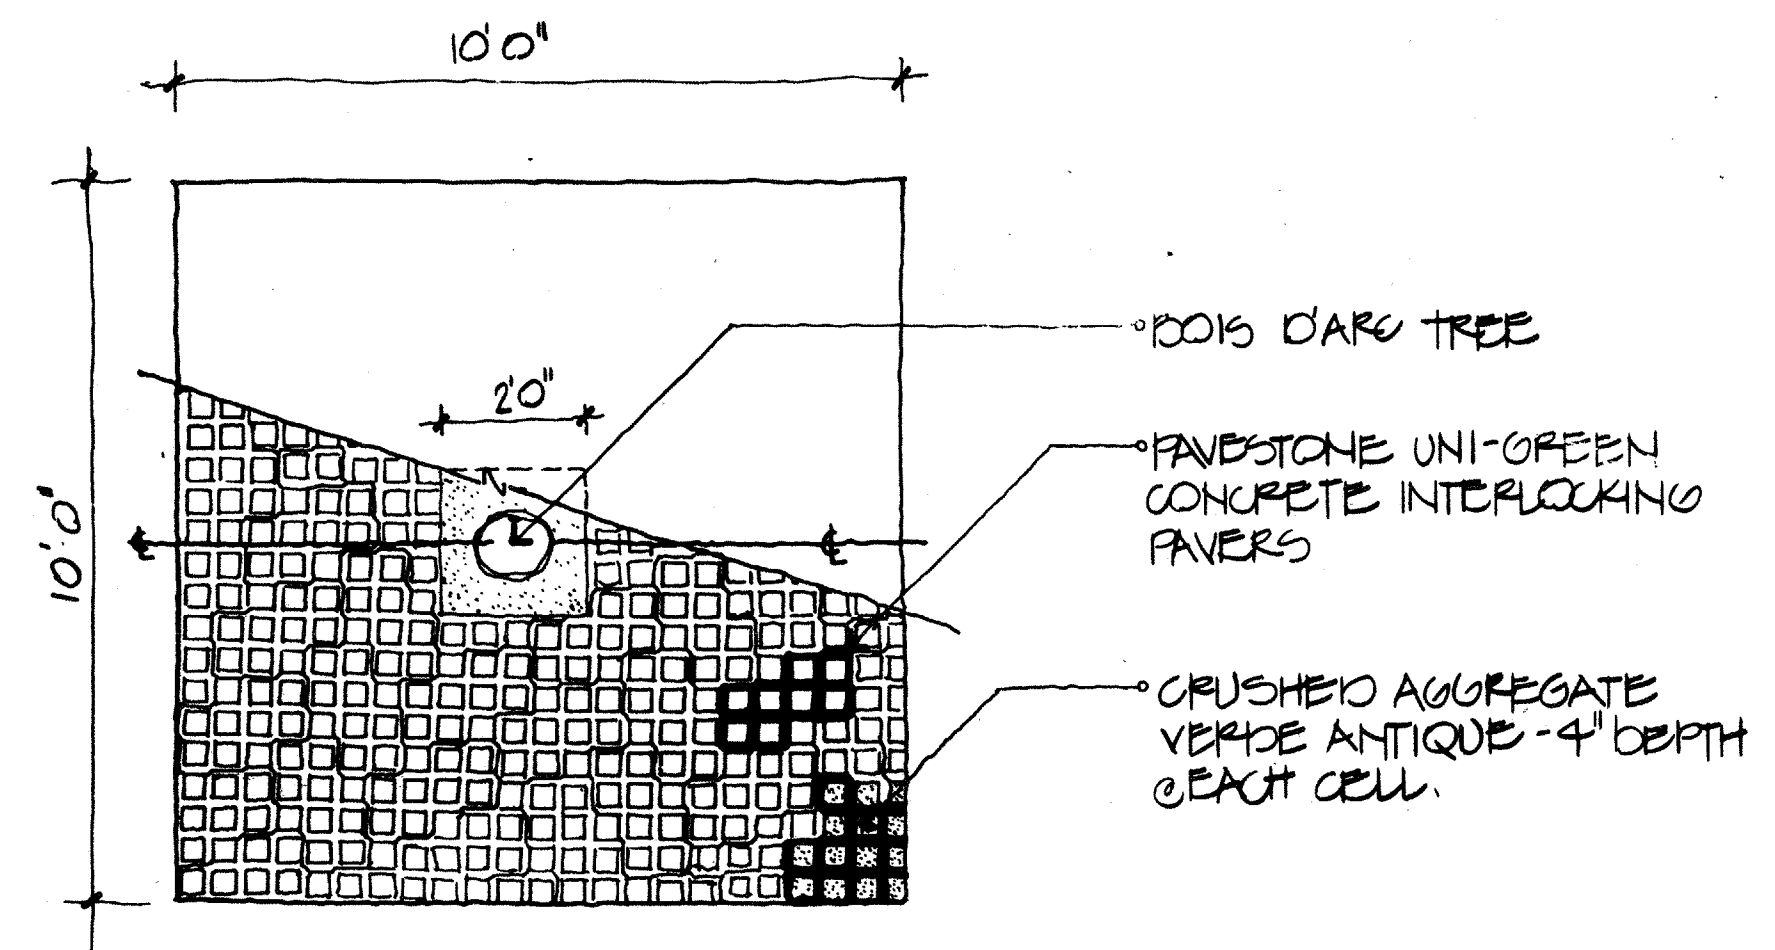



1 Waste Materials Storage
3/16" = 1'0"

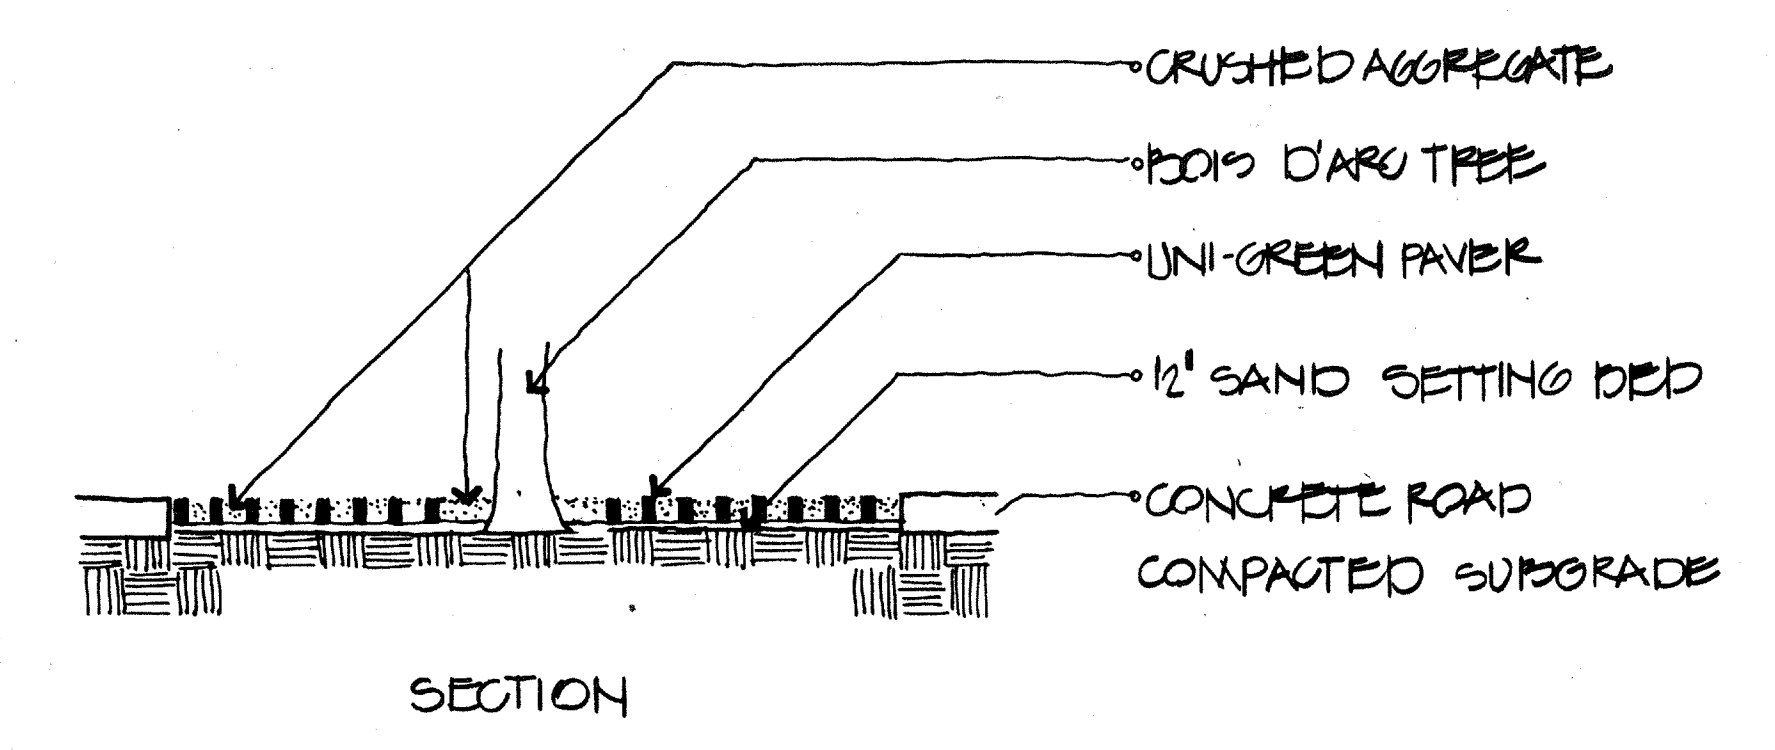


2 Bois D'Arc Paving
3/16" = 1'0"

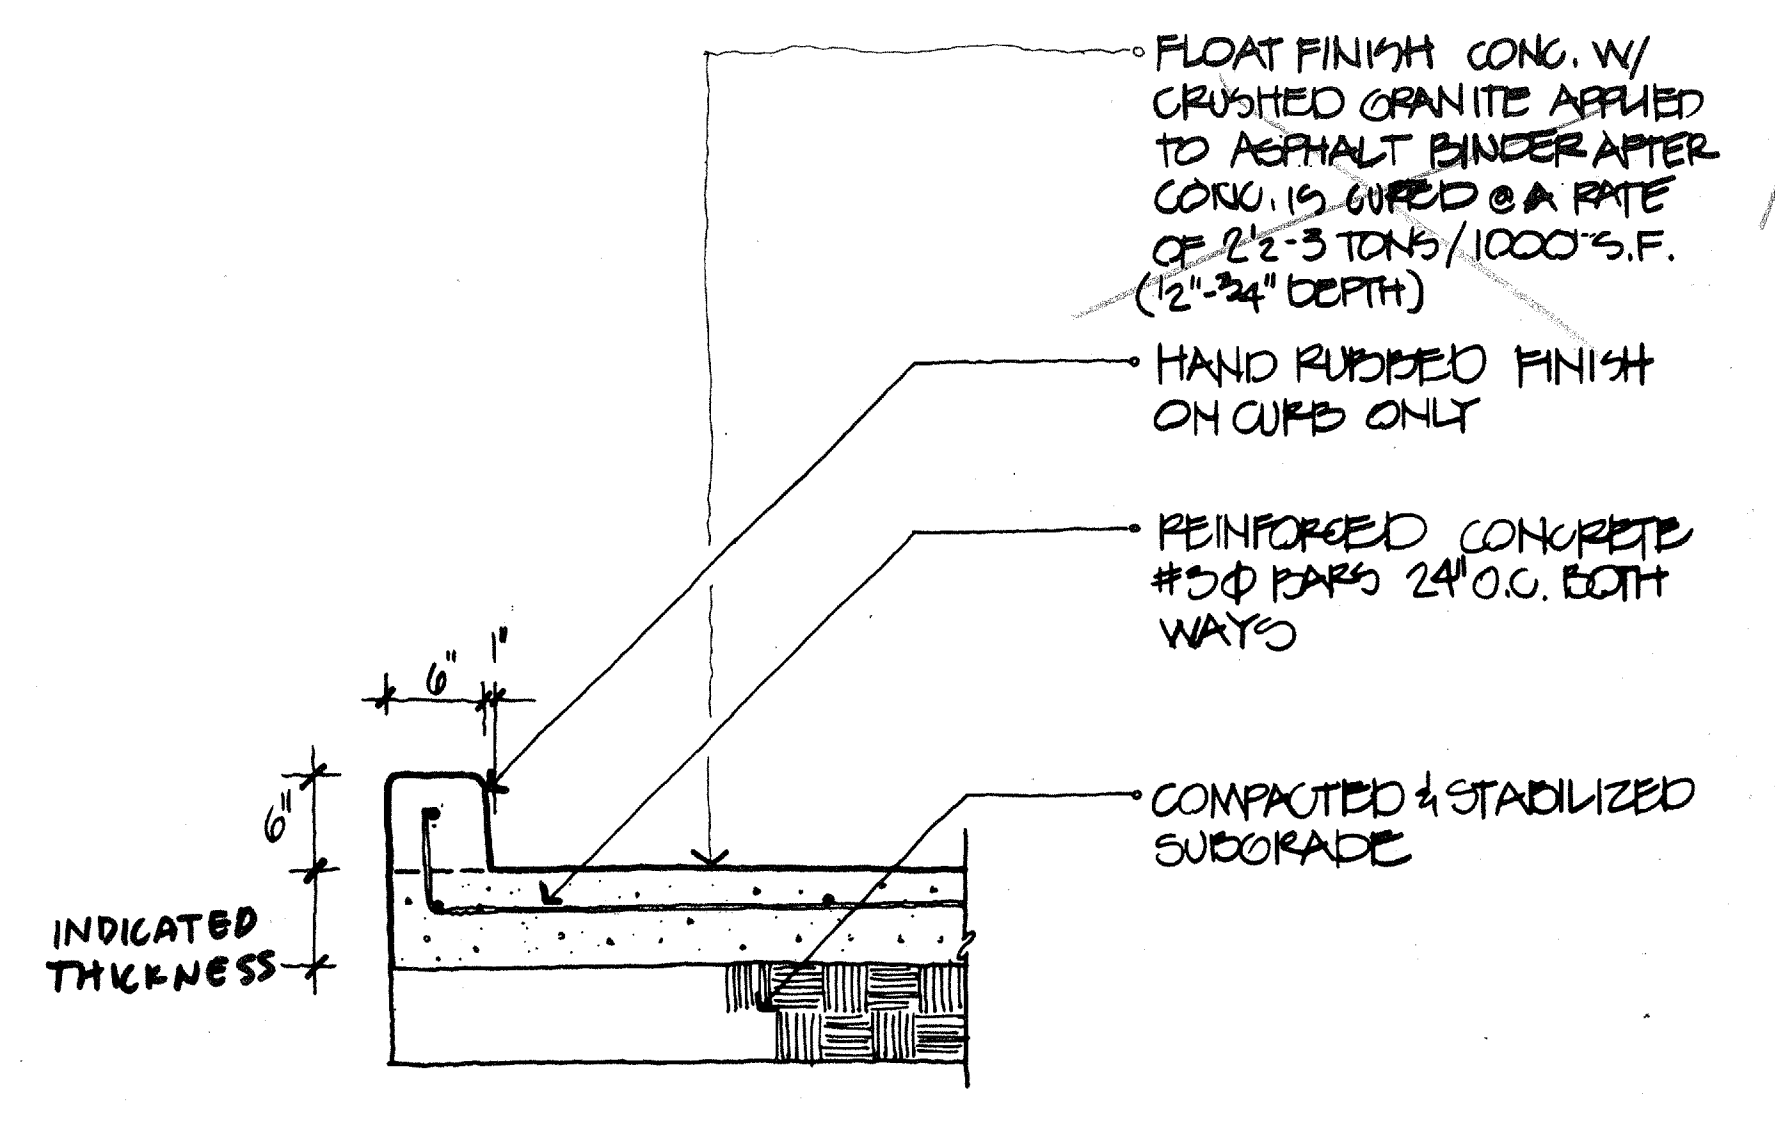


3 Typical Parking Lot Paving
1" = 1'0"

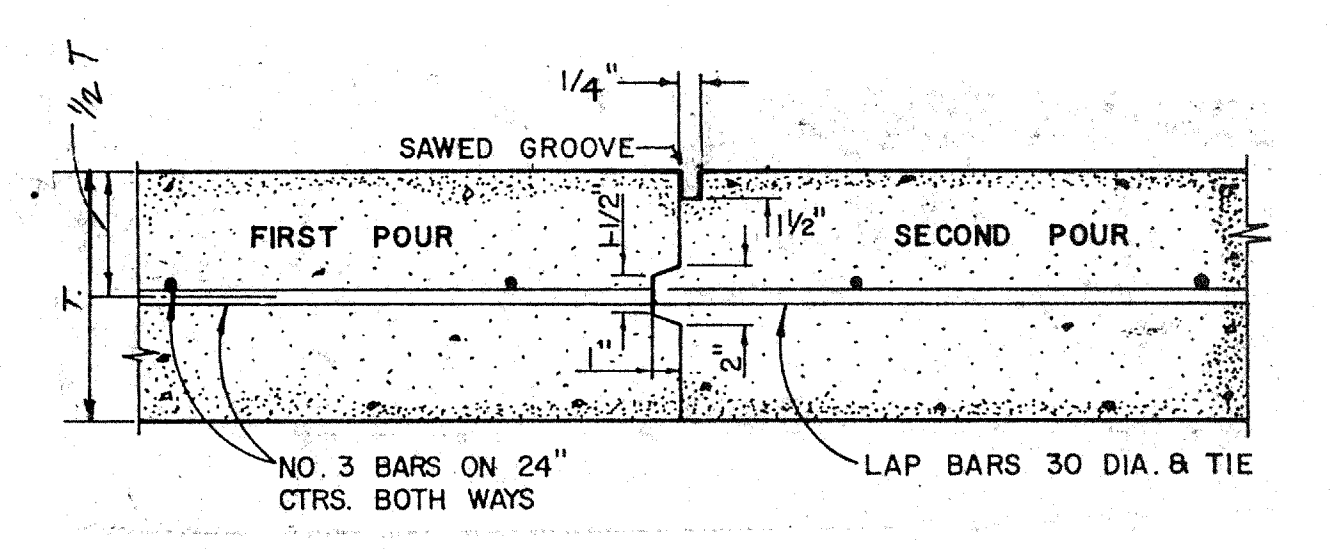



4 Typical Construction Joint

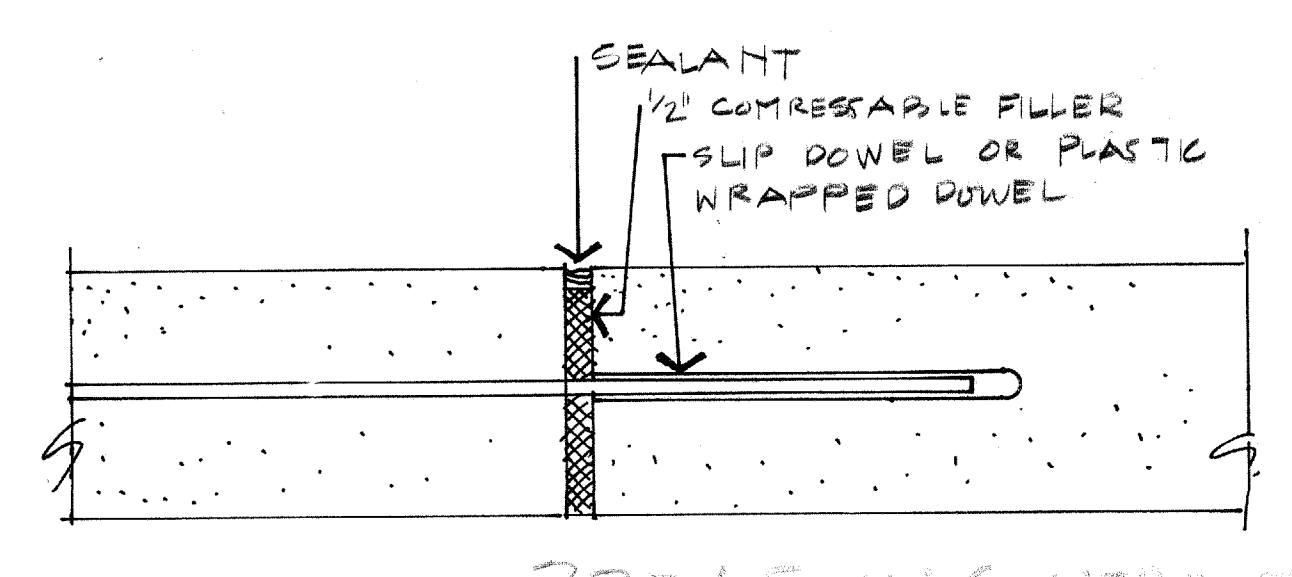


5 Typical Expansion Jt.
3/16" = 1'0"

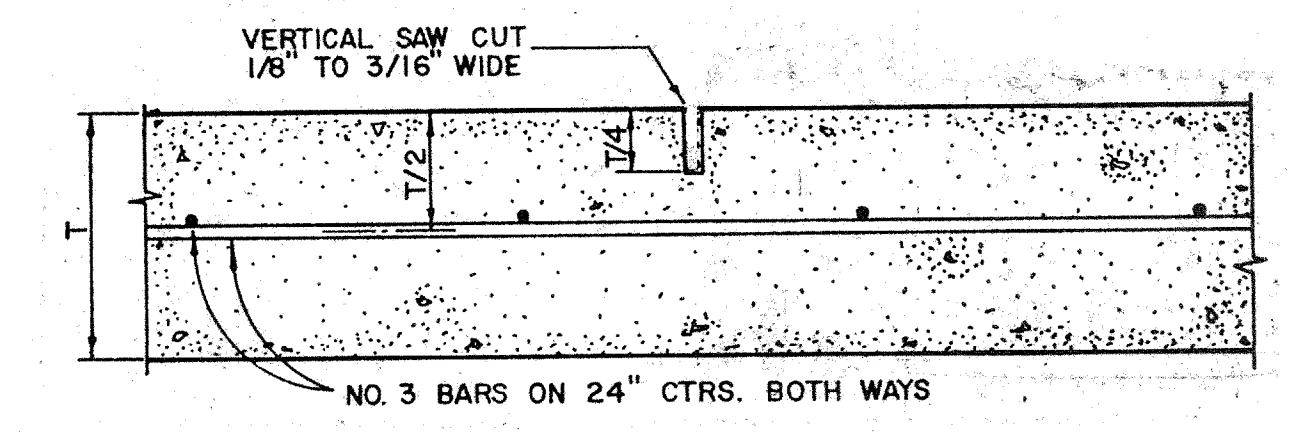


6 Typical Control Jt.

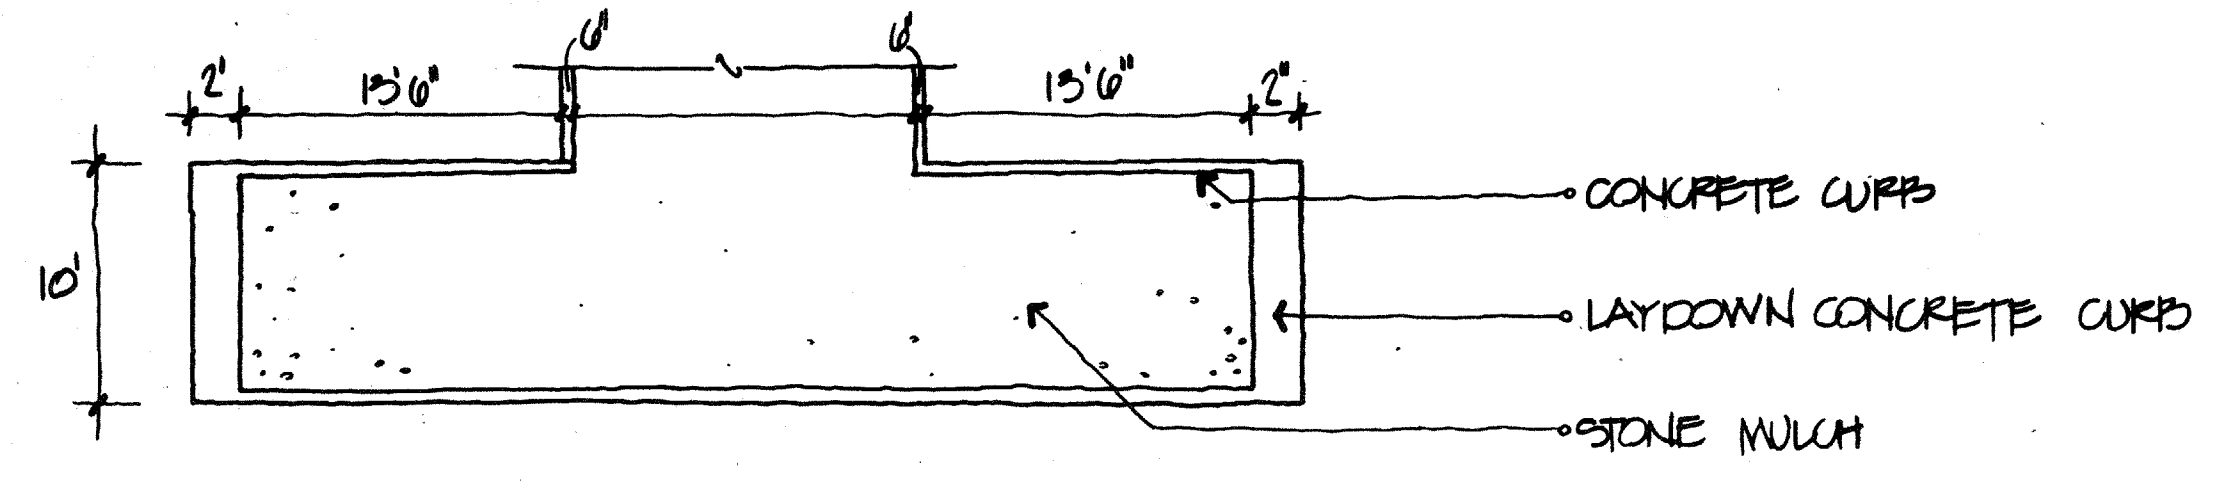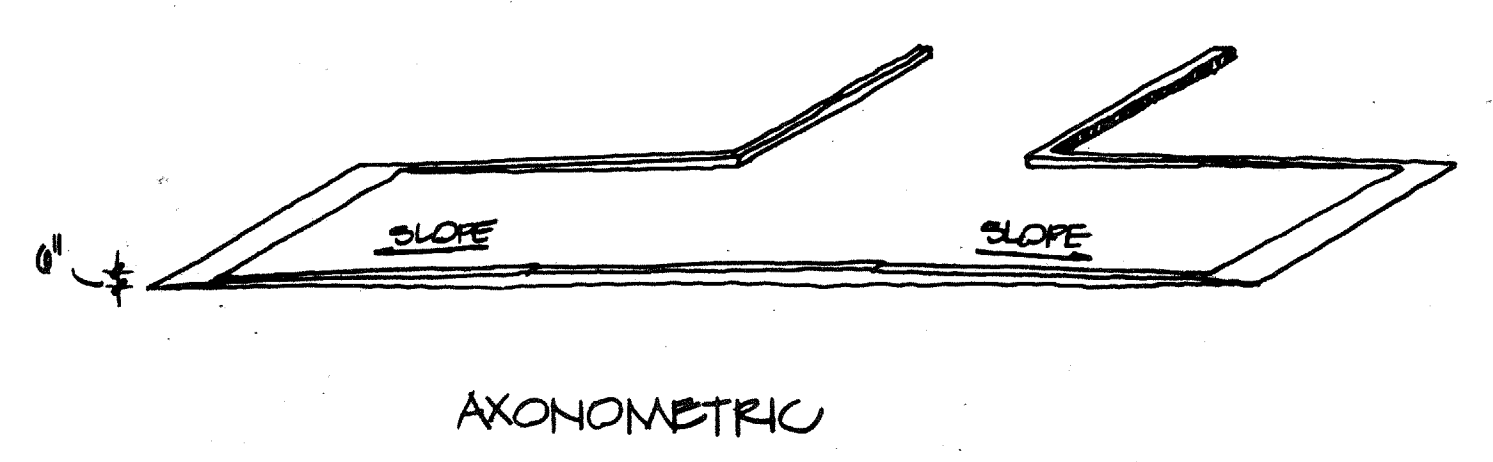

7 Laydown Curb
1/8" = 1'0"

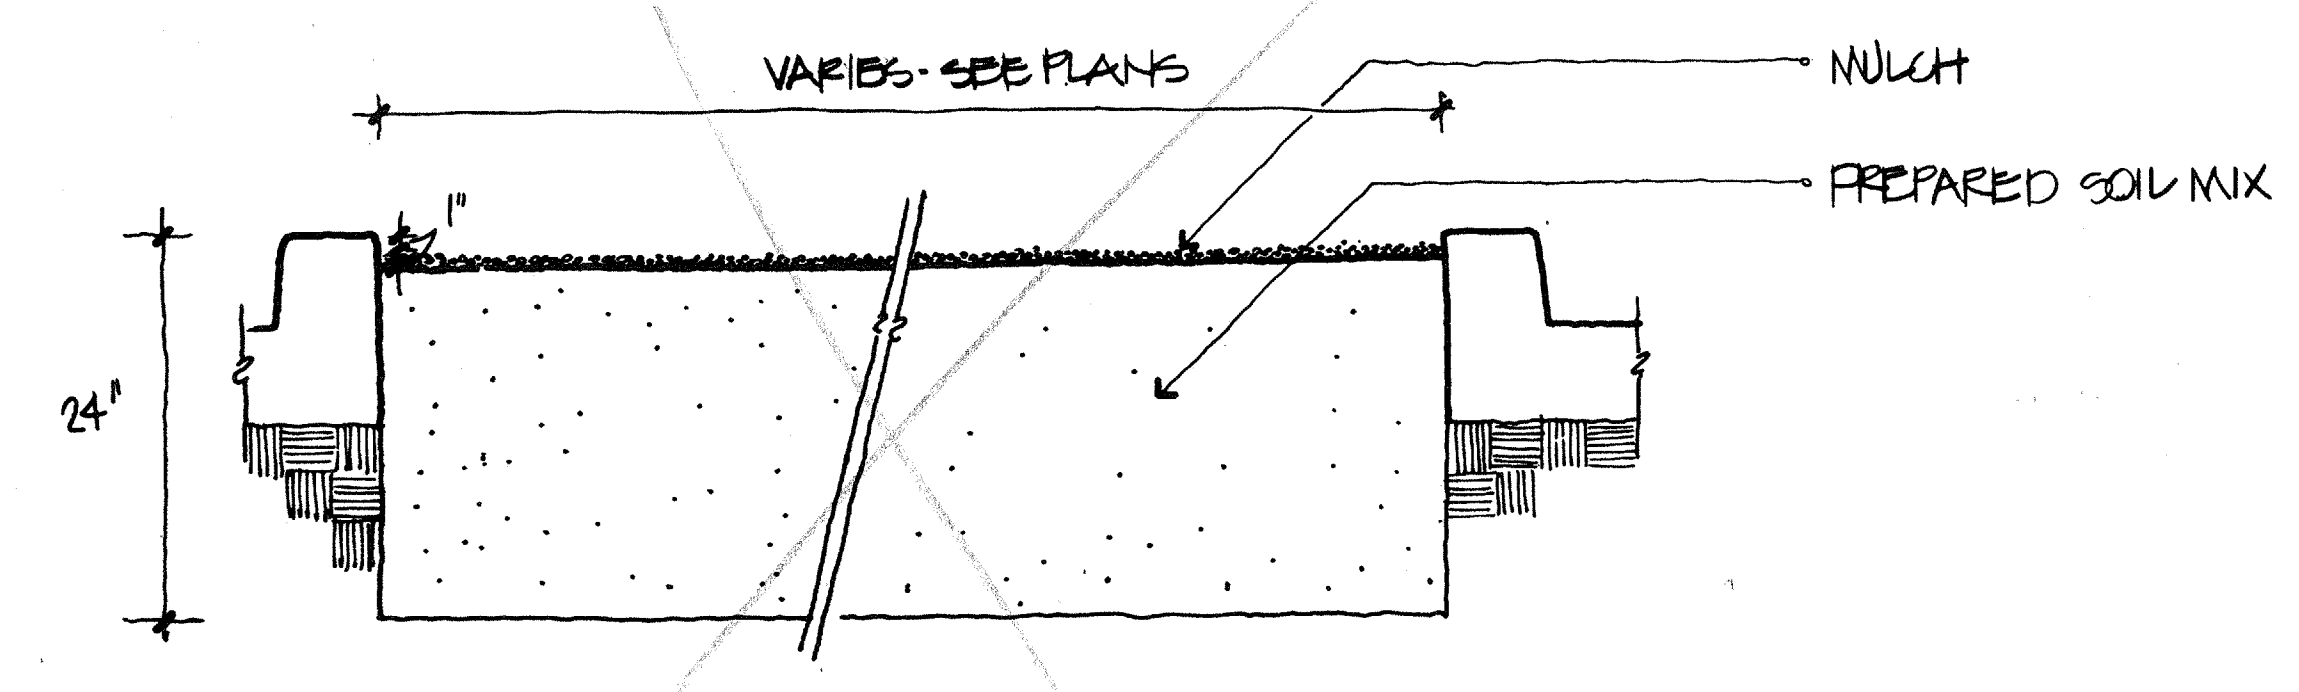

8 Typical Parking Lot Planter
1" = 1'0"

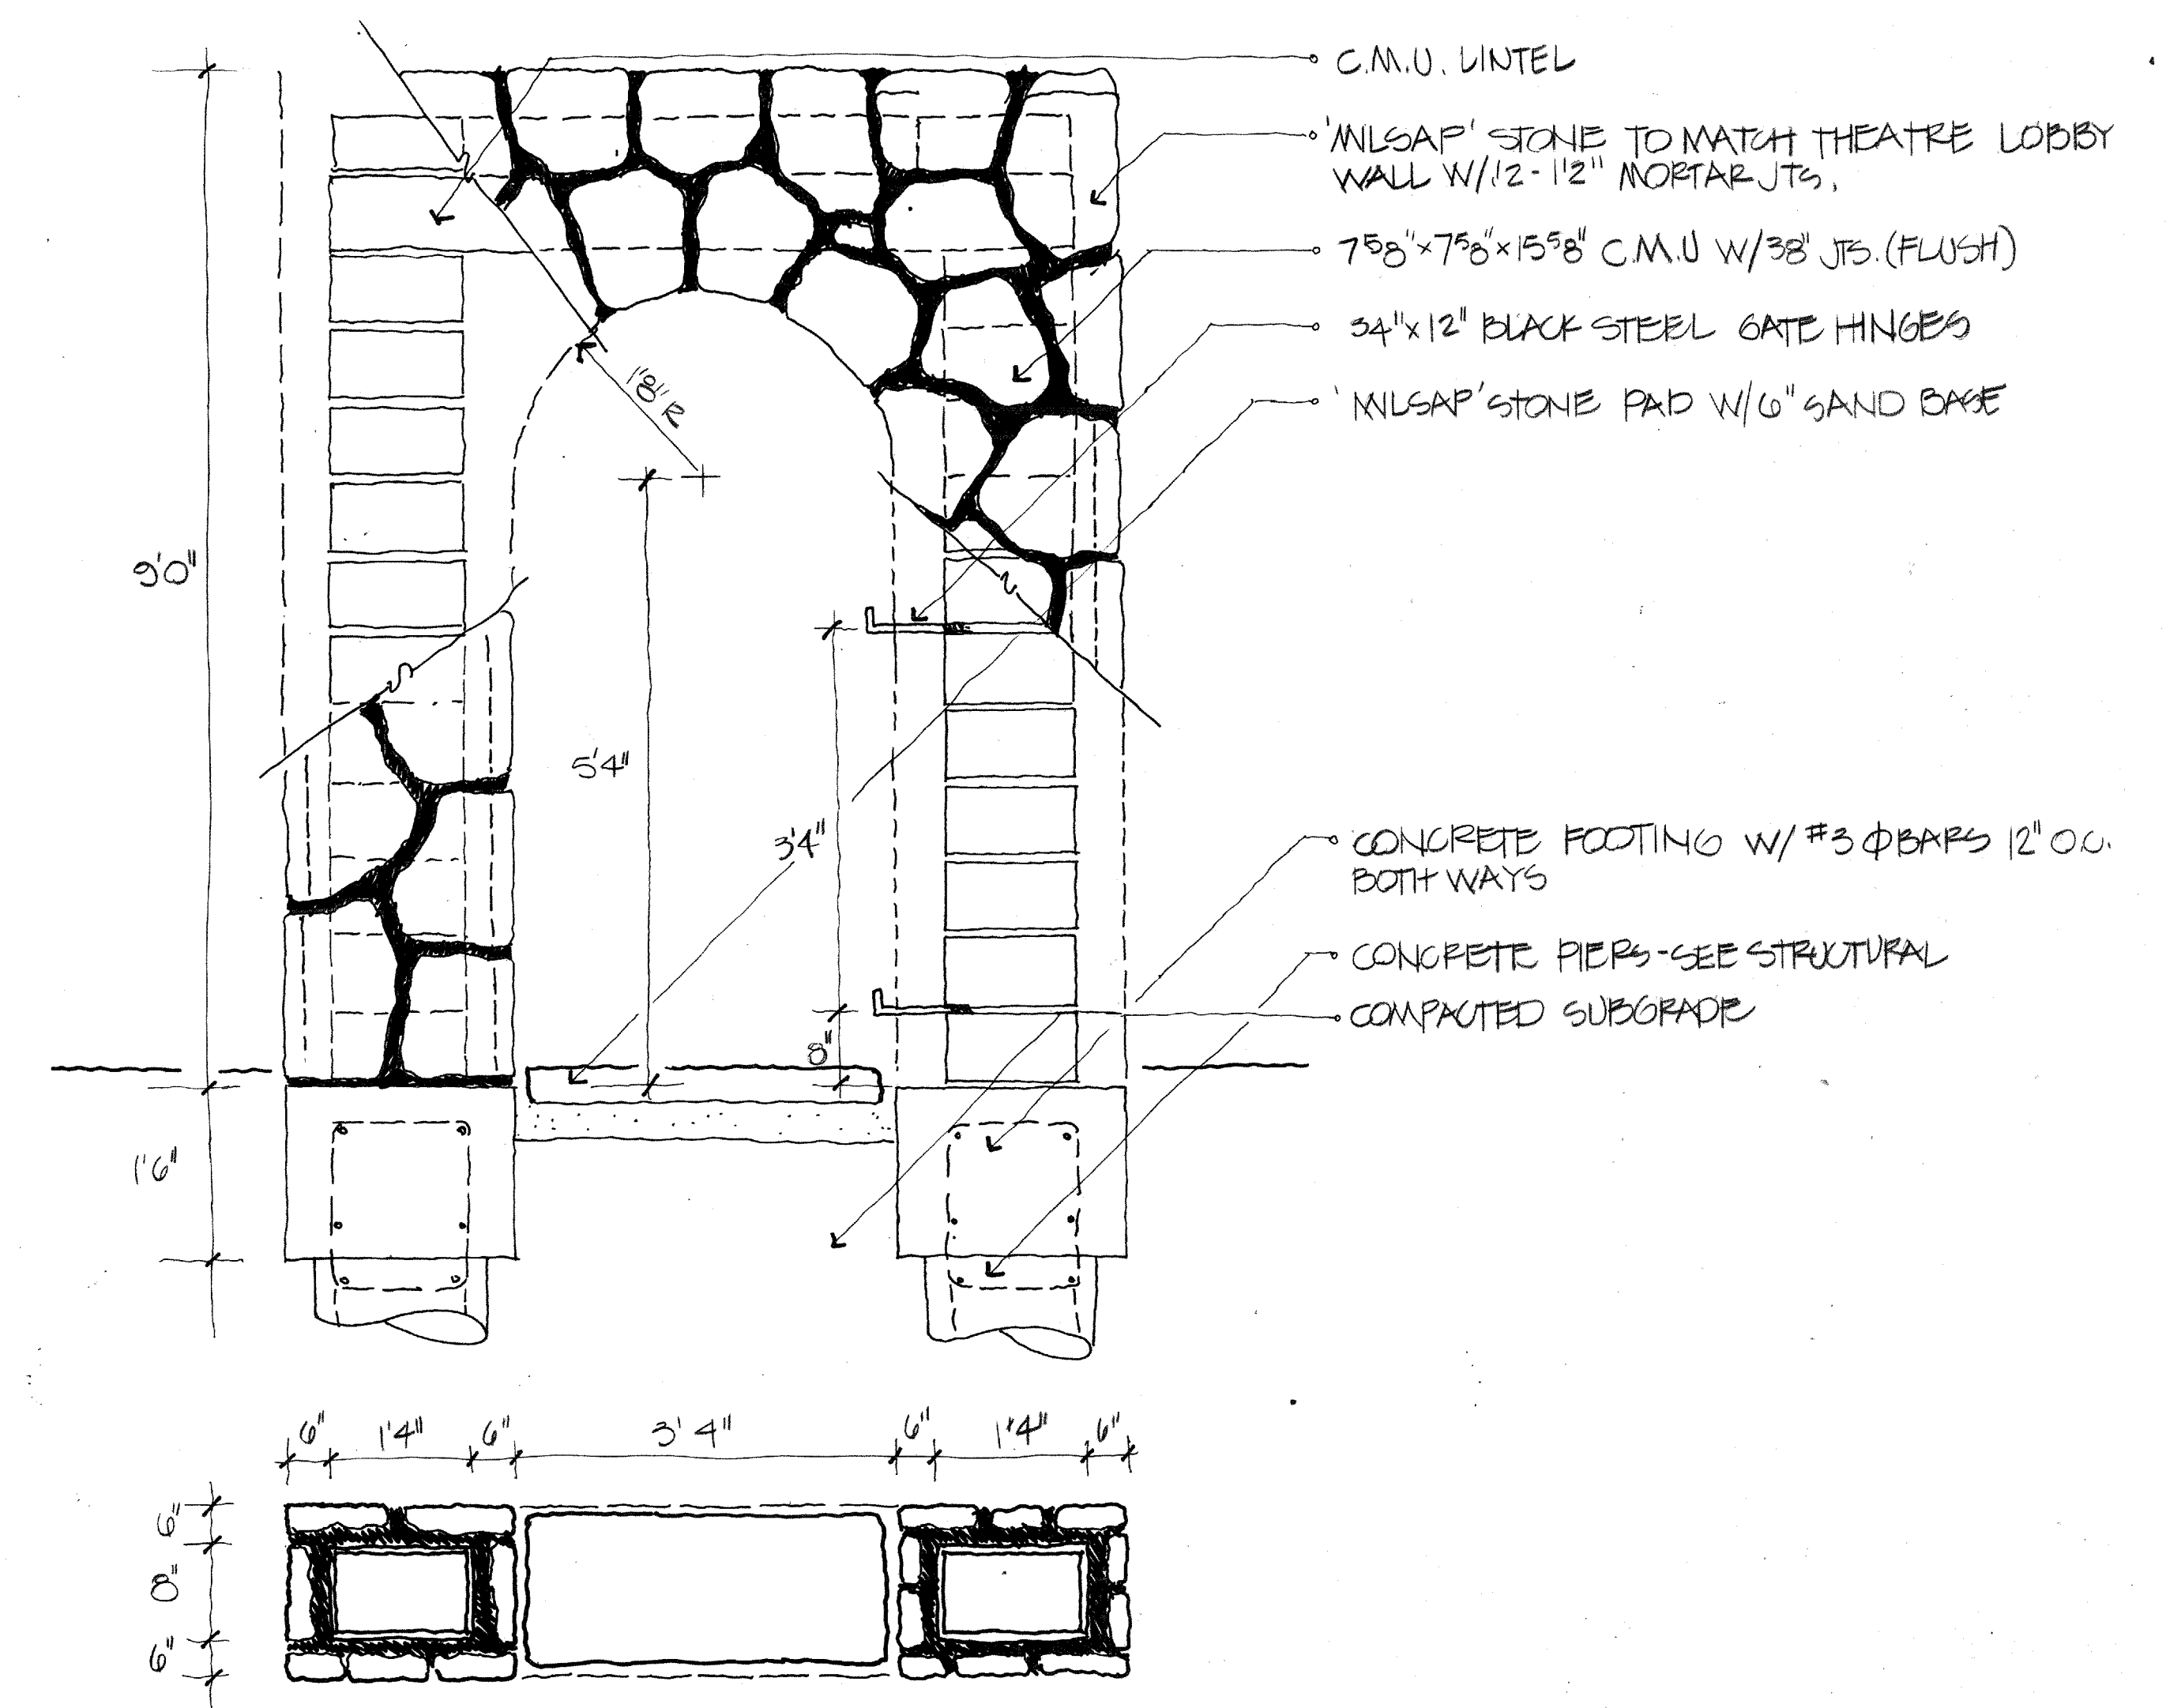

9 Stone Gate
N.I.C.



ACC ADDISON ACT

OWNER Town of Addison	LANDSCAPE The Kellams Group 317-76-1417	STRUCTURAL Ellisor Tanner 214-387-8393	HISTORIAN Alan Mason 214-691-7182	Issue ISSUE FOR BID 8-17-90	Category 2	Subcategory 3	Sheet 3
ARCHITECT Cunningham Architects 2700 Fairmount Dallas, Texas 75201 214-855-5272	THEATRE CONSULTANT Theatre Projects 203-431-3949	M.E.P. MEP Systems 214-754-4741	LIGHTING Pamela Hull Wilson 214-623-6542				
	INTERIORS CRSS 713-552-2000	CIVIL Kurtz & Associates 214-690-3322	GRAPHICS Notestad Design 214-954-1978				