




1 Stone Paving
12' x 10'

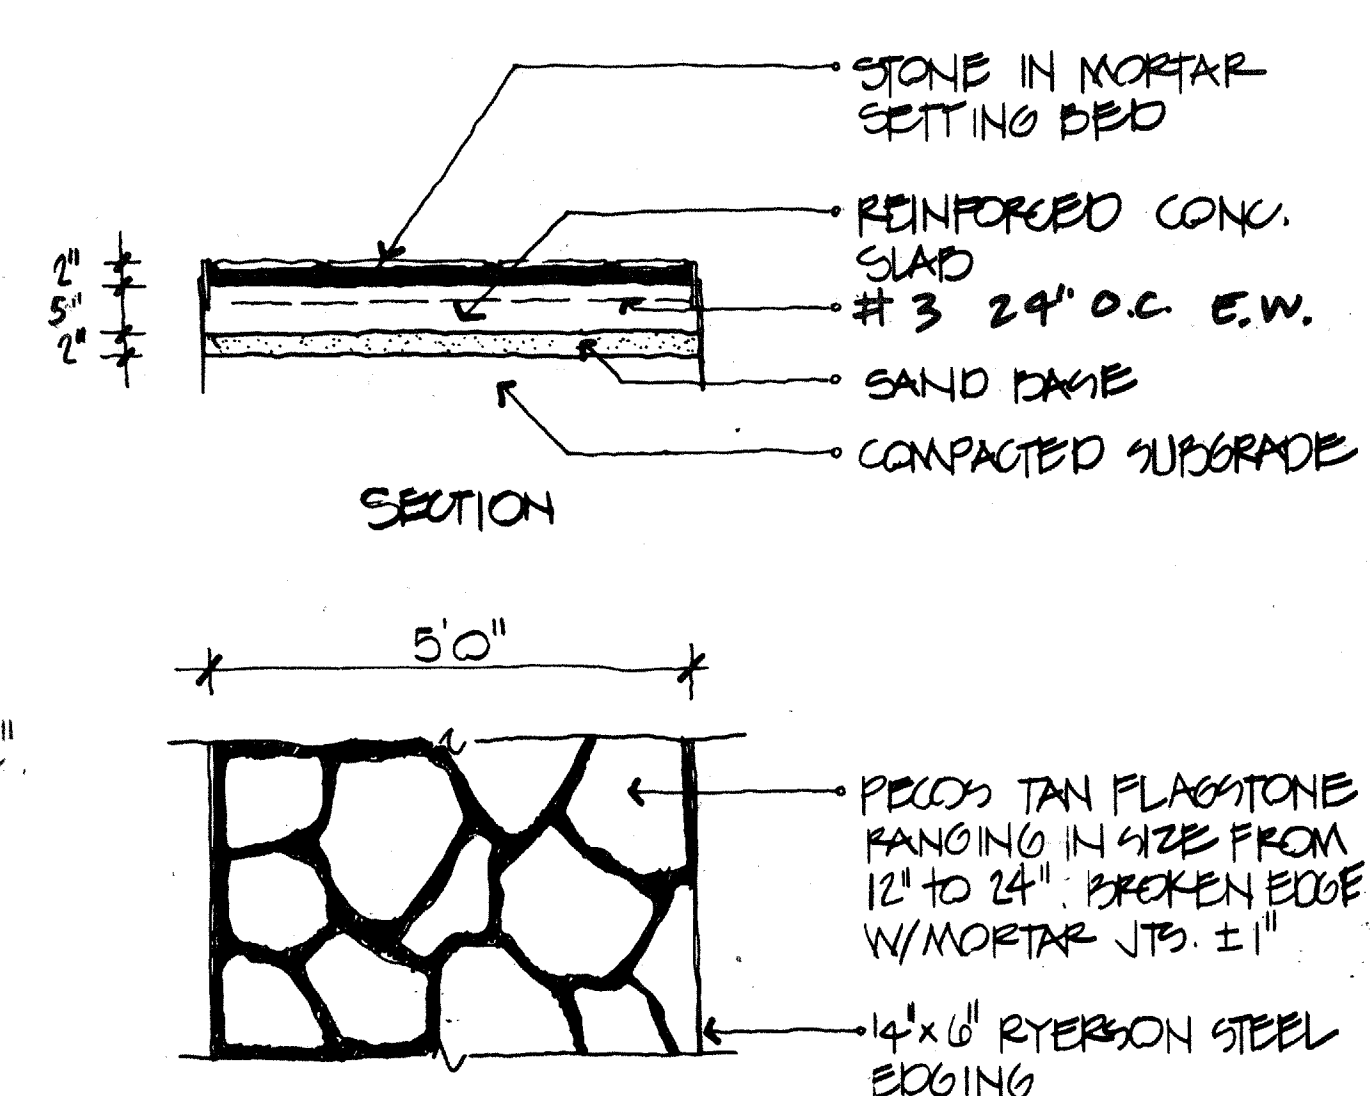


2 Stone Paving Cabaret N.I.C.
12' x 10'

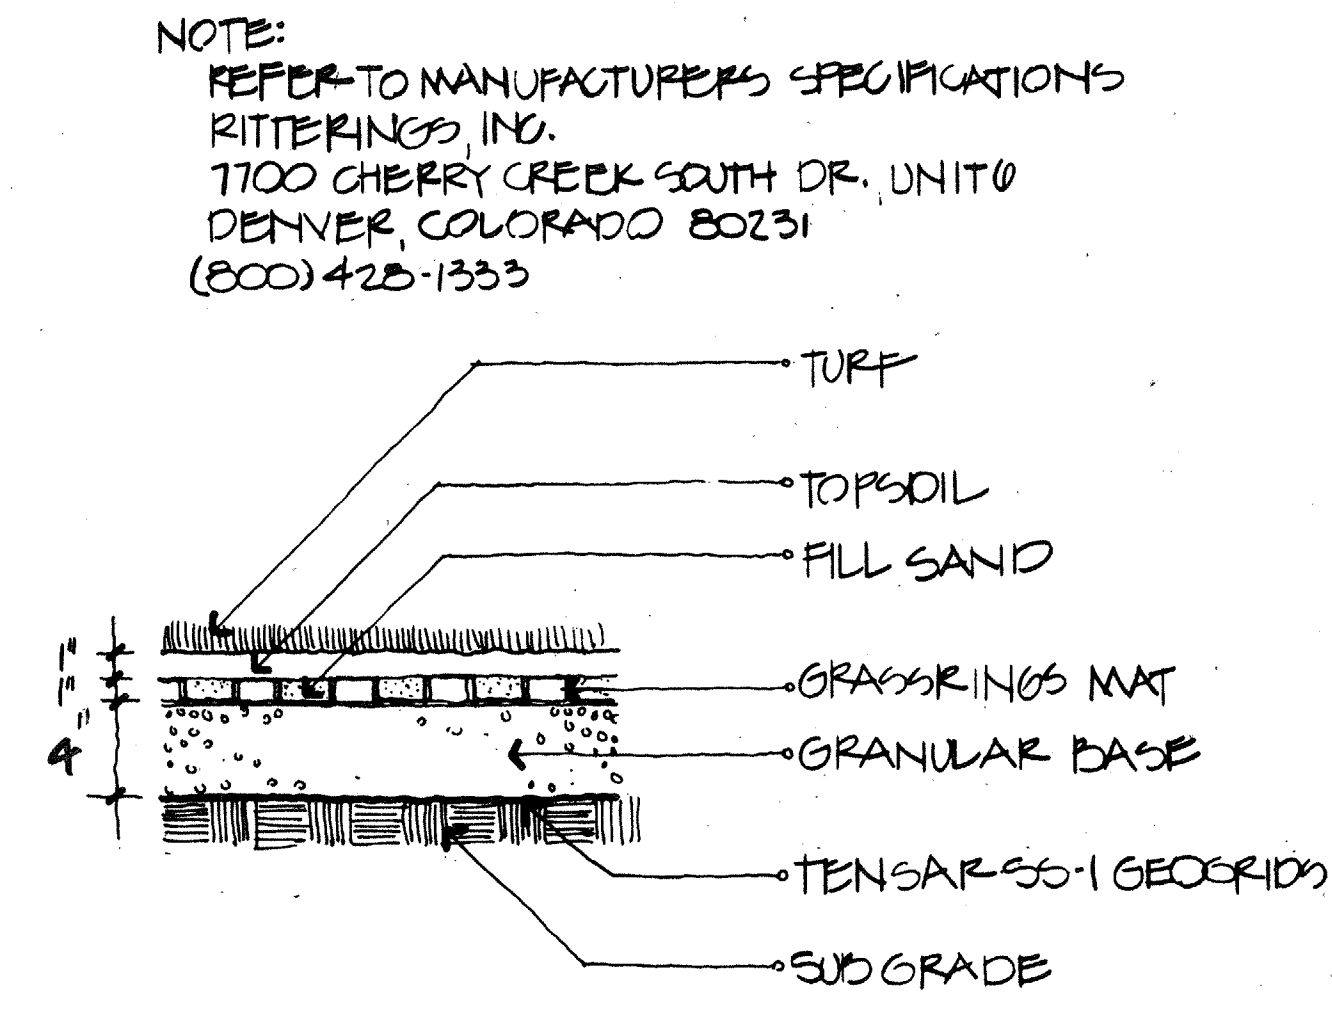


3 Turf Firelane
1/2' x 10'

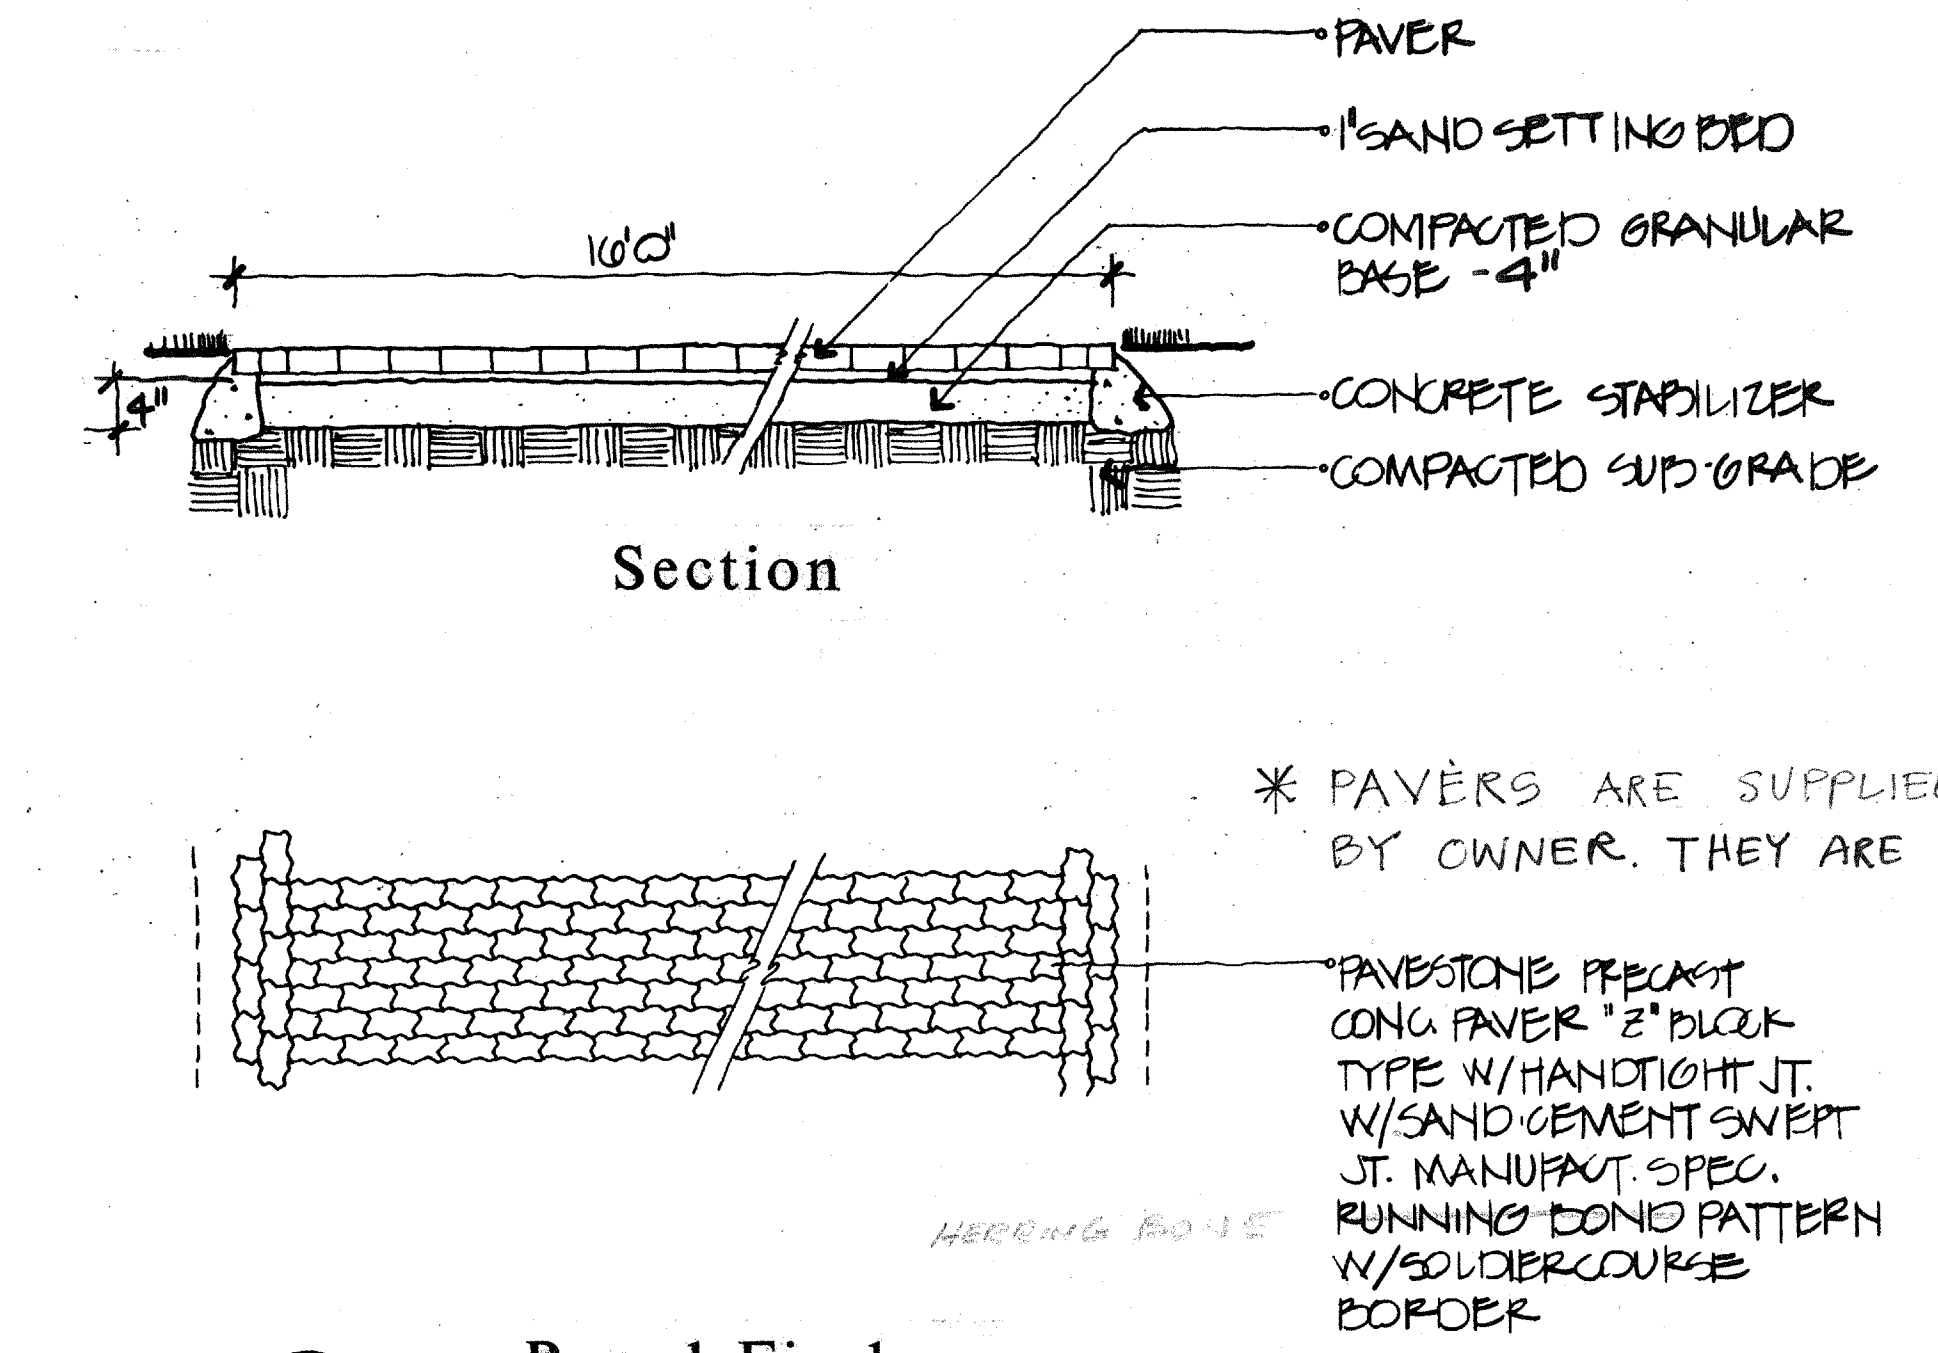


4 Paved Firelane
3/8' x 10'

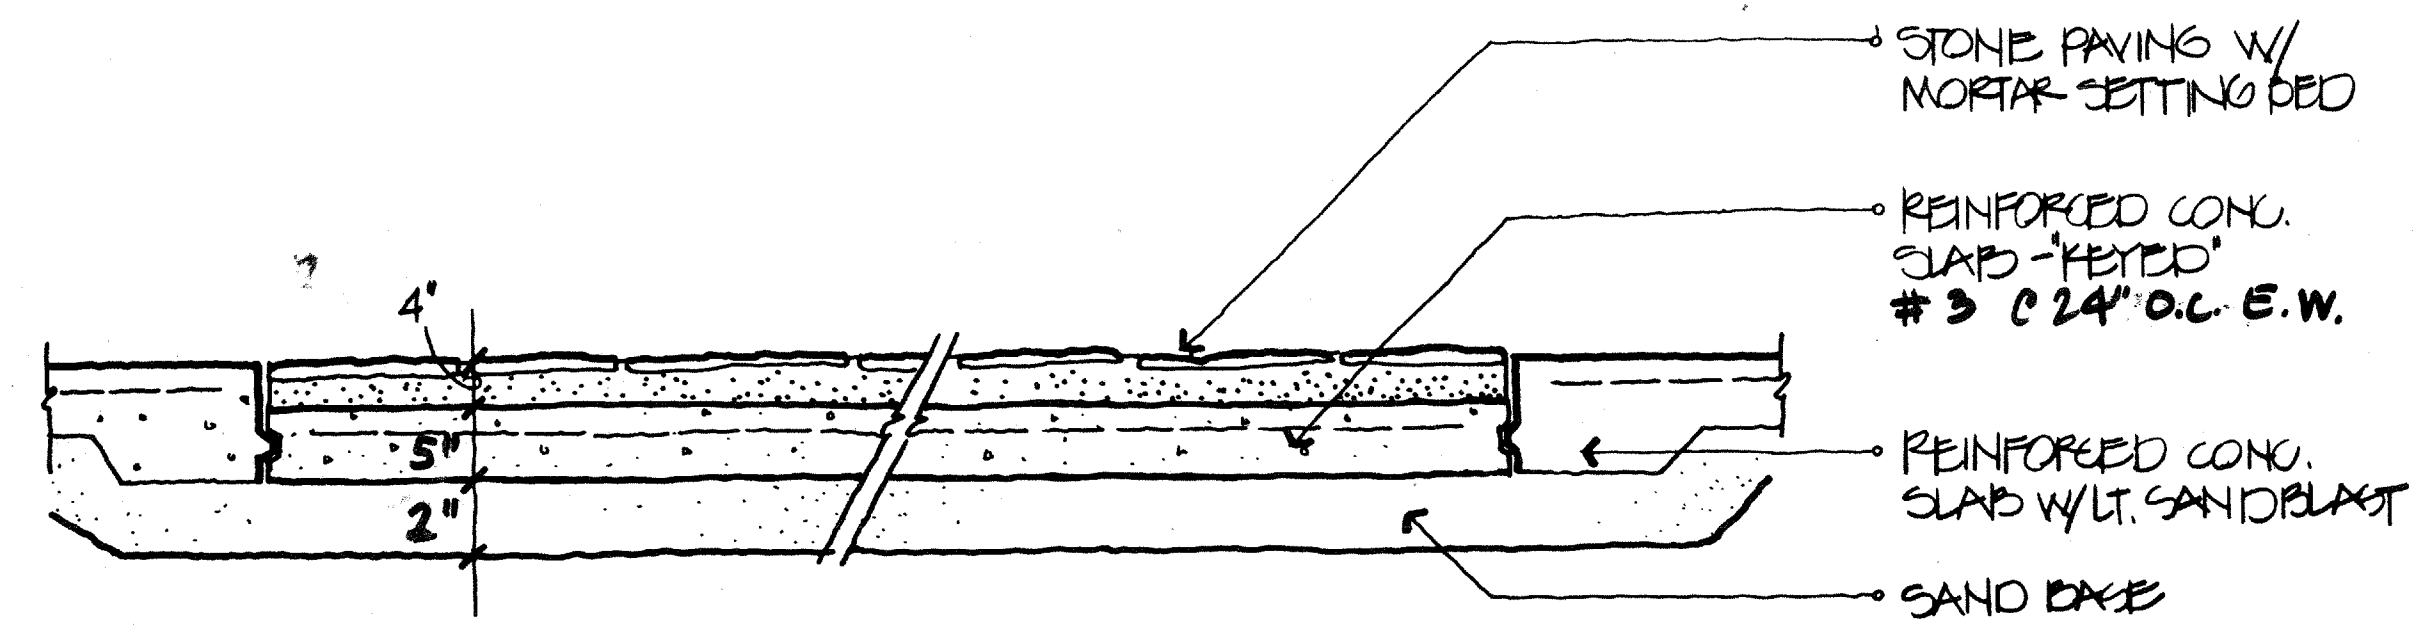


Section

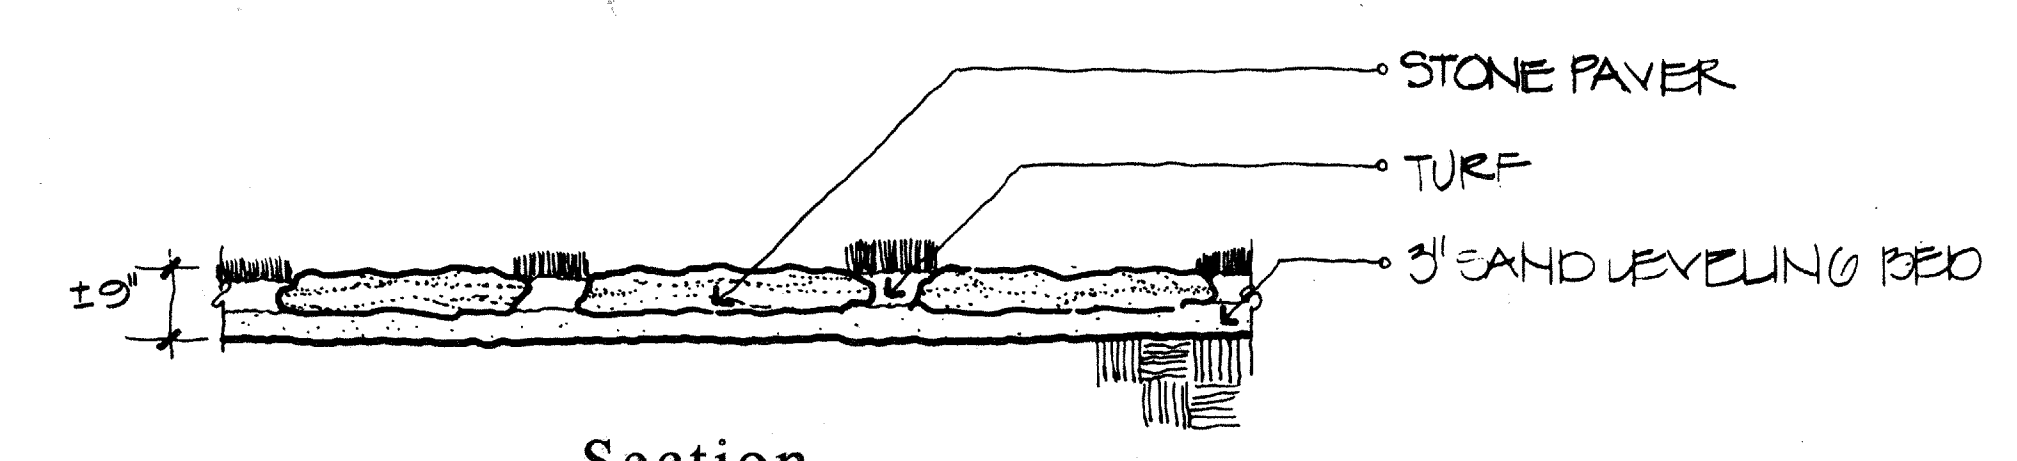


Section

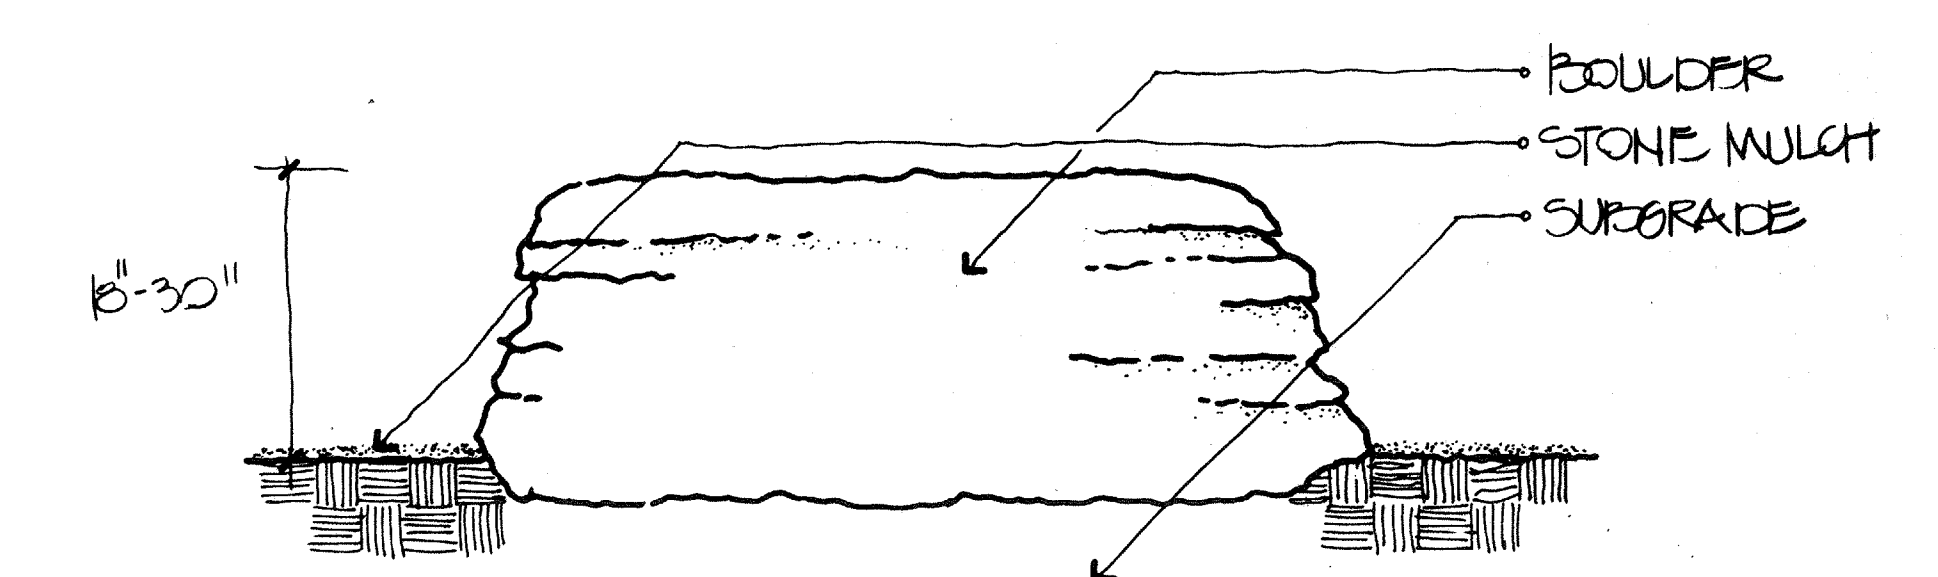


8 Stone Bench
1' x 10'

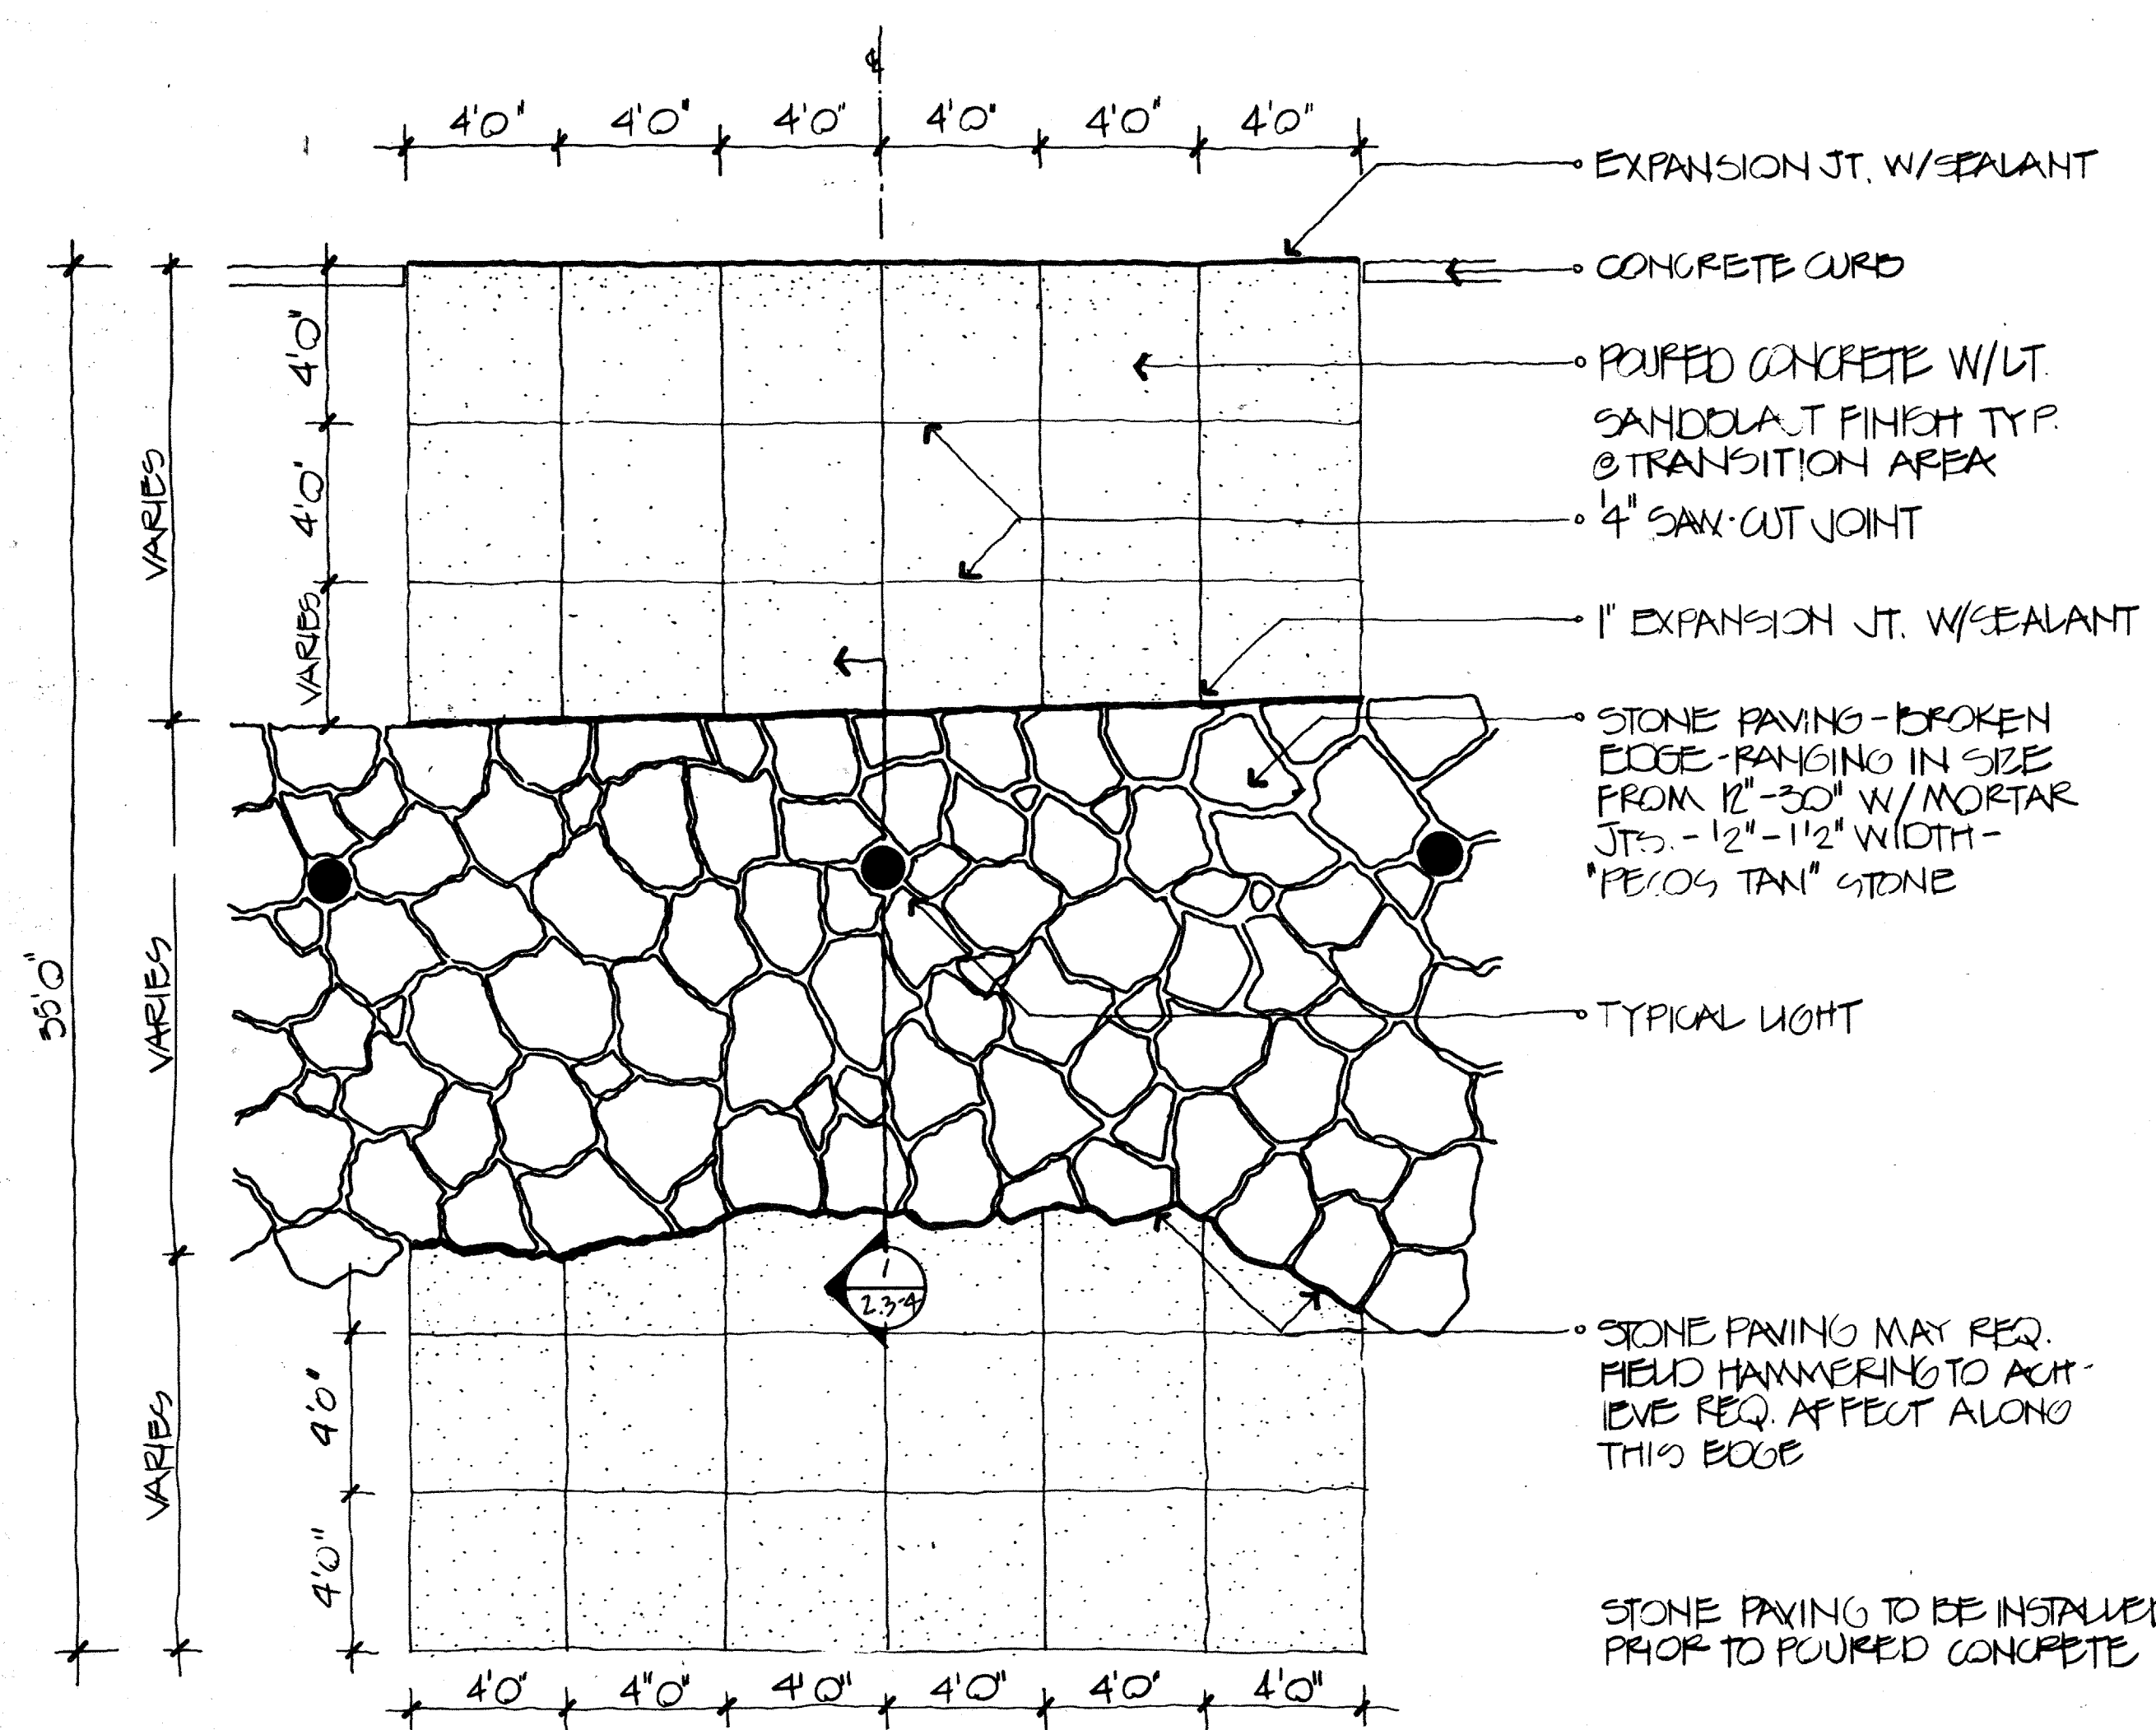

5 Transition Paving
14' x 10'

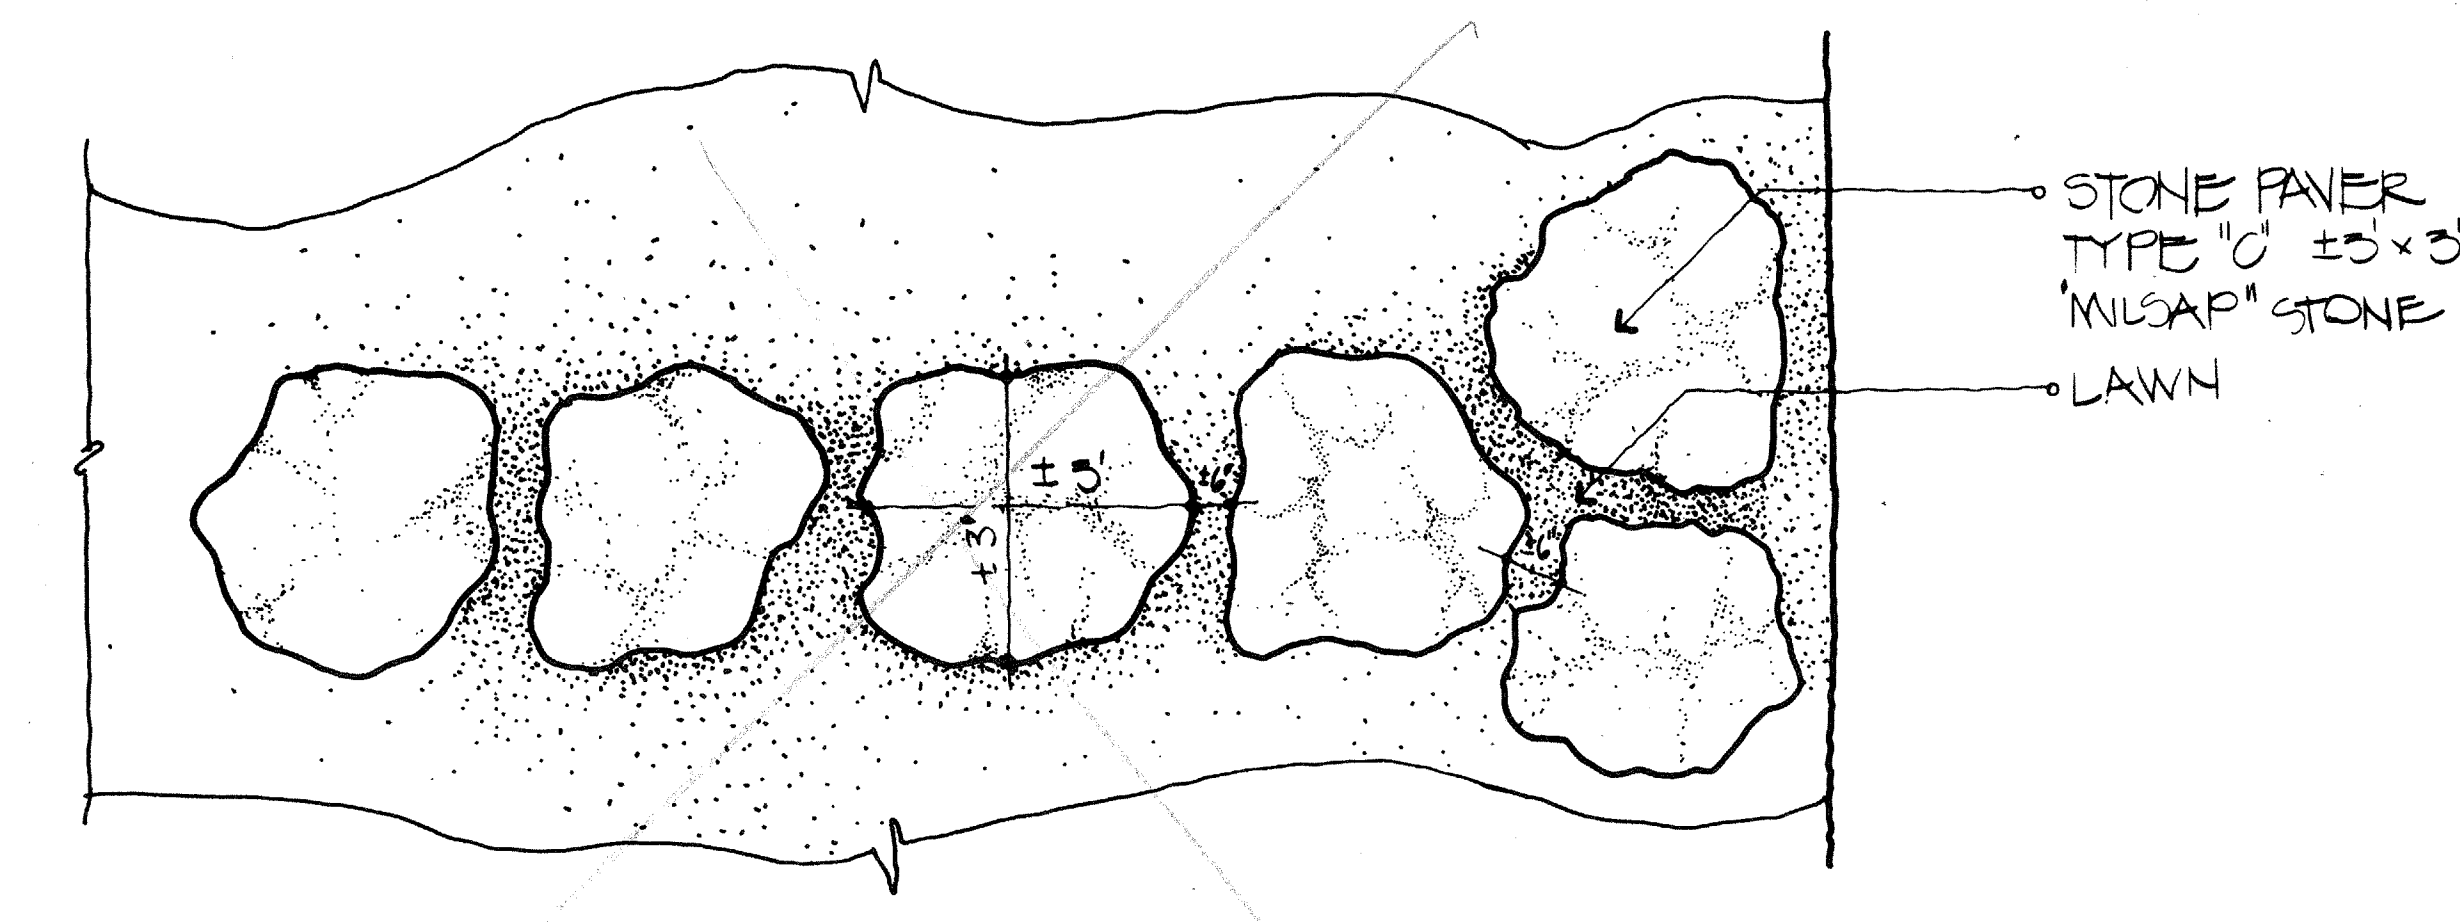


6 Stone Paving @ Lawn
12' x 10'

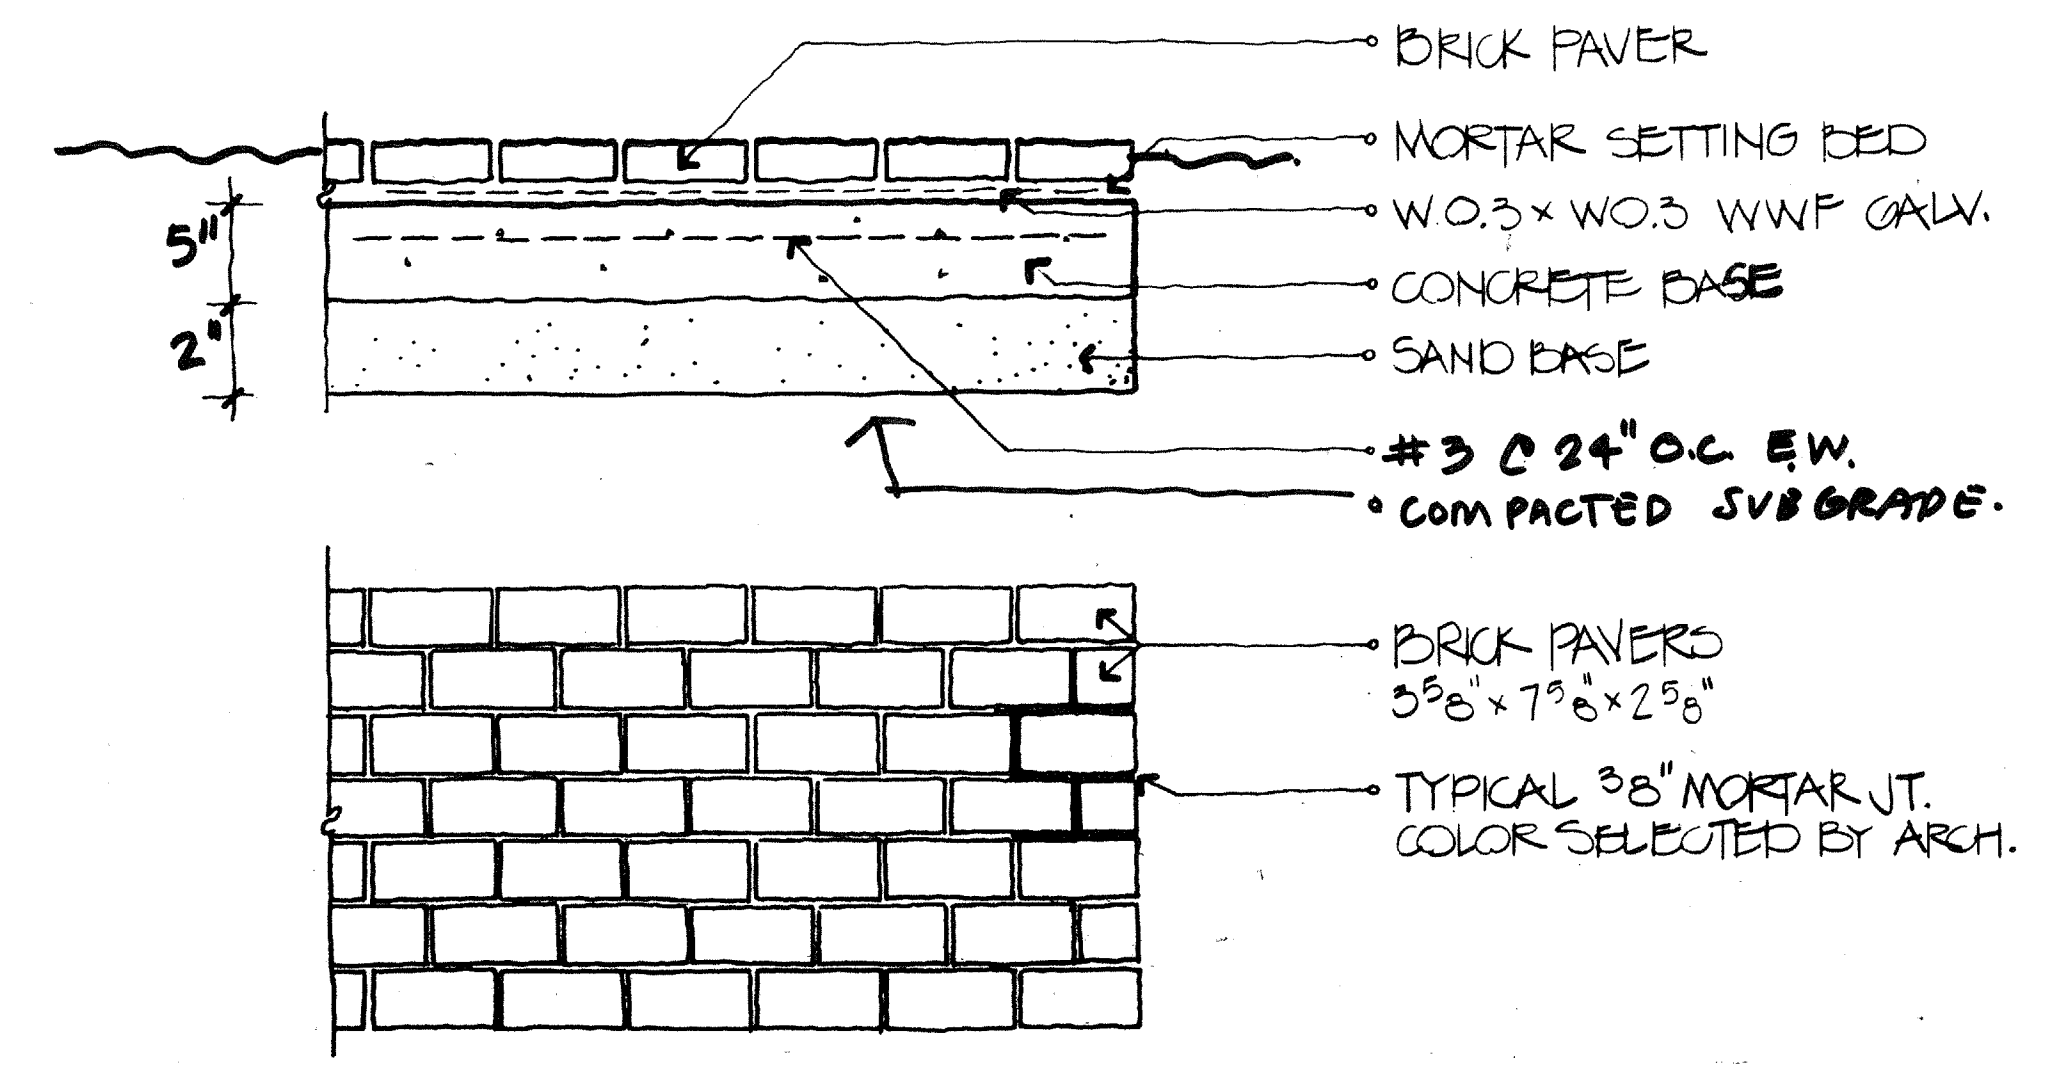

7 Brick Paving
11' x 10'

NOTE: LANDSCAPE WORK (SOFTSCAPE, EDGING, GRAVEL WORK AND IRRIGATION) IS NOT PART OF THIS CONTRACT. IT IS INCLUDED FOR INFORMATION AND COORDINATION PURPOSES ONLY.

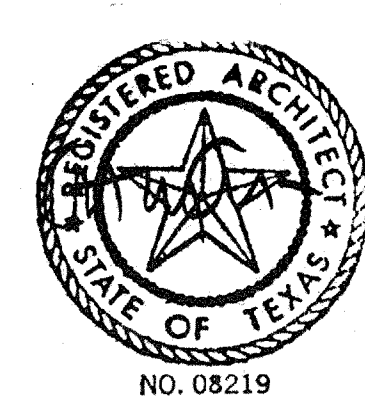

ACC ADDISON ACT

OWNER Town of Addison	LANDSCAPE The Killams Group 214-387-1417	STRUCTURAL Ellison Turner 214-387-8293	HISTORIAN Alan Mason 214-691-7182	Issue ISSUE FOR BID 8-17-00	Category 2	Subcategory 3	Sheet 4
ARCHITECT Cunningham Architects 2700 Fairmount Dallas, Texas 75201 214-855-5772	THEATRE CONSULTANT Theatre Projects 203-431-2849	M.E.P. MEP Systems 214-754-4741	LIGHTING Pamela Hull Wilson 214-823-6542				
INTERIOR CRSS 713-552-2000	CIVIL Kurtz & Associates 214-690-3322	GRAPHICS Nortestad Design 214-954-1978					