


THIS SHEET IS NOT PART OF THIS CONTRACT. INFORMATION IS PROVIDED FOR COORDINATION PURPOSES ONLY.

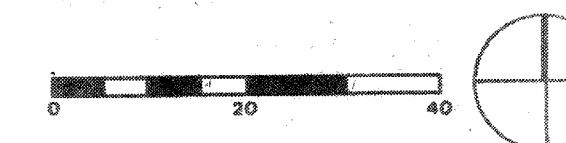

ACC ADDISON ACT

OWNER Town of Addison The Kellams Group 317776-1417	LANDSCAPE The Kellams Group 317776-1417	STRUCTURAL Ellisor Tanner 214-387-8393	HISTORIAN Alan Mason 214-691-7182	Issue ISSUE FOR BID 8-17-90	Category 2	Subcategory 5	Sheet 1
ARCHITECT Cunningham Architects 2700 Fairmount Dallas, Texas 75201 214-855-5272	THEATRE CONSULTANT Theatre Projects 203-431-3949	M.E.P. MEP Systems 214-754-4741	LIGHTING Pamela Hull Wilson 214-823-6542				
INTERIORS CRSS 713-552-2000	CIVIL Kurtz & Associates 214-690-3322	GRAPHICS Notestad Design 214-954-1978					