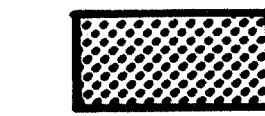



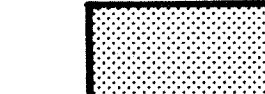


SEED/SOD/STOLONS



-  *Buchloe dactyloides* (seed 10 lbs/1000 sf)
Buffalograss
-  *Cynodon dactylon* 'Texturf 10'
(stolons 10-15 bushels/1000 sf)
-  *Cynodon dactylon* 'Tifgreen 328' (sod)
Tif Bermudagrass

MULCH

-  Crushed Granite (Decomposed Granite)
-  Granite Gravel

THIS SHEET IS NOT PART OF THIS CONTRACT.

INFORMATION IS PROVIDED FOR COORDINATION PURPOSES ONLY.

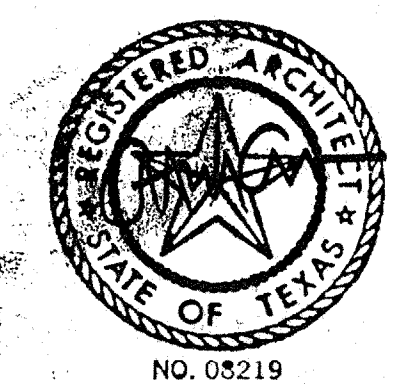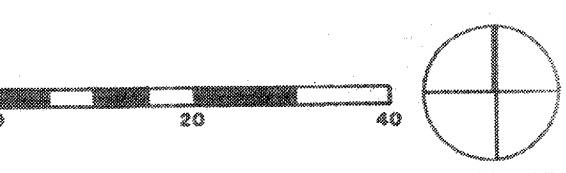

ACC ACT

OWNER	LANDSCAPE	STRUCTURAL	HISTORIAN	Issue	Category	Subcategory	Sheet
Town of Addison The Kellams Group 317-776-1417	The Kellams Group 317-776-1417	Ellisor Tanner 214-891-8293	Alan Mason 214-891-7882	ISSUE FOR BID 8-17-90	2	5	2
ARCHITECT Cunningham Architects 2703 Fairmount Dallas, Texas 75201 214-855-5272	THEATRE CONSULTANT Theatre Projects 203-431-3949	M.E.P. MEP Systems 214-754-4741	LIGHTING Pamela Hull Wilson 214-823-8542				
INTERIORS CRSS 713-552-2000	CIVIL Kurtz & Associates 214-690-3322	GRAPHICS Notestad Design 214-954-9378					