


- ~~OMIT SEE SPECS.~~
- ~~A3.3 MEN~~
 - ~~A4.3 WOMEN~~
 - ~~A6.1-2 TELEPHONE~~
 - ~~A7.1 REGISTRATION~~
 - ~~A12.1 BERRY~~
 - ~~A13.1 COLEMAN~~
 - ~~A14.1 NEEDHAM~~
 - ~~A15.1 MURPHY~~
 - ~~A16.1 ATKINS~~
 - ~~A10.1 KNOWLES~~
 - ~~A11.1 BRAMBLETT~~
 - ~~A17.1 CONFERENCE SERVICE~~
 - ~~B8.8 RESTROOM~~
 - ~~B14.1 (ADDRESS)~~
 - ~~B15.1-2 ADDISON CONFERENCE CENTER~~

CODE
 DIMENSIONAL LETTERS
 DIMENSIONAL LETTERS
 DIMENSIONAL LETTERS

~~OMIT.~~
 DIMENSIONAL LETTERS
 DIMENSIONAL LETTERS

1 GRAPHICS CONFERENCE

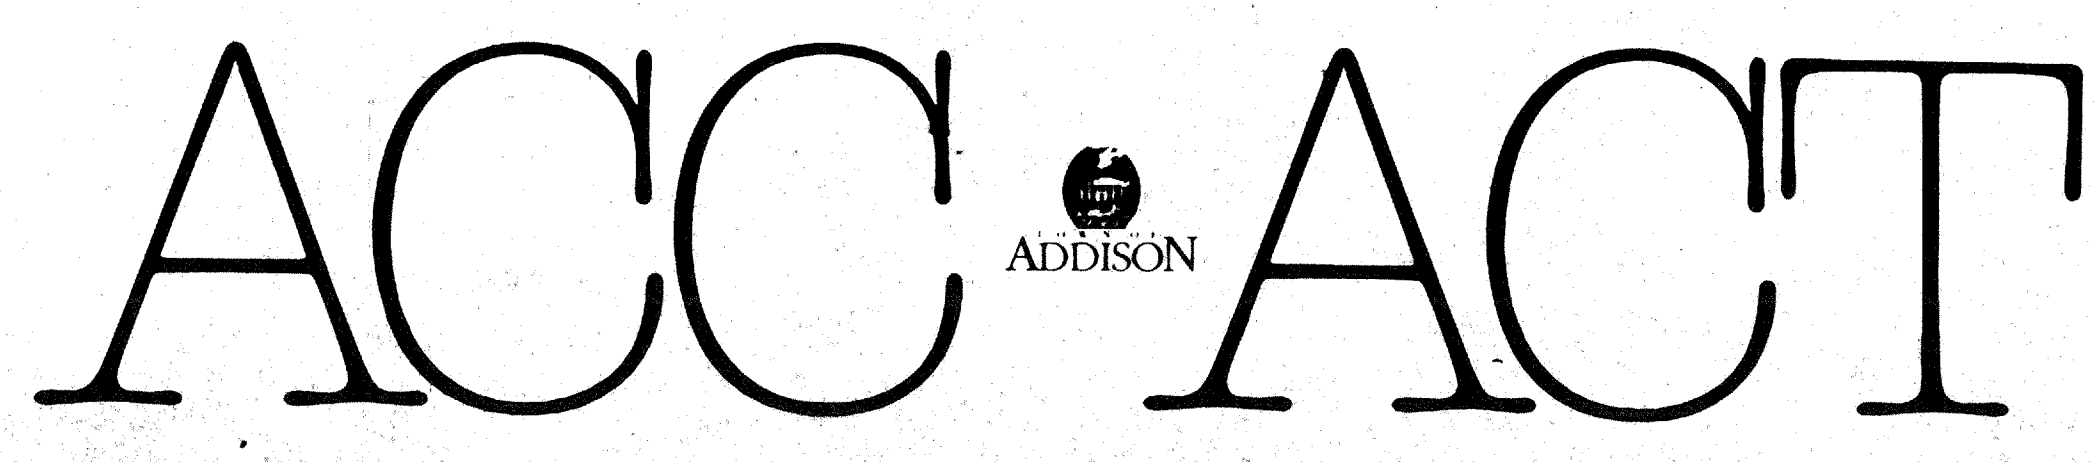

OWNER	LANDSCAPE	STRUCTURAL	HISTORIAN	Issue	Category	Subcategory	Sheet
Town of Addison Cunningham Architects 2700 Fairmount Dallas, Texas 75201 214-855-5272	The Kellams Group 317-716-1417	Ellisor Tanner 214-387-8393	Alan Mason 214-691-7182	ISSUE FOR BID 8-17-90	11	2	2
ARCHITECT	THEATRE CONSULTANT	M.E.P.	LIGHTING				
	203-431-3949	M.E.P. Systems 214-754-4741	Pamela Hull Wilson 214-823-6542				
INTERIORS	CIVIL	GRAPHICS					
ORS 713-552-2000	Kurtz & Associates 214-690-3322	Notated Design 214-954-1878					