


- NOTES :
1. NEED PARKING LAYOUT
 2. REVISE 2ND FLR TO SHOW CORRIDOR EXTENSION
 3. NEED STAIR DETAIL FOR 2ND FLR STAIR
 4. REVISE 1ST FLR TOILET AREA
 5. IF BLDG LOCATION IS CHANGED NEED REVISED SITE PLAN
 6. SEE NOTES ON ATTACHED SPECS
 7. SEE NOTES ON VARIOUS SHEETS
 8. INTERIOR FINISHES MUST COMPLY W/ CH. 42.0 BC
- TYPE I - N CONST / B-2 OCCUPANCY
 CITY OF ADDISON

BUILDING INSPECTION DEPARTMENT

DEPARTMENT	IN	DATE	CUT	APPROVED / HOLD	INITIAL	COMMENTS
INSPECTION		3/7	✓		DP	SEE NOTES OK FOR CON. ALL UTILITIES ARE DALLAS
PUBLIC WORKS						
ZONING						
FIRE		2/16	✓		ME	SEE NOTES
TRAFFIC						
ENGINEERING						
HEALTH						
ELECTRICAL						
TAX						

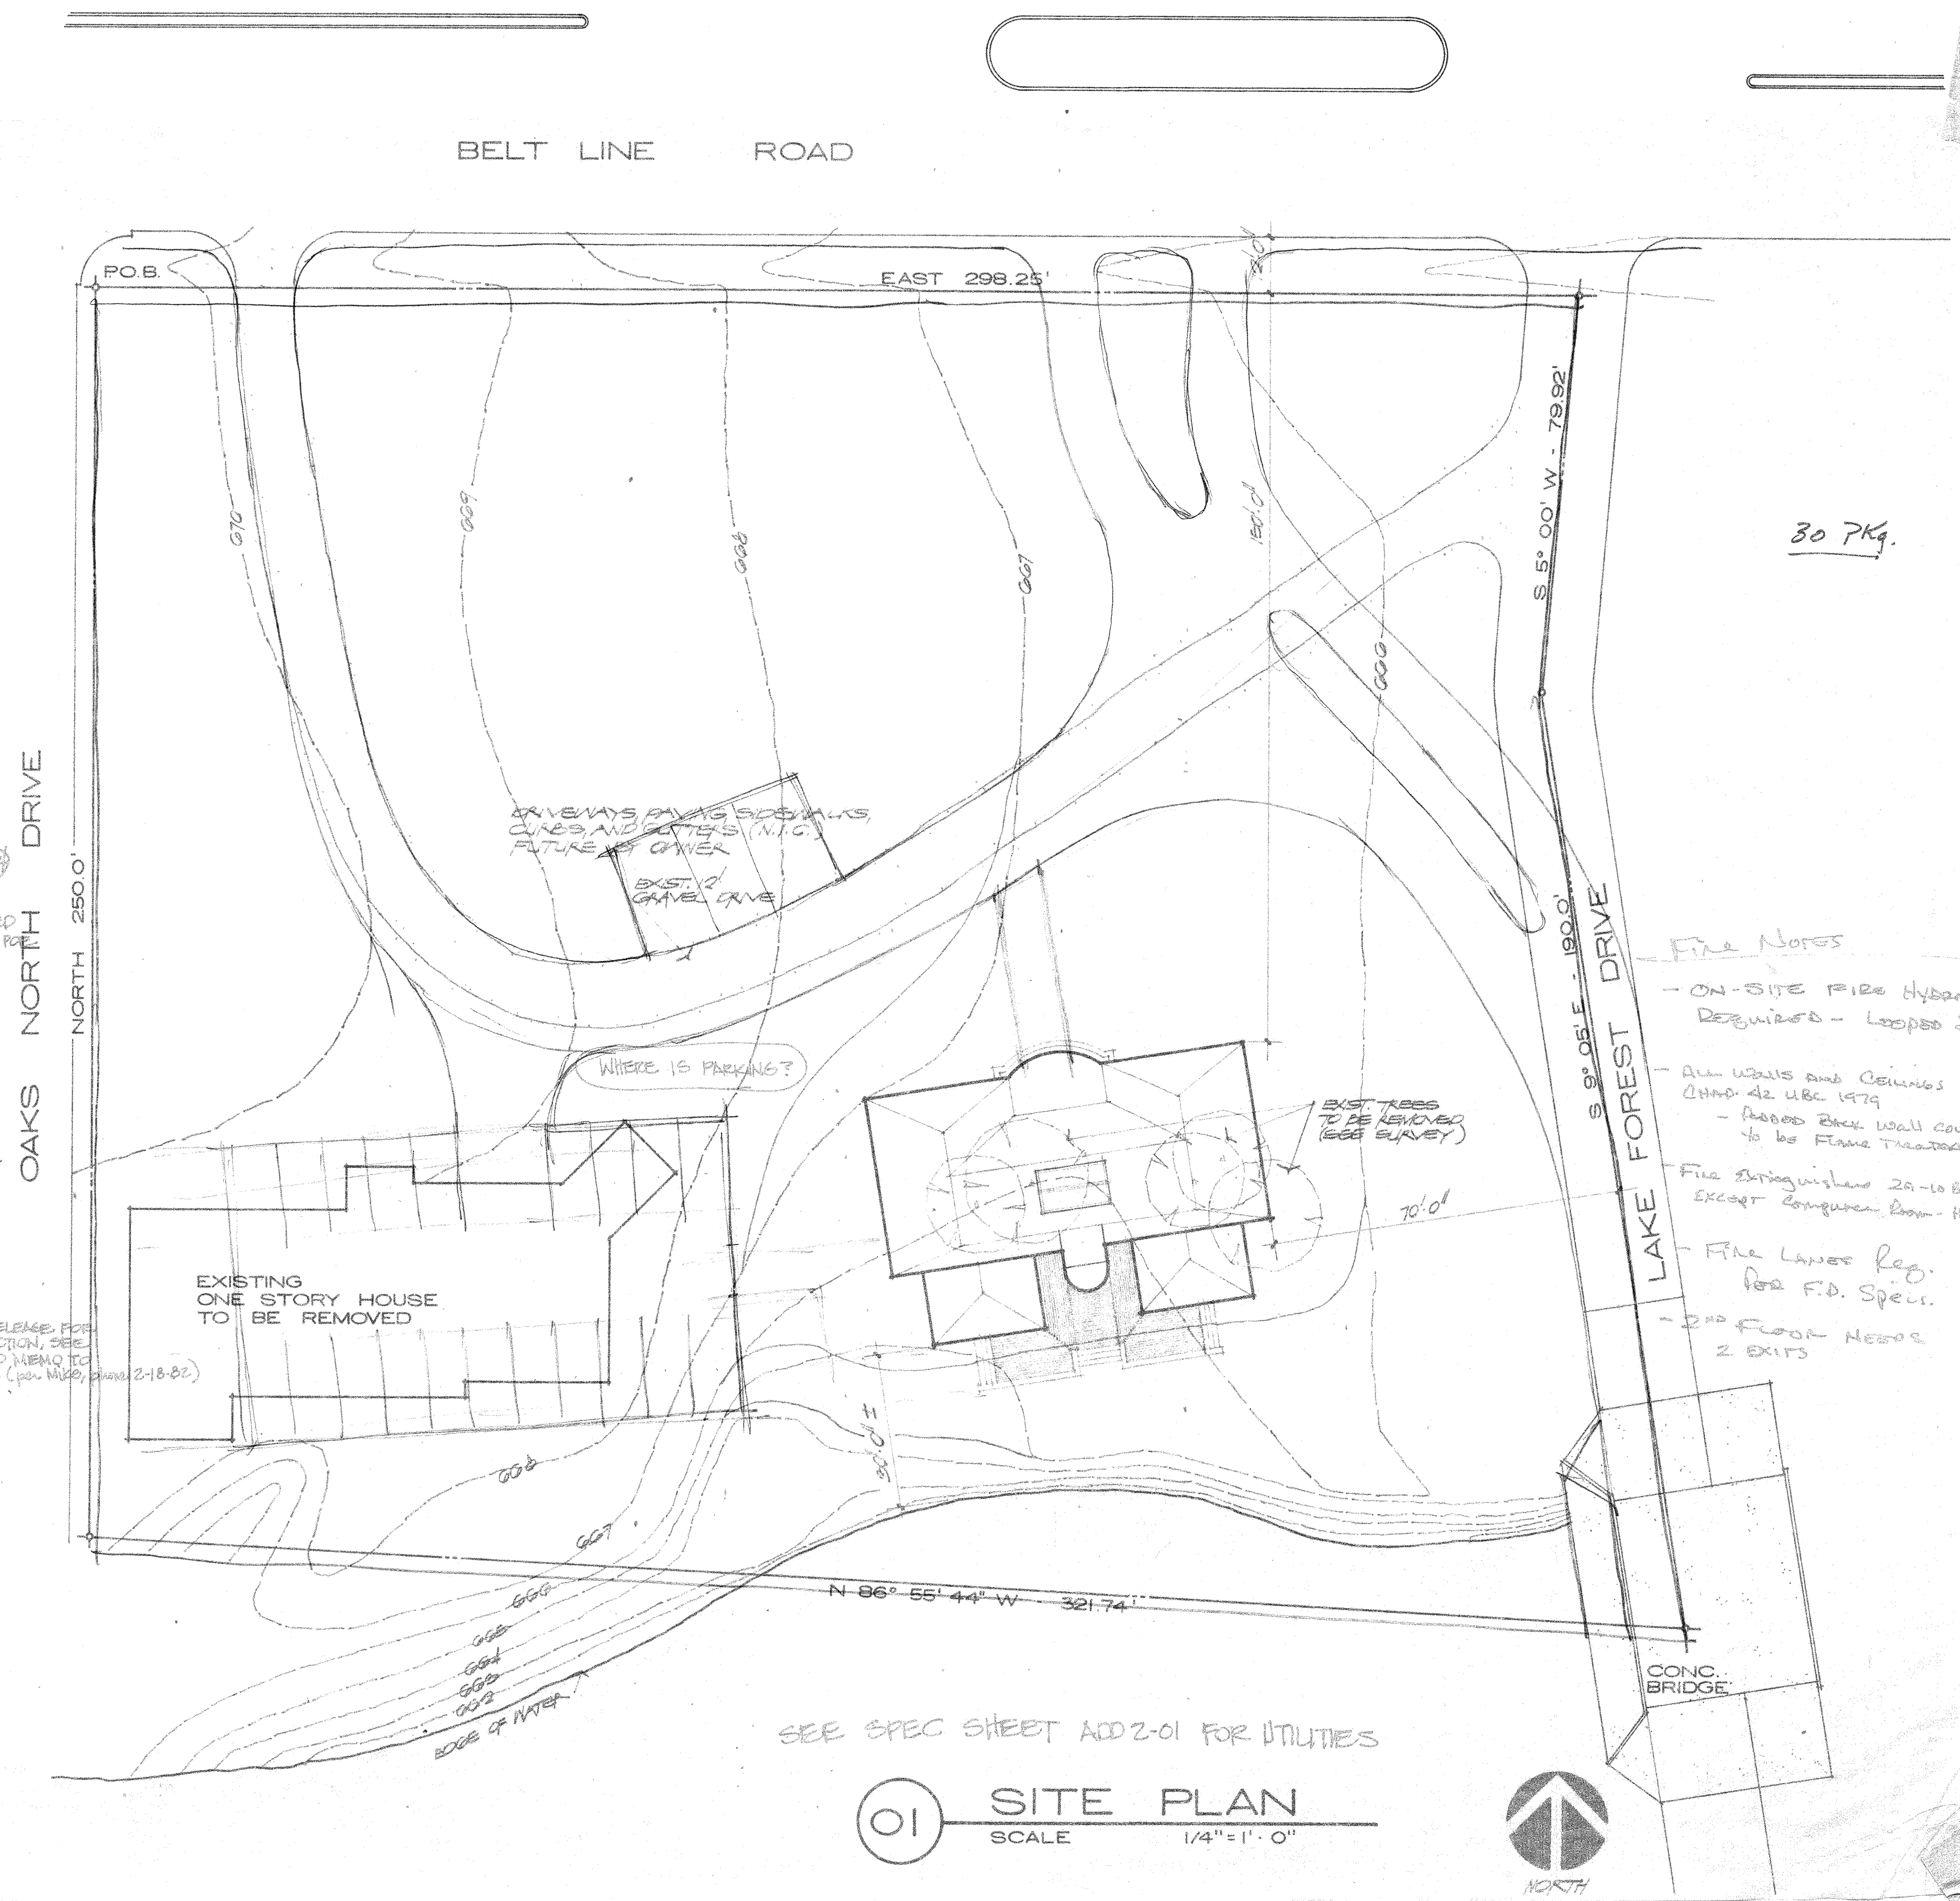

NEW GRADE CONTOUR

EXIST. GRADE CONTOUR

EXIST. TREE TO BE REMOVED

- File Notes
- ON-SITE FIRE HYDRANT REQUIRED - LOOPS
 - ALL WALLS AND CEILING PER CHAP. 42.0 BC 1979
 - ASBESTOS BACK WALL COVER TO BE FIBER TREATING
 - Fire Sprinklers 20-10 BC EXCEPT CONCRETE ROOM - 1A
 - File Lower Reg. FOR F.D. SPEC.
 - 2ND FLOOR NEEDS 2 EXITS

OK TO RELEASE FOR CONSTRUCTION, SEE ATTACHED MEMO TO JIM POB (per Mike, dated 2-18-82)

HOLD FOR THESE ITEMS

SEE ATTACHED MEMO TO JIM POB