
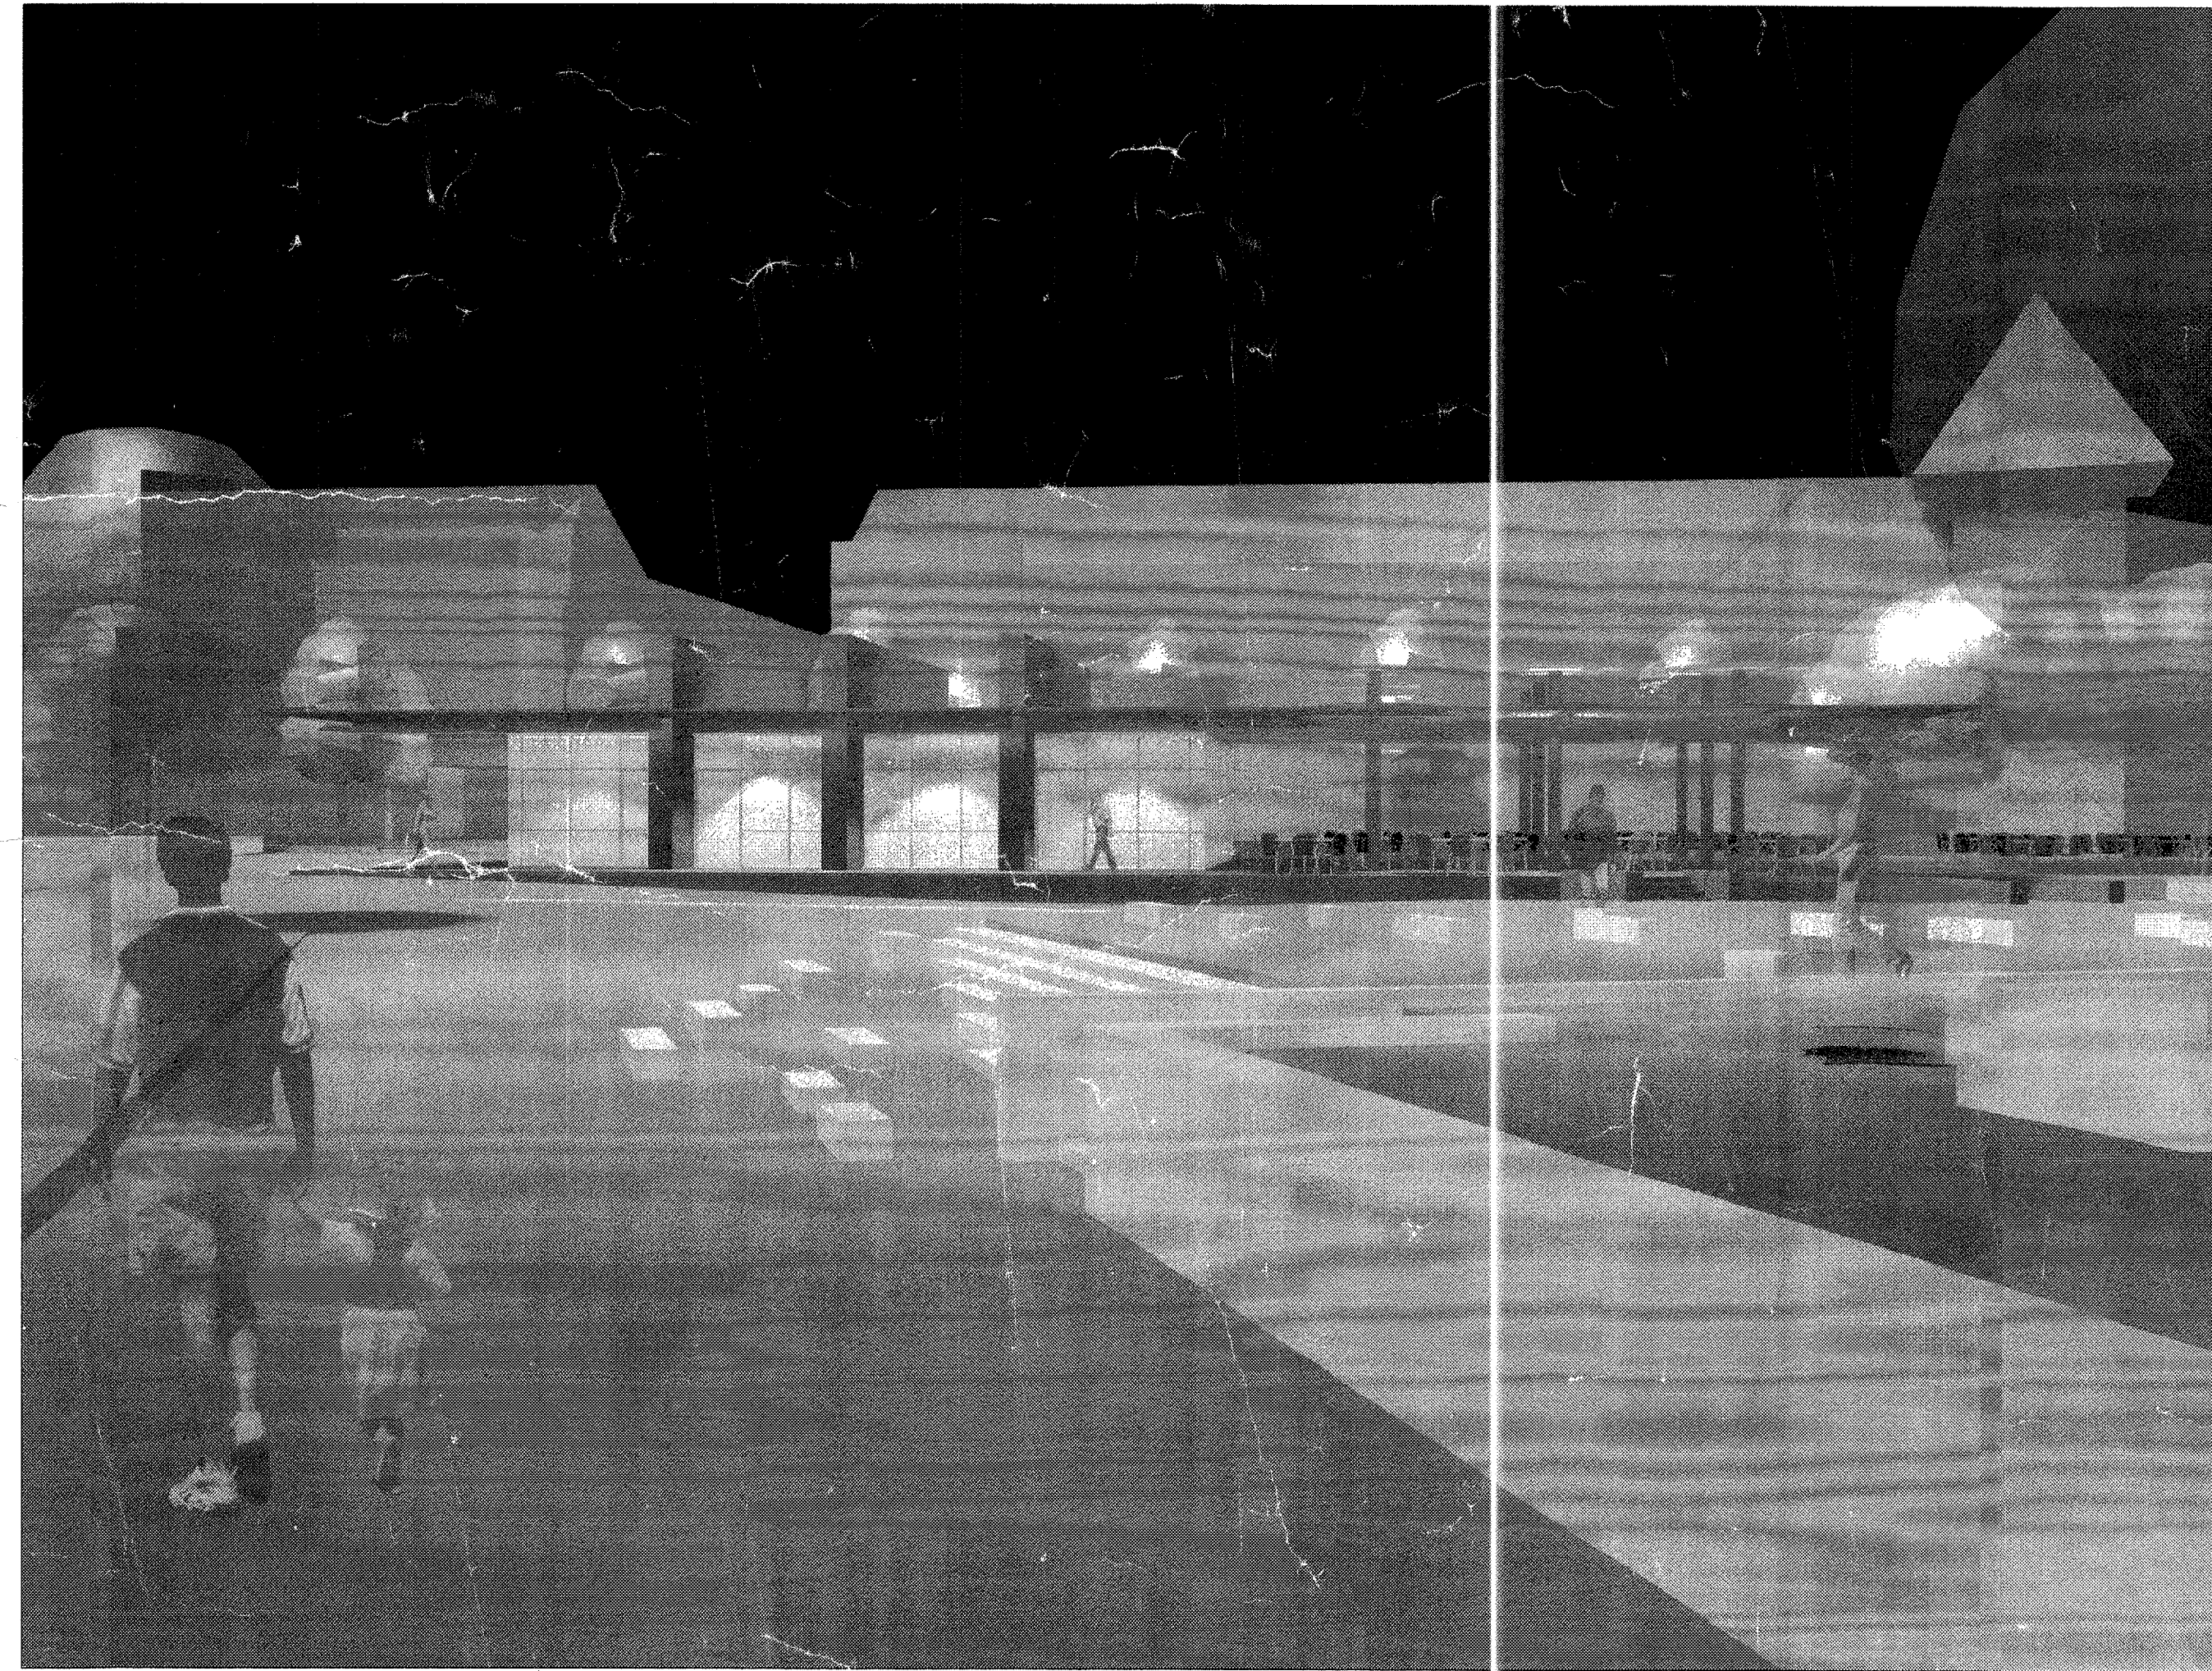


AS BUILTS. DO NOT
Remove From Office!

cunningham
architects
918 Dragon Street
Dallas, Texas 75207
Phone: 214.760.0000
Fax: 214.815.0901

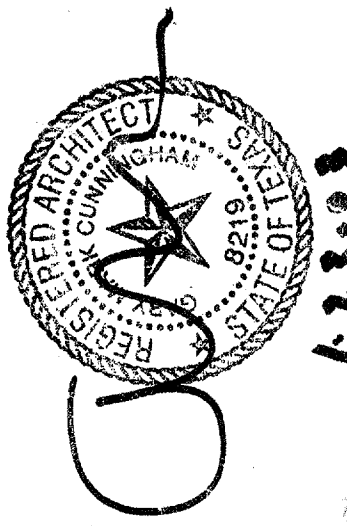


ADDISON ARTS & EVENTS DISTRICT
PAVILION

TABLE OF CONTENTS

S1.0	NOTES/DETAILS
S2.0	FOUNDATION PLAN
S2.1	ROOF FRAMING PLAN
S3.0	TYPICAL DETAILS & SECTIONS
S3.1	STEEL SECTIONS & DETAILS
A1.0	FLOOR PLAN
A2.0	ROOF PLAN / REFLECTED CEILING PLAN
A2.1	ENLARGED PLANS
A3.0	EXTERIOR ELEVATIONS
A4.0	BUILDING SECTIONS
A5.0	WALL SECTIONS
A5.1	NOT USED
A6.0	DOOR TYPES & SCHEDULES
A6.1	WINDOW TYPES
A6.2	WINDOW TYPES
A7.0	INTERIOR ELEVATIONS: MENS ROOM
A7.1	INTERIOR ELEVATIONS: WOMENS ROOM
A7.2	INTERIOR ELEVATIONS: KITCHEN
A8.0	DETAILS
A8.1	DETAILS
A8.2	DETAILS
FS1.0	FOOD SERVICE EQUIP PLAN
FS2.0	FOOD SERVICE ELEVATIONS
FSMEP1	FOOD SERVICE MEP
M1.0	HVAC PLAN
M2.0	MECHANICAL NOTES
E1.0	ELECTRICAL
E2.0	ELECTRICAL
E2.1	KITCHEN ELECTRICAL
E3.0	ELECTRICAL NOTES & DETAILS
E3.1	NOTES & SCHEDULES
P1.0	PLUMBING PLAN

SITE LOCATION

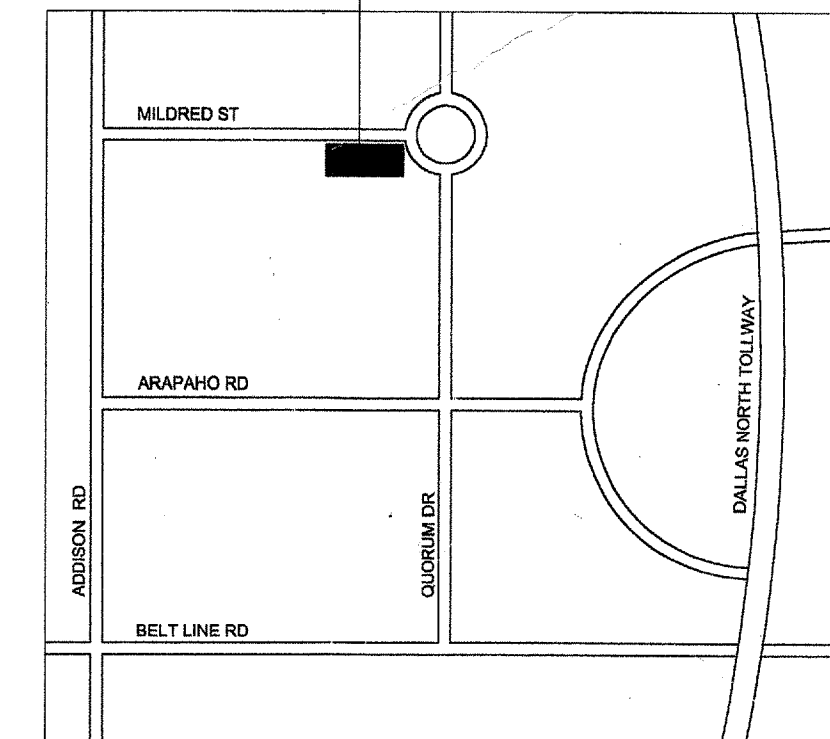

**Addison Arts and
Events Pavilion**
4570 Addison Circle Drive
Addison, Texas

16

date
08/28/02
01/09/02
01/23/03
sheet
DD & CD
12/24/02