



TYPE	BRAND	MODEL NO.	DESCRIPTION	LAMP	VOLTAGE	LOCATION
A	KIM	CFL/SOMH120/DB-P	SURFACE MOUNTED METAL HALIDE FLOOD LIGHT, BLACK POLYESTER POWDER COAT FINISH, 1/2 CYLINDER SHAPE 10-1/2"Ø	1-50W CLEAR METAL HALIDE	120V	ON ROOF
A-1	KIM	AFL-1/175MH120/DB-P	SURFACE MOUNTED METAL HALIDE FLOOD LIGHT, BLACK POLYESTER POWDER COAT FINISH, 1/2 CYLINDER SHAPE 14"x10-3/4"	1-175W CLEAR METAL HALIDE	120V	ON ROOF
B	NOT USED					
C	COLUMBIA	4PS14232G RA A12 EBB	RECESSED FLUORESCENT 1x4 WITH ACRYLIC LENS, FOR INSTALLATION IN 2x4 LAY-IN CEILING. RECESSED ALUMINUM FRAME, WITH ELECTRONIC BALLAST.	2-F32T8	120V	KITCHEN
C-1	COLUMBIA	4PS14132G RA A12 EBB	SIMILAR TO TYPE C, EXCEPT FOR ONE LAMP WIDE.	1-F32T8	120V	KITCHEN
D	NOT USED					
E	NOT USED					
F	HUBBELL	232B	SURFACE MOUNTED FLUORESCENT STRIP, 2 LAMPS WIDE 4'-0" LONG, ELECTRONIC BALLAST, WITH WIRE GUARD.	2-F32T8	120V	ELECTRIC ROOM
G	NOT USED					
H	NOT USED					
I	NOT USED					
J	NOT USED					
K	ALERA	CL121T8F WCB EBB	RECESSED CONTINUOUS FLUORESCENT, 1'-0" WIDE, LENGTH AS SHOWN ON DRAWINGS, WITH 1" WHITE BLADE LOUVER, 1" O.C.	1-32W T8 PER 4'-0" ELECTRONIC BALLAST	120V	TOILET
L	KIM	WF20P70WMMH120 BL-P	SURFACE MOUNTED METAL HALIDE WITH PRISMED LENS. BLACK FINISH ON METAL HOUSING.	1-70W METAL HALIDE	120V	PAVILION
L-1	KIM	WF20P32PLWH-P	SIMILAR TO TYPE L EXCEPT FOR WHITE PAINT FINISH AND FLUORESCENT LAMPS.	32W PL	120V	KITCHEN TOILET
M	PRESCOLITE	#HCBW08BL	BRACKET MOUNTED METAL HALIDE DOWNLIGHT, WITH SPECULAR CLEAR ALZAK REFLECTOR. 8", 13-3/8"HT. BLACK FINISH	1-100W ED17 METAL HALIDE	120V	ATM MACHINES

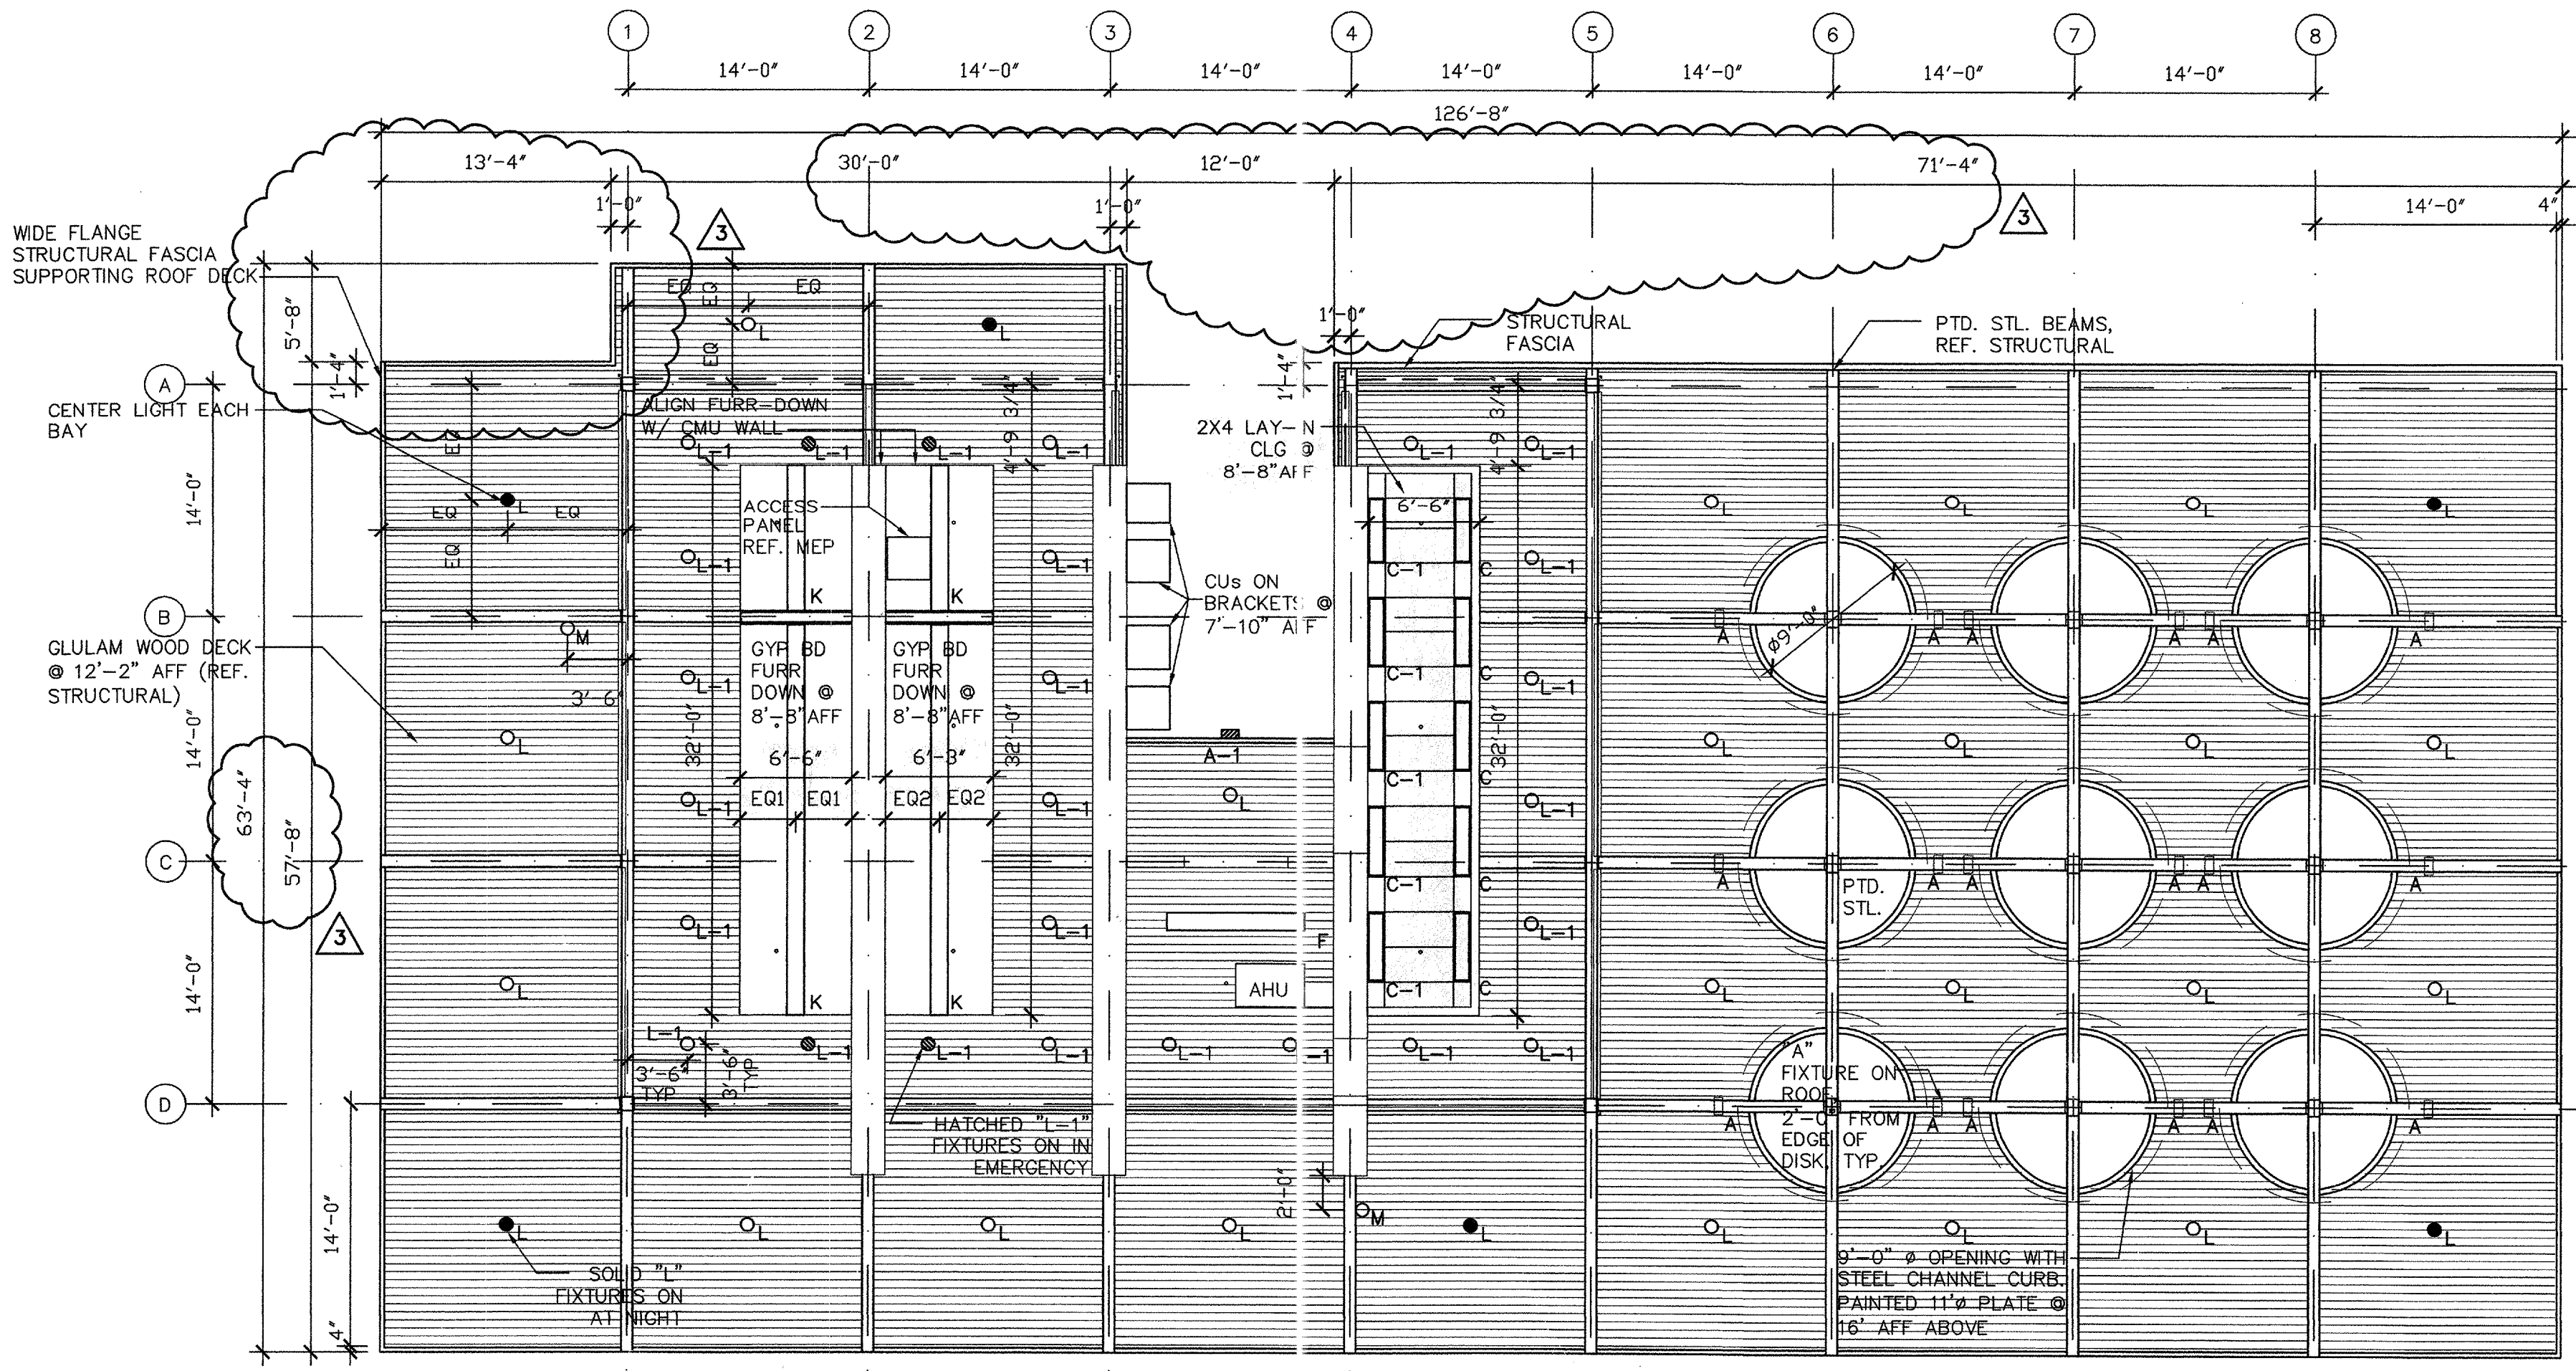

**2 REFLECTED CEILING PLAN**  
1/8"=1'-0"

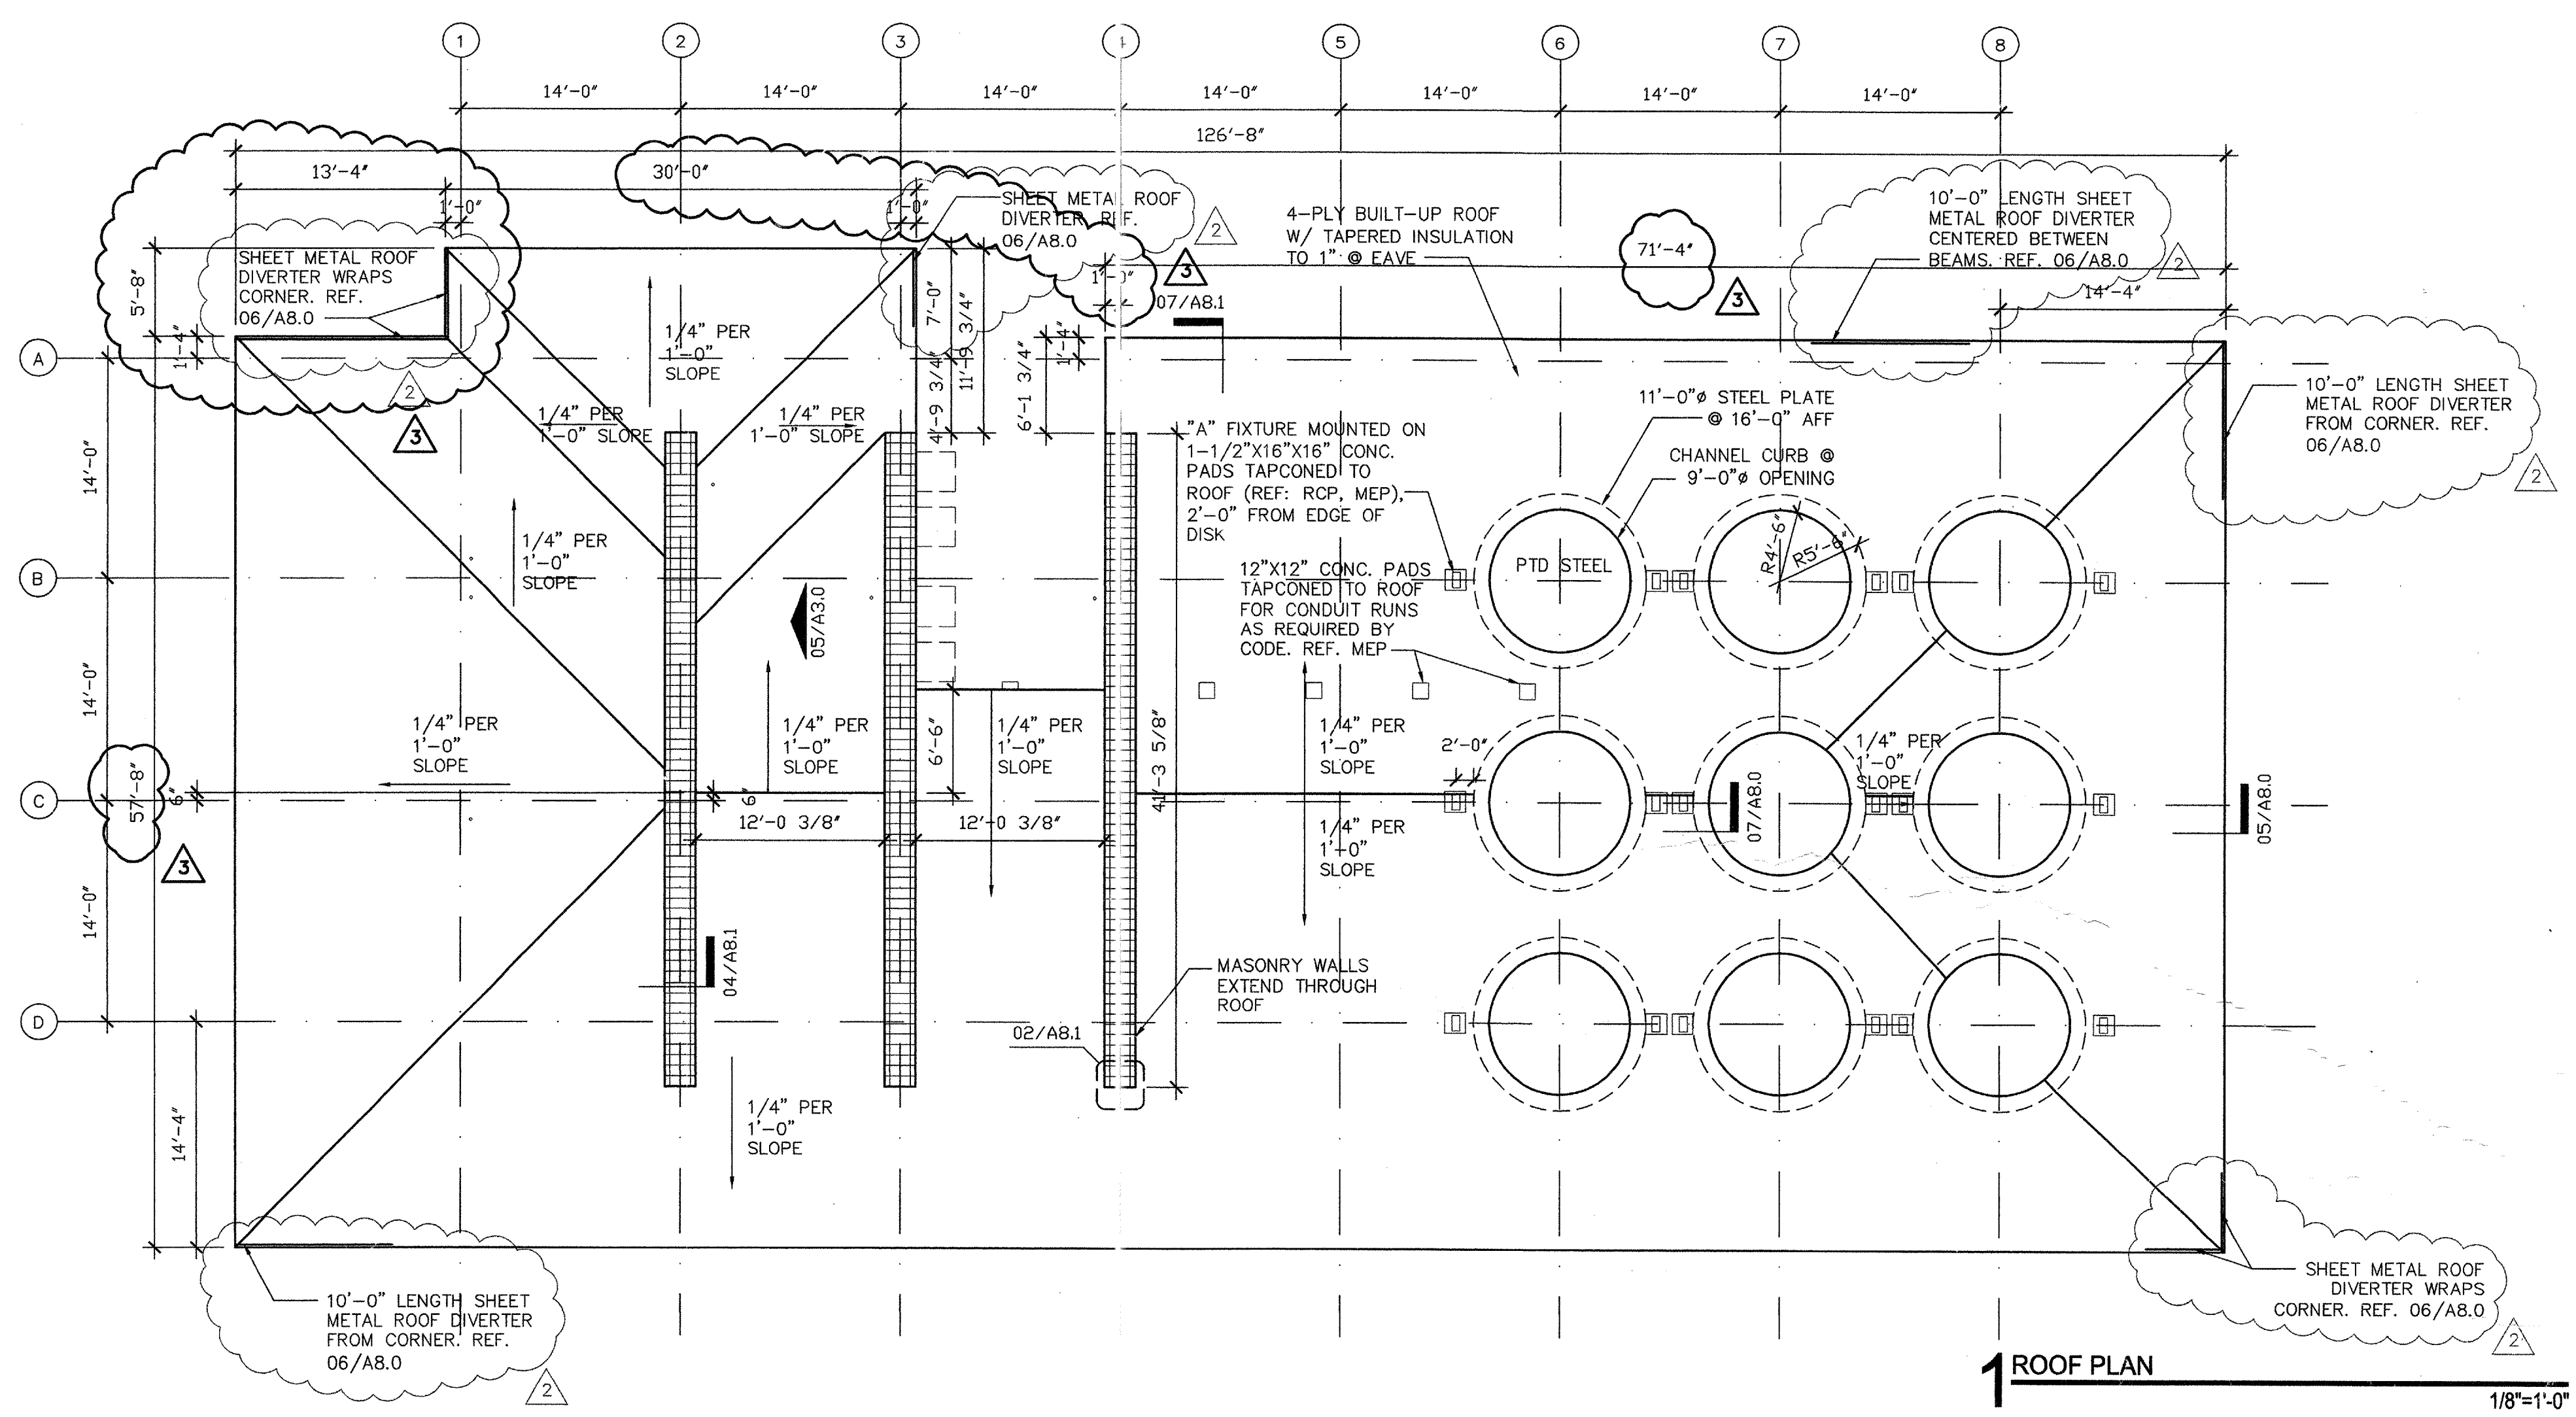

**1 ROOF PLAN**  
1/8"=1'-0"

**cunningham architects**  
918 Progress Street  
Dallas, Texas 75207  
V 214.915.0900  
F 214.915.0901

3-9-03

**Addison Arts and Events Pavilion**  
4970 Addison Circle Drive  
Addison, Texas

date	issue
08/26/02	DD
11/05/02	50% CD
01/23/03	100% CD
01/31/03	ADDENDUM1
02/06/03	ADDENDUM2
03/04/03	POST-BID REVISION

**A2.0**  
ROOF PLAN  
REFLECTED  
CEILING PLAN