




4 TYP. STOREFRONT SECTION WALL SECTION 3/4"=1'-0"

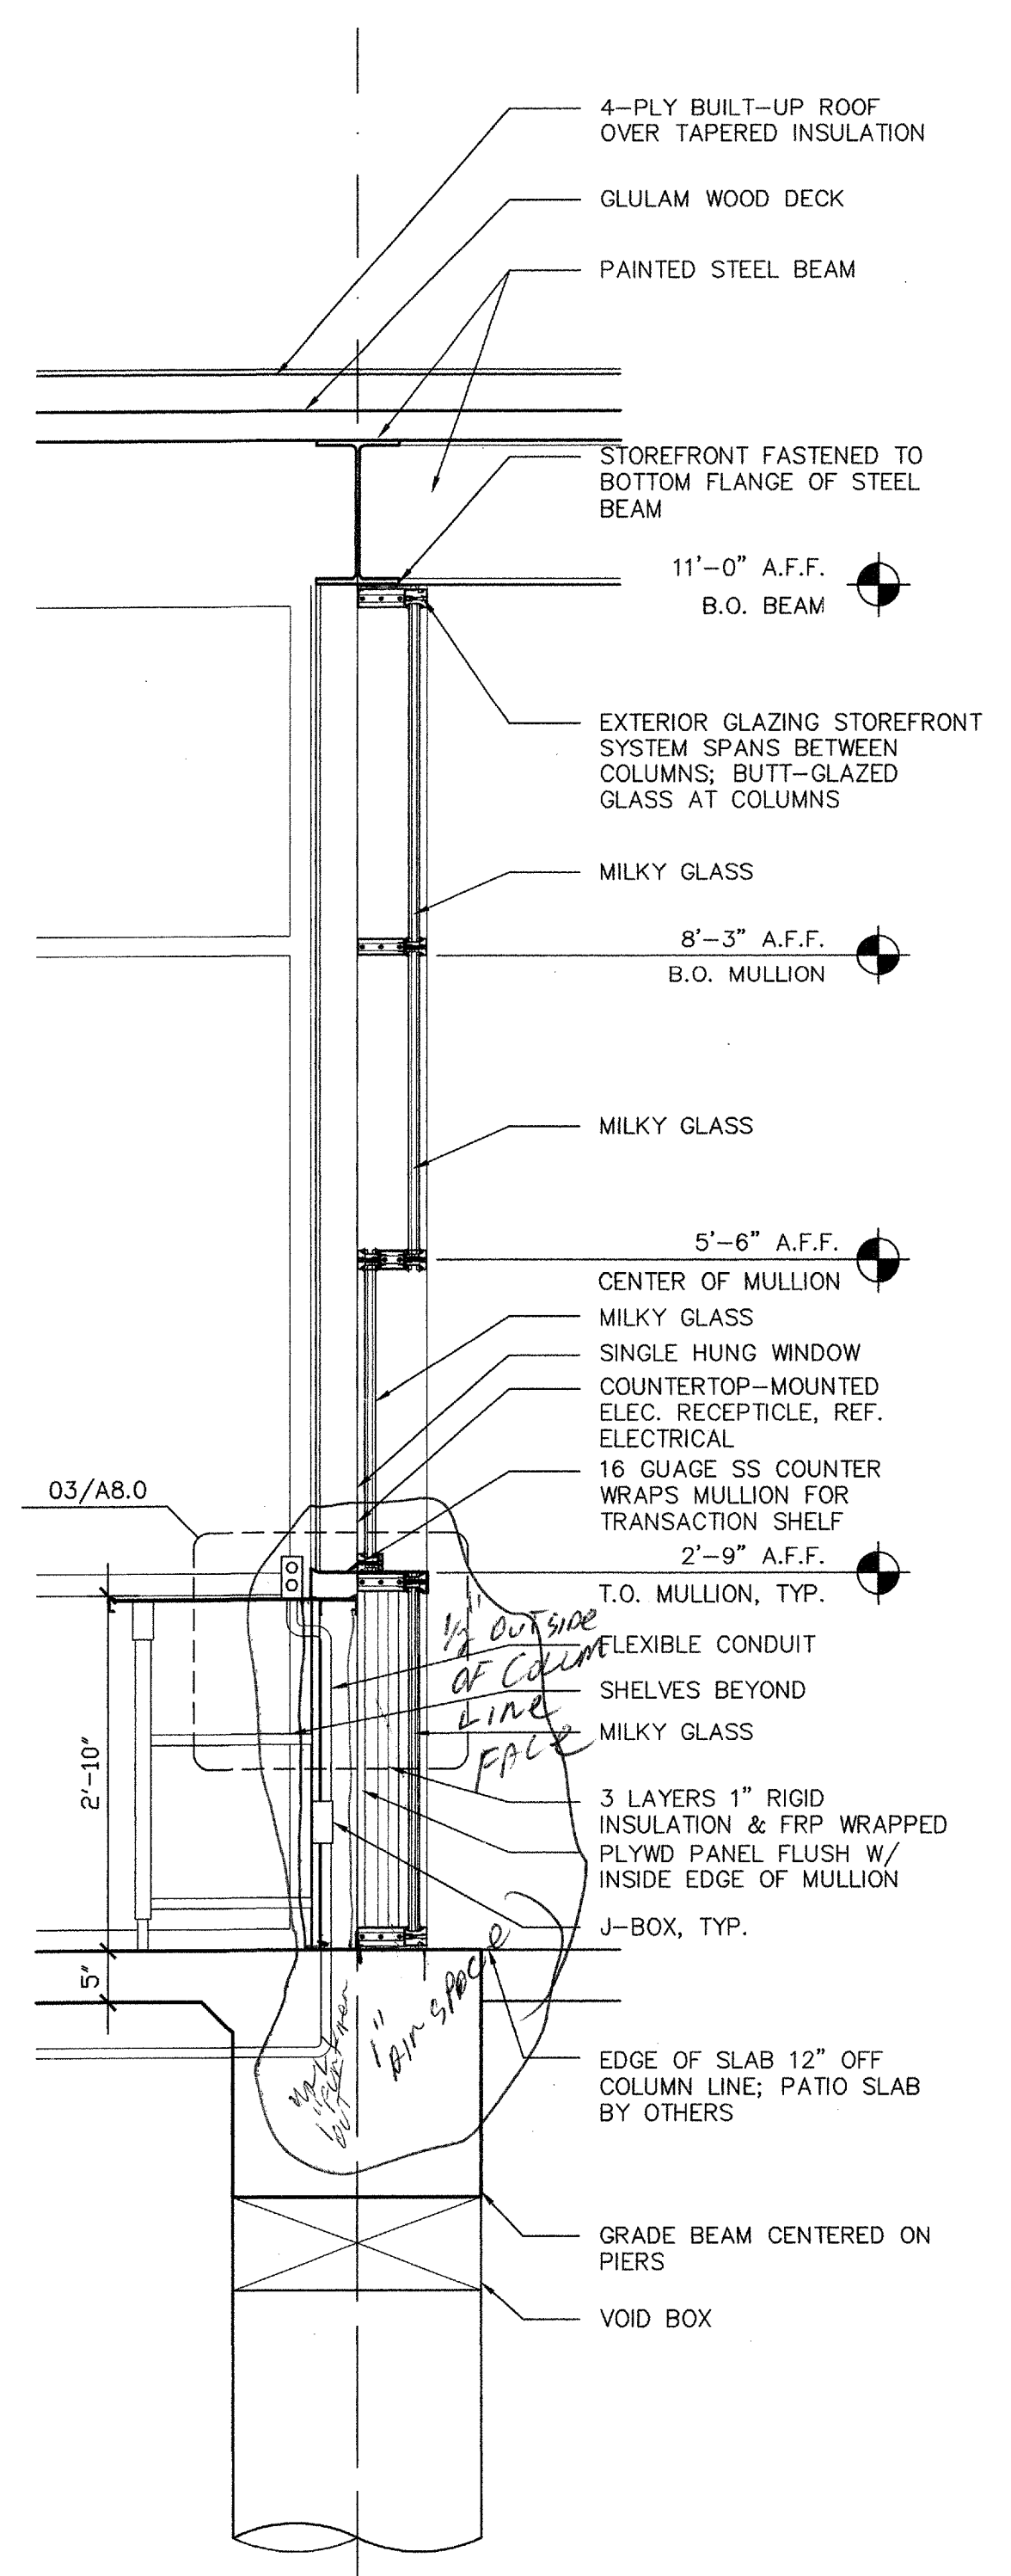

3 SECTION @ KITCHEN WALL SECTION 3/4"=1'-0"

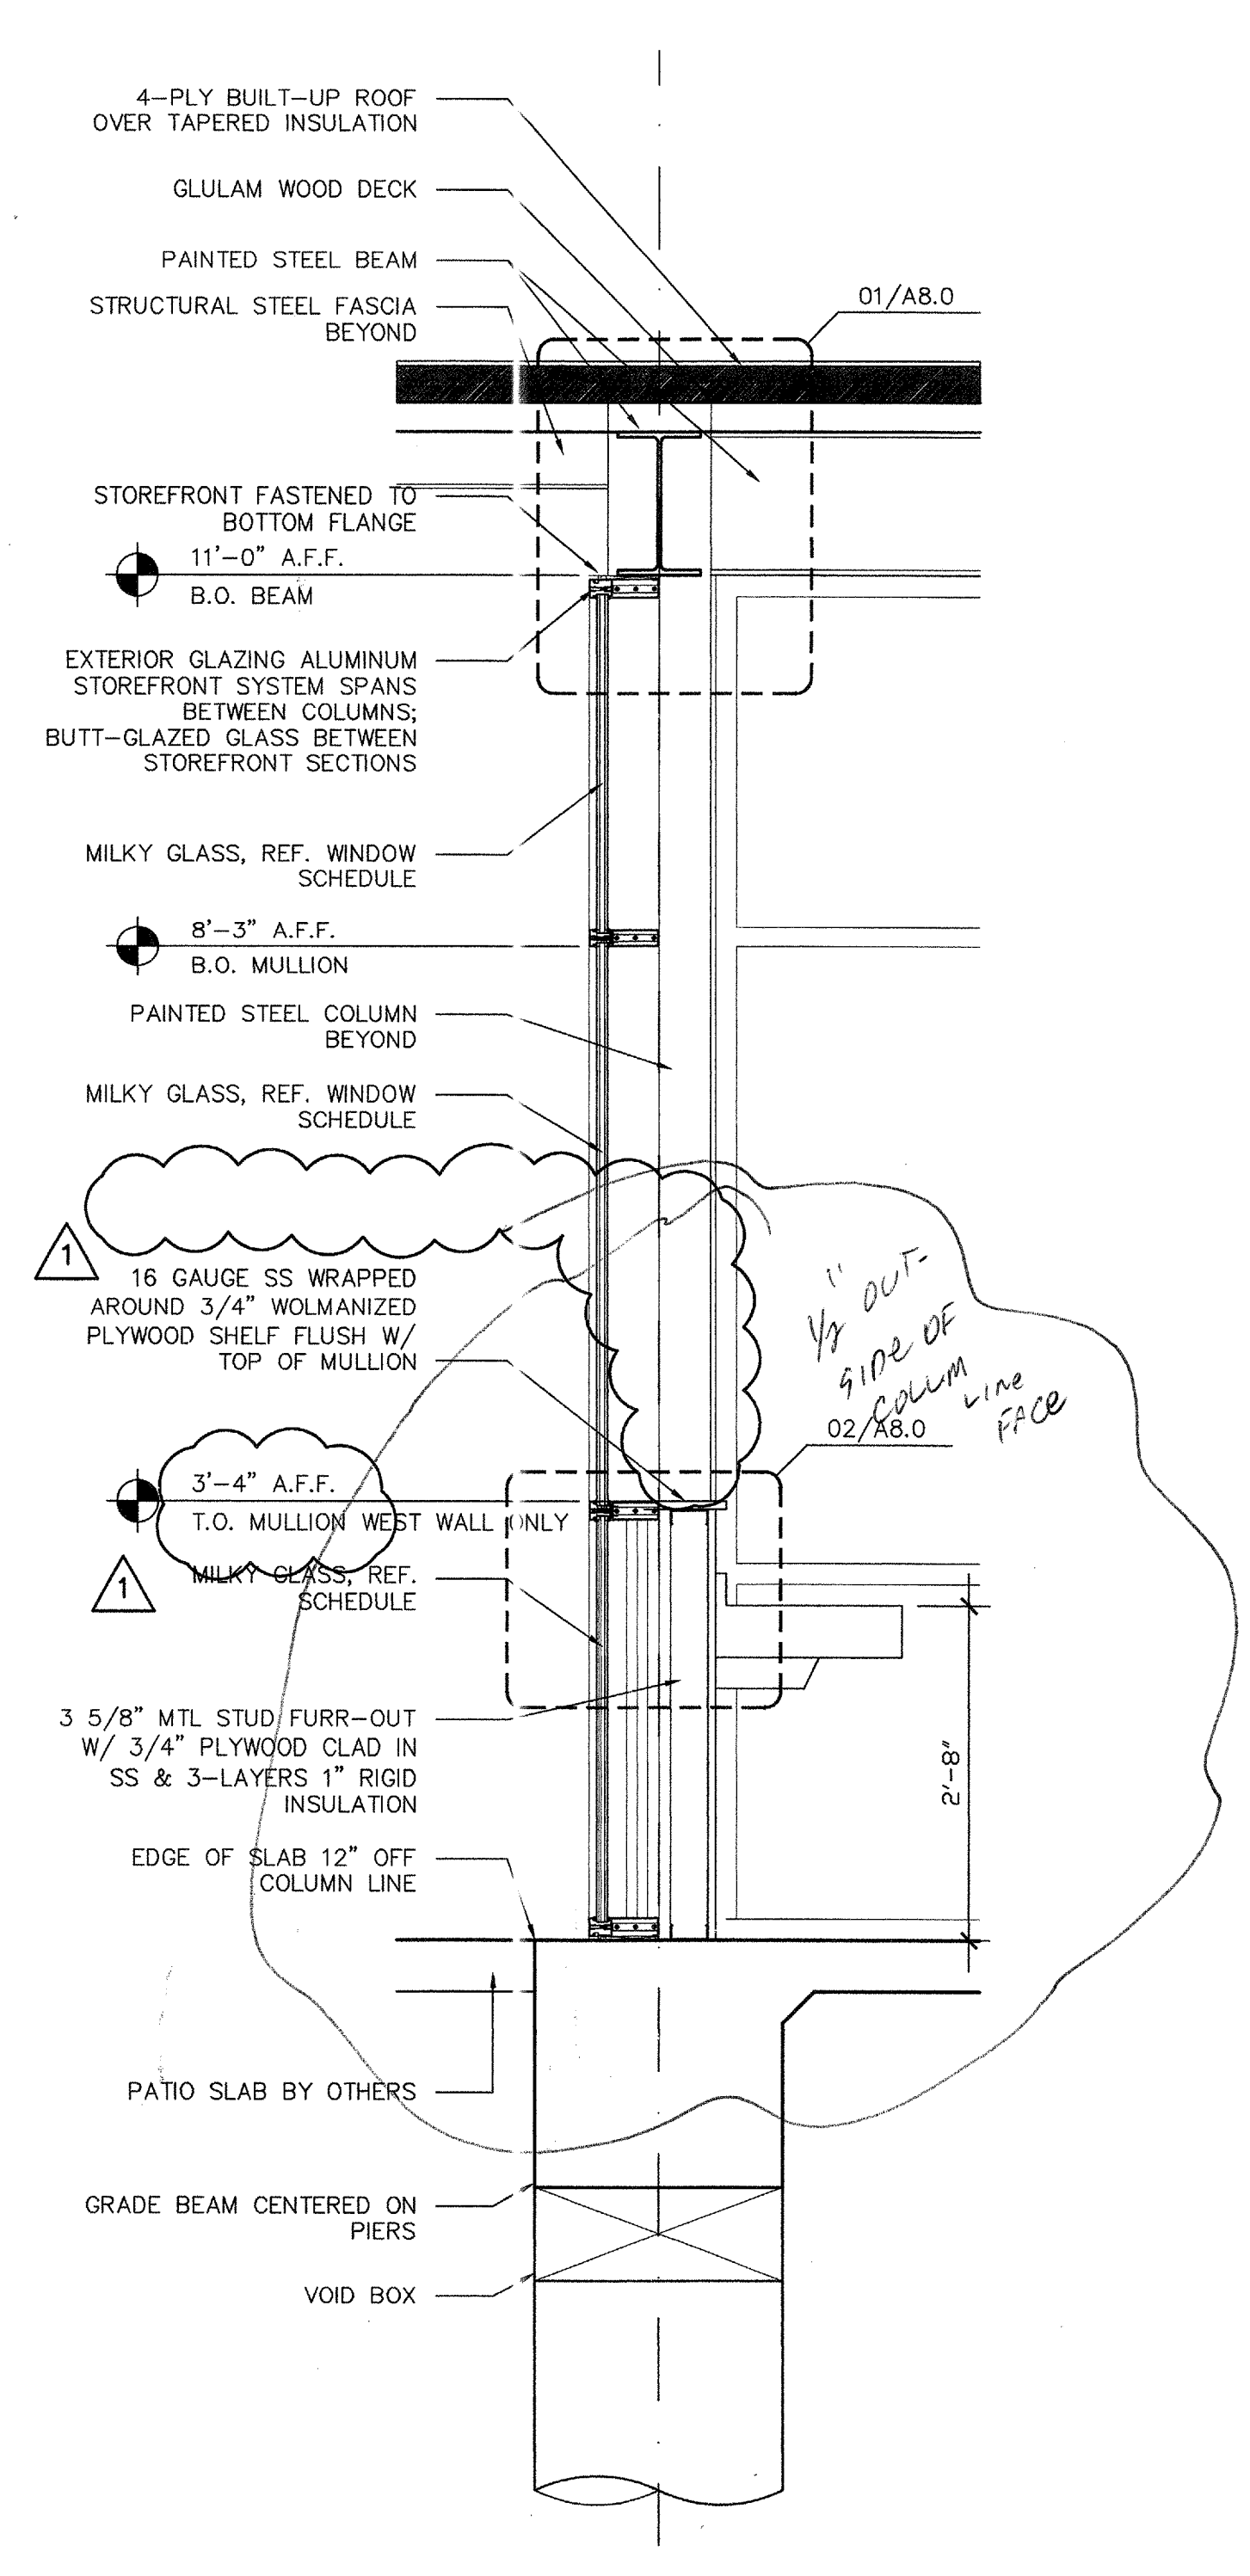

2 SECTION @ MEN'S ROOM WALL SECTION 3/4"=1'-0"

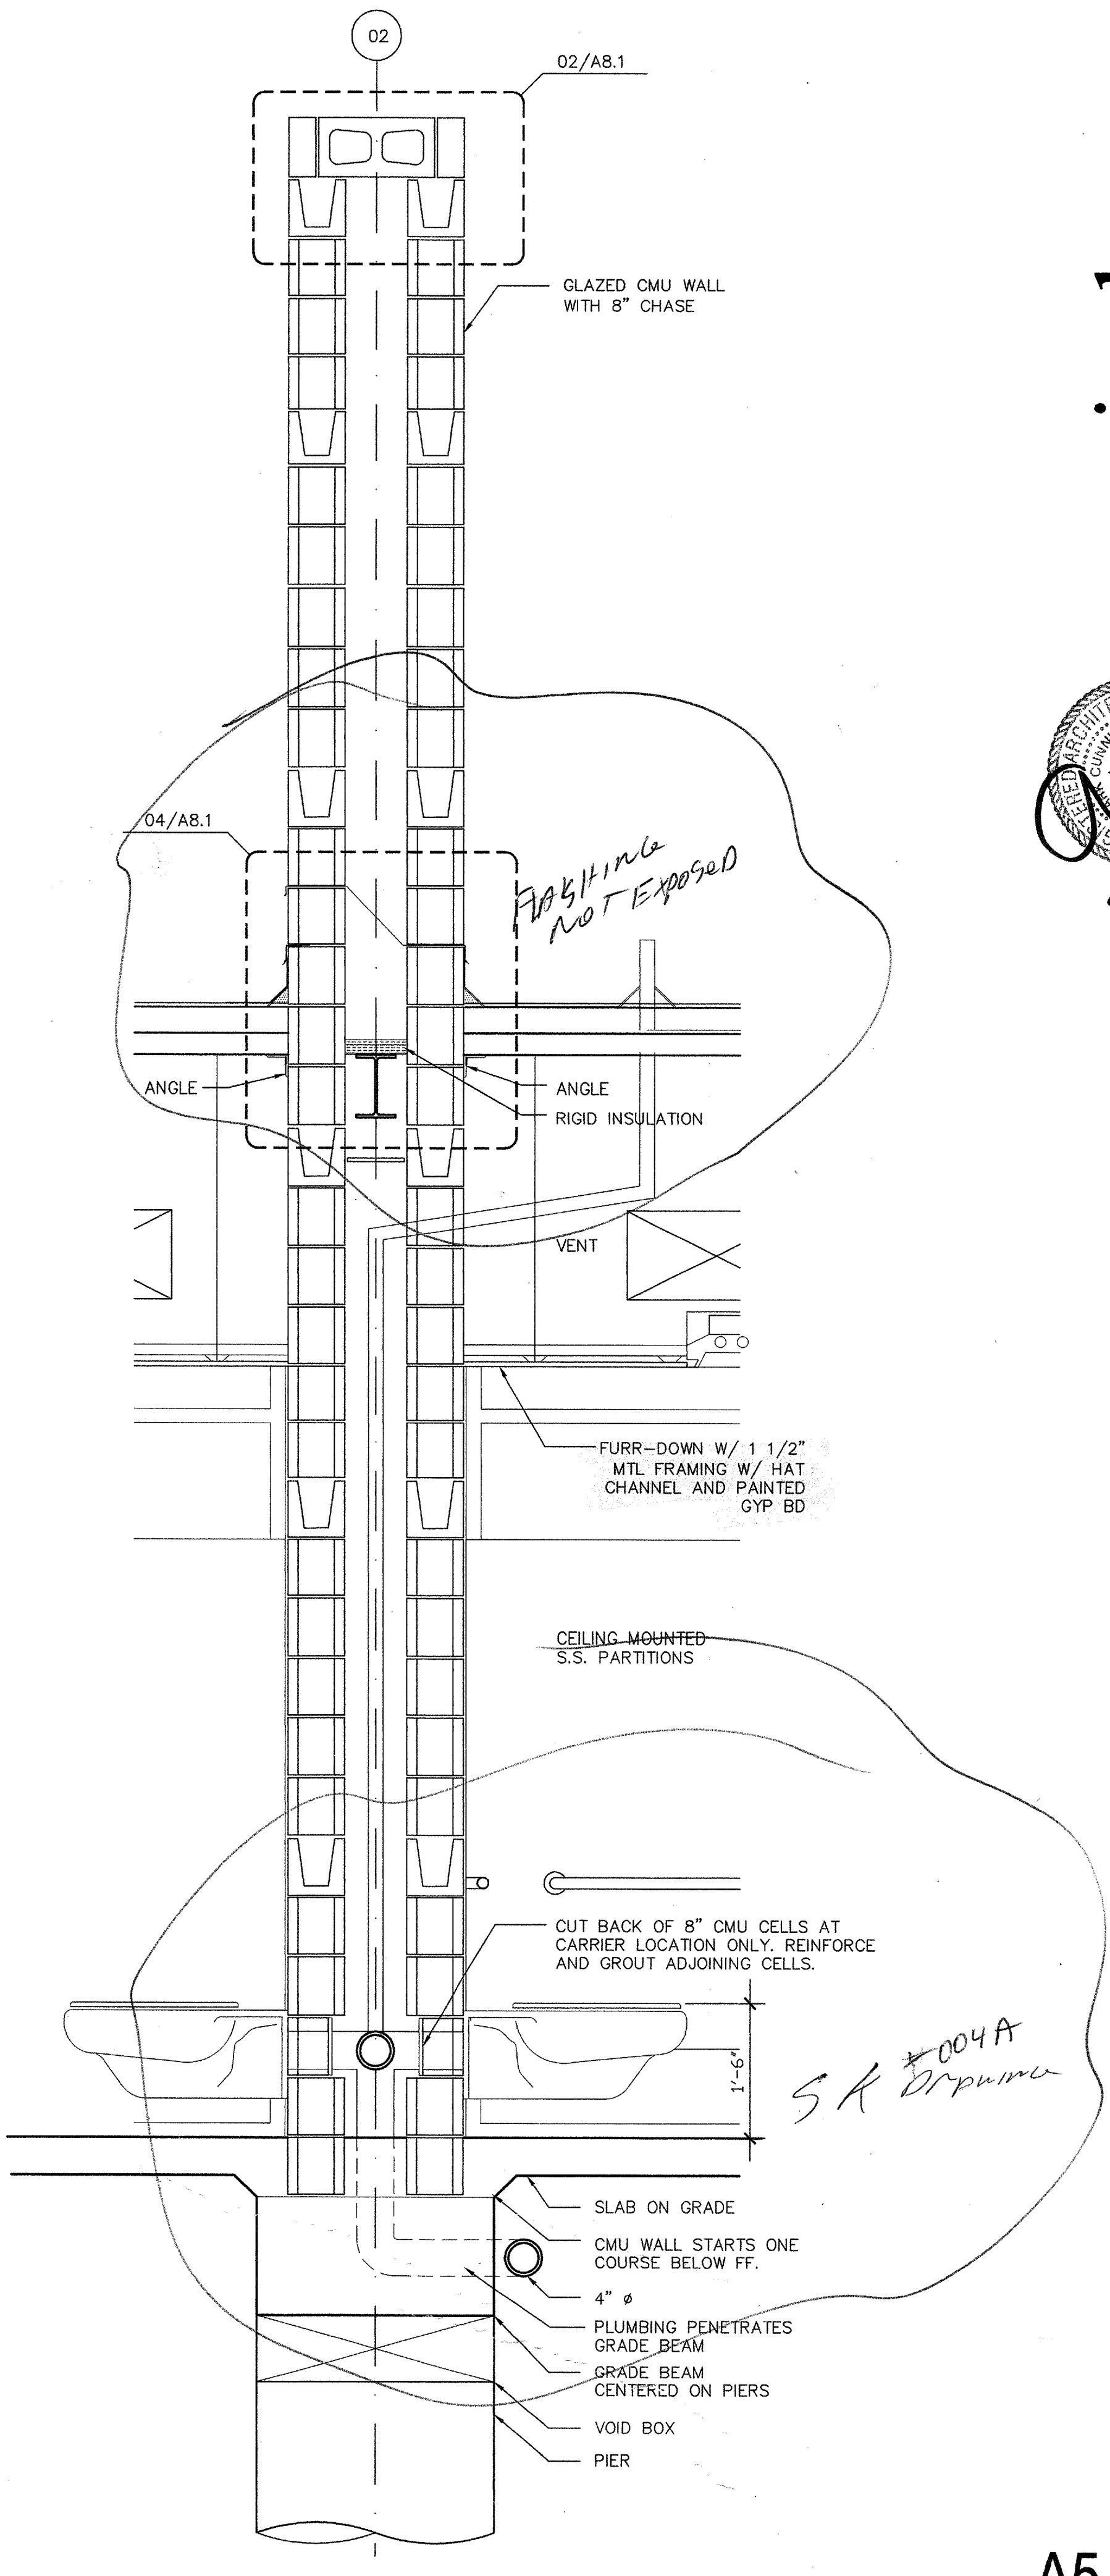

1 SECTION @ CMU WALL WALL SECTION 3/4"=1'-0"

issue	DD	date
50% CD	08/28/02	11/05/02
100% CD	11/05/02	01/23/03
POST-BID	03/04/03	REVISION