



4 SOUTH ELEVATION
MEN'S ROOM 1/2"=1'-0"

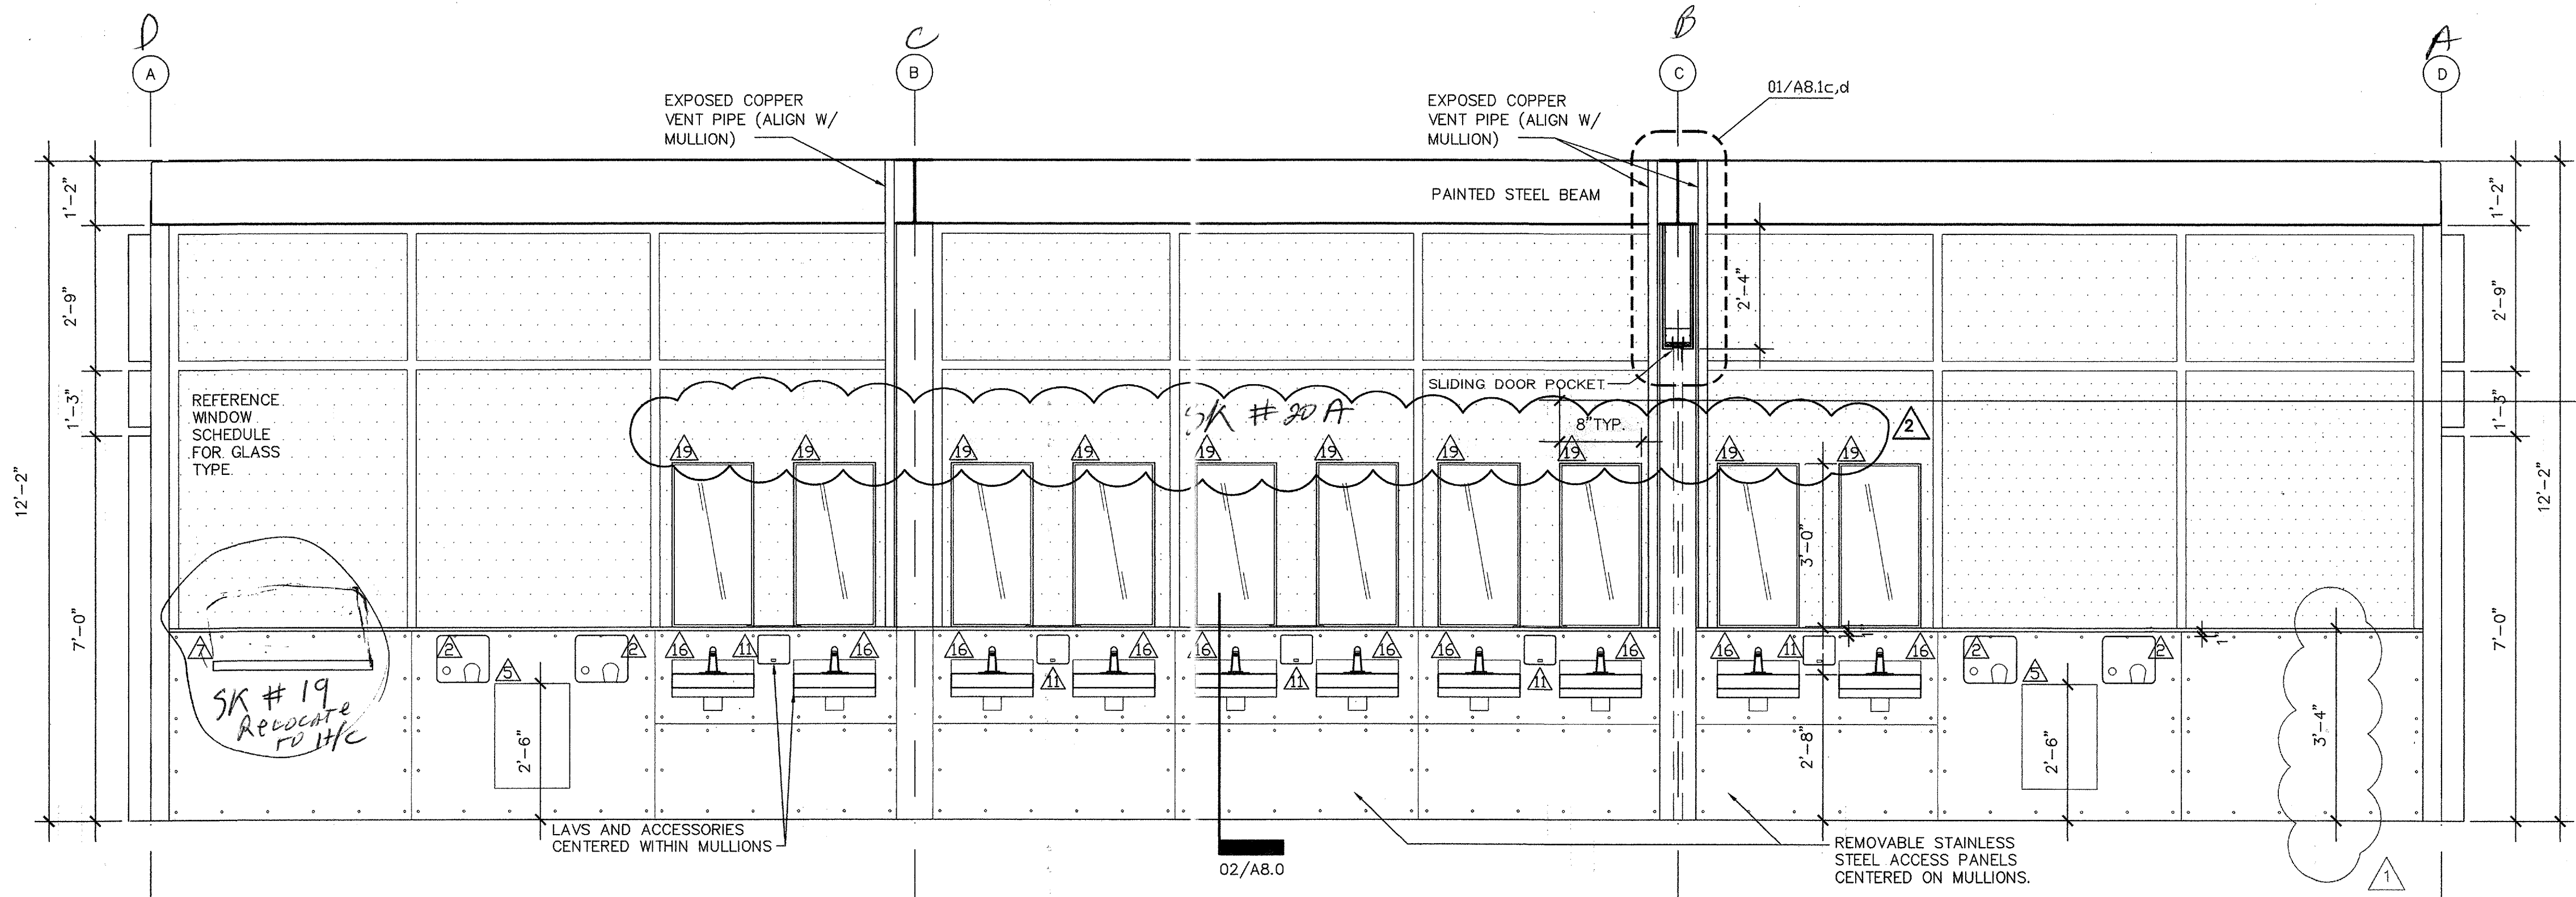


3 WEST ELEVATION
MEN'S ROOM 1/2"=1'-0"


TOILET AND BATH ACCESSORY SCHEDULE	
NO.	DESCRIPTION
1	NOT USED
2	WARM AIR DRYER
3	MIRROR/SHELF COMBINATION UNIT
4	LIQUID SOAP DISPENSER (WOMEN)
5	WASTE RECEPTACLE, SURFACE MOUNTED
6	SANITARY NAP/IN/TAMPON VENDOR
7	DIAPER CHANGING STATION
8	SANITARY NAP/IN/TAMPON DISPOSAL UNIT
9	TOILET TISSUE DISPENSER
10	NOT USED
11	LIQUID SOAP DISPENSER (MEN)
12	NOT USED
13	GRAB BAR
14	WALL MOUNTED TOILET - REF. PLUMBING SCHEDULE
15	WALL MOUNTED URINAL - REF. PLUMBING SCHEDULE
16	WALL MOUNTED VANITY SINK - REF. PLUMBING SCHEDULE
17	MIRROR
18	COAT HOOK
19	STAINLESS STEEL MIRROR 8" WIDE
20	TOILET PARTITIONS TO BE STAINLESS STEEL CLG MOUNTED

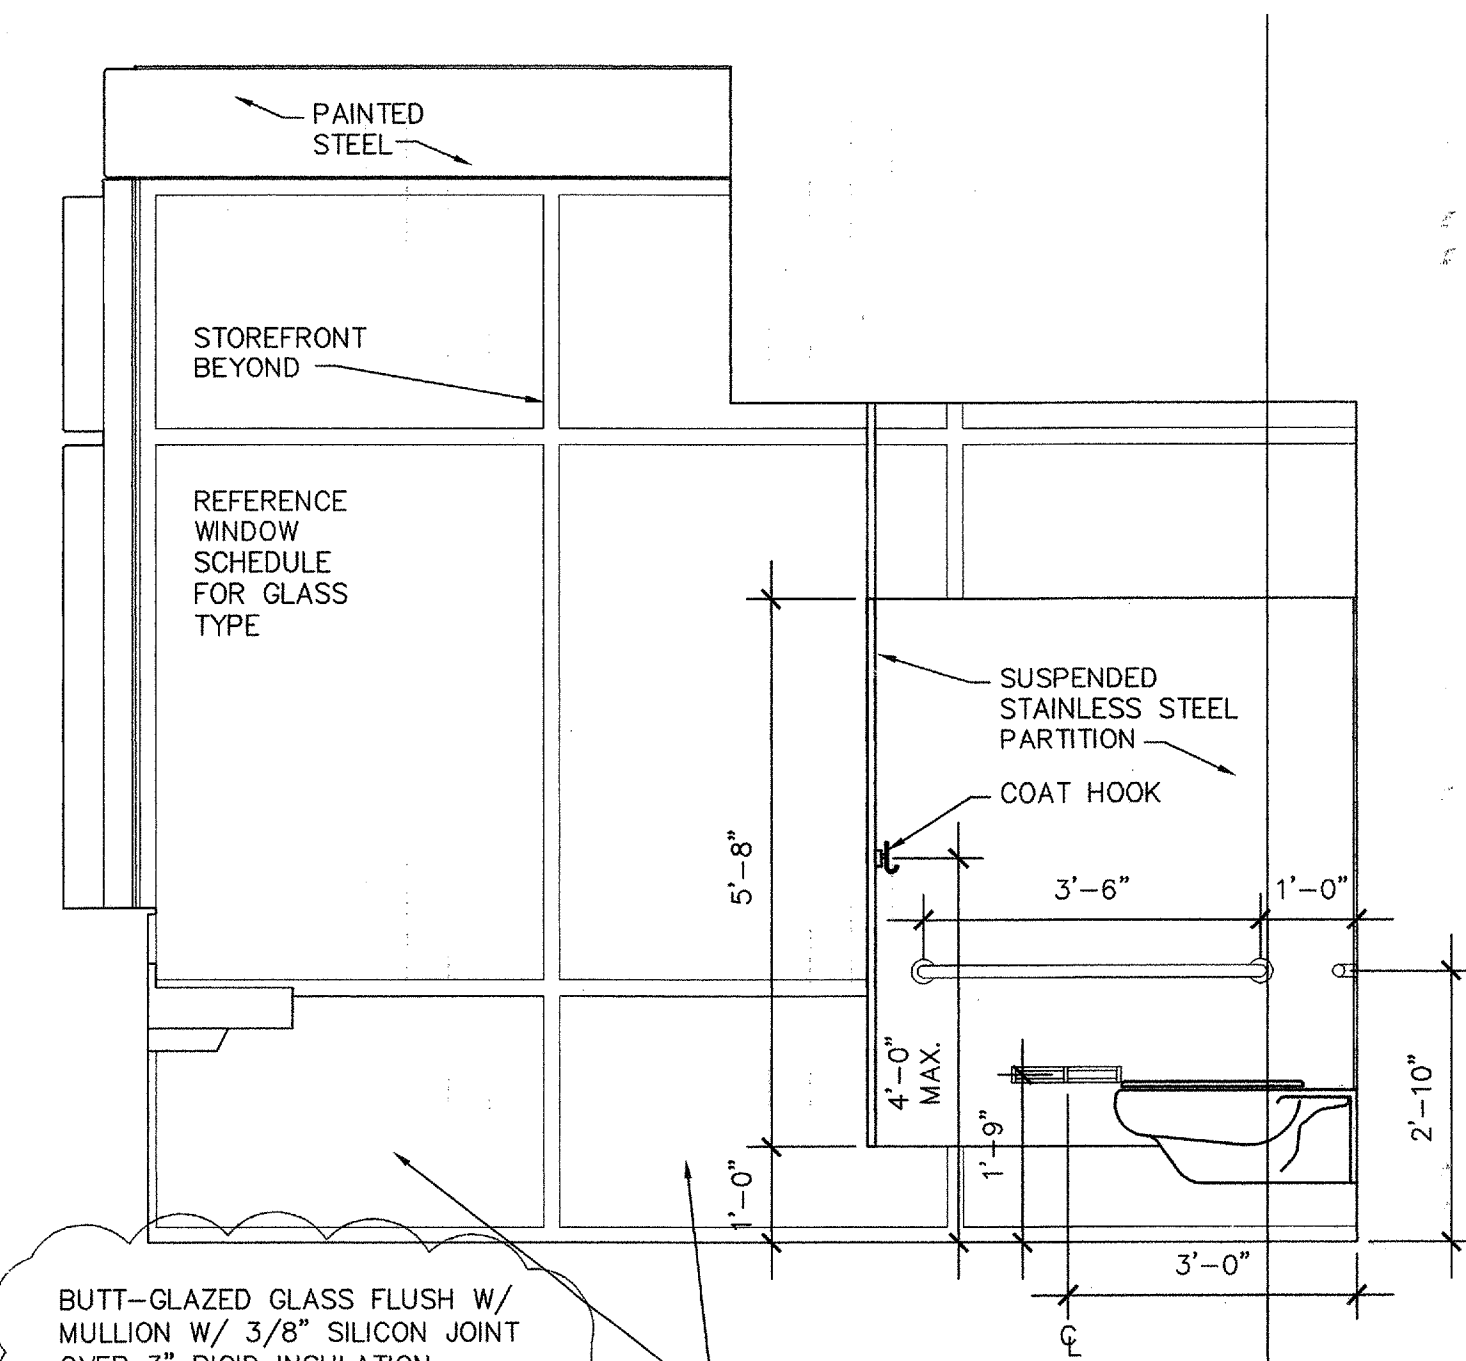

2 NORTH ELEVATION
MEN'S ROOM 1/2"=1'-0"

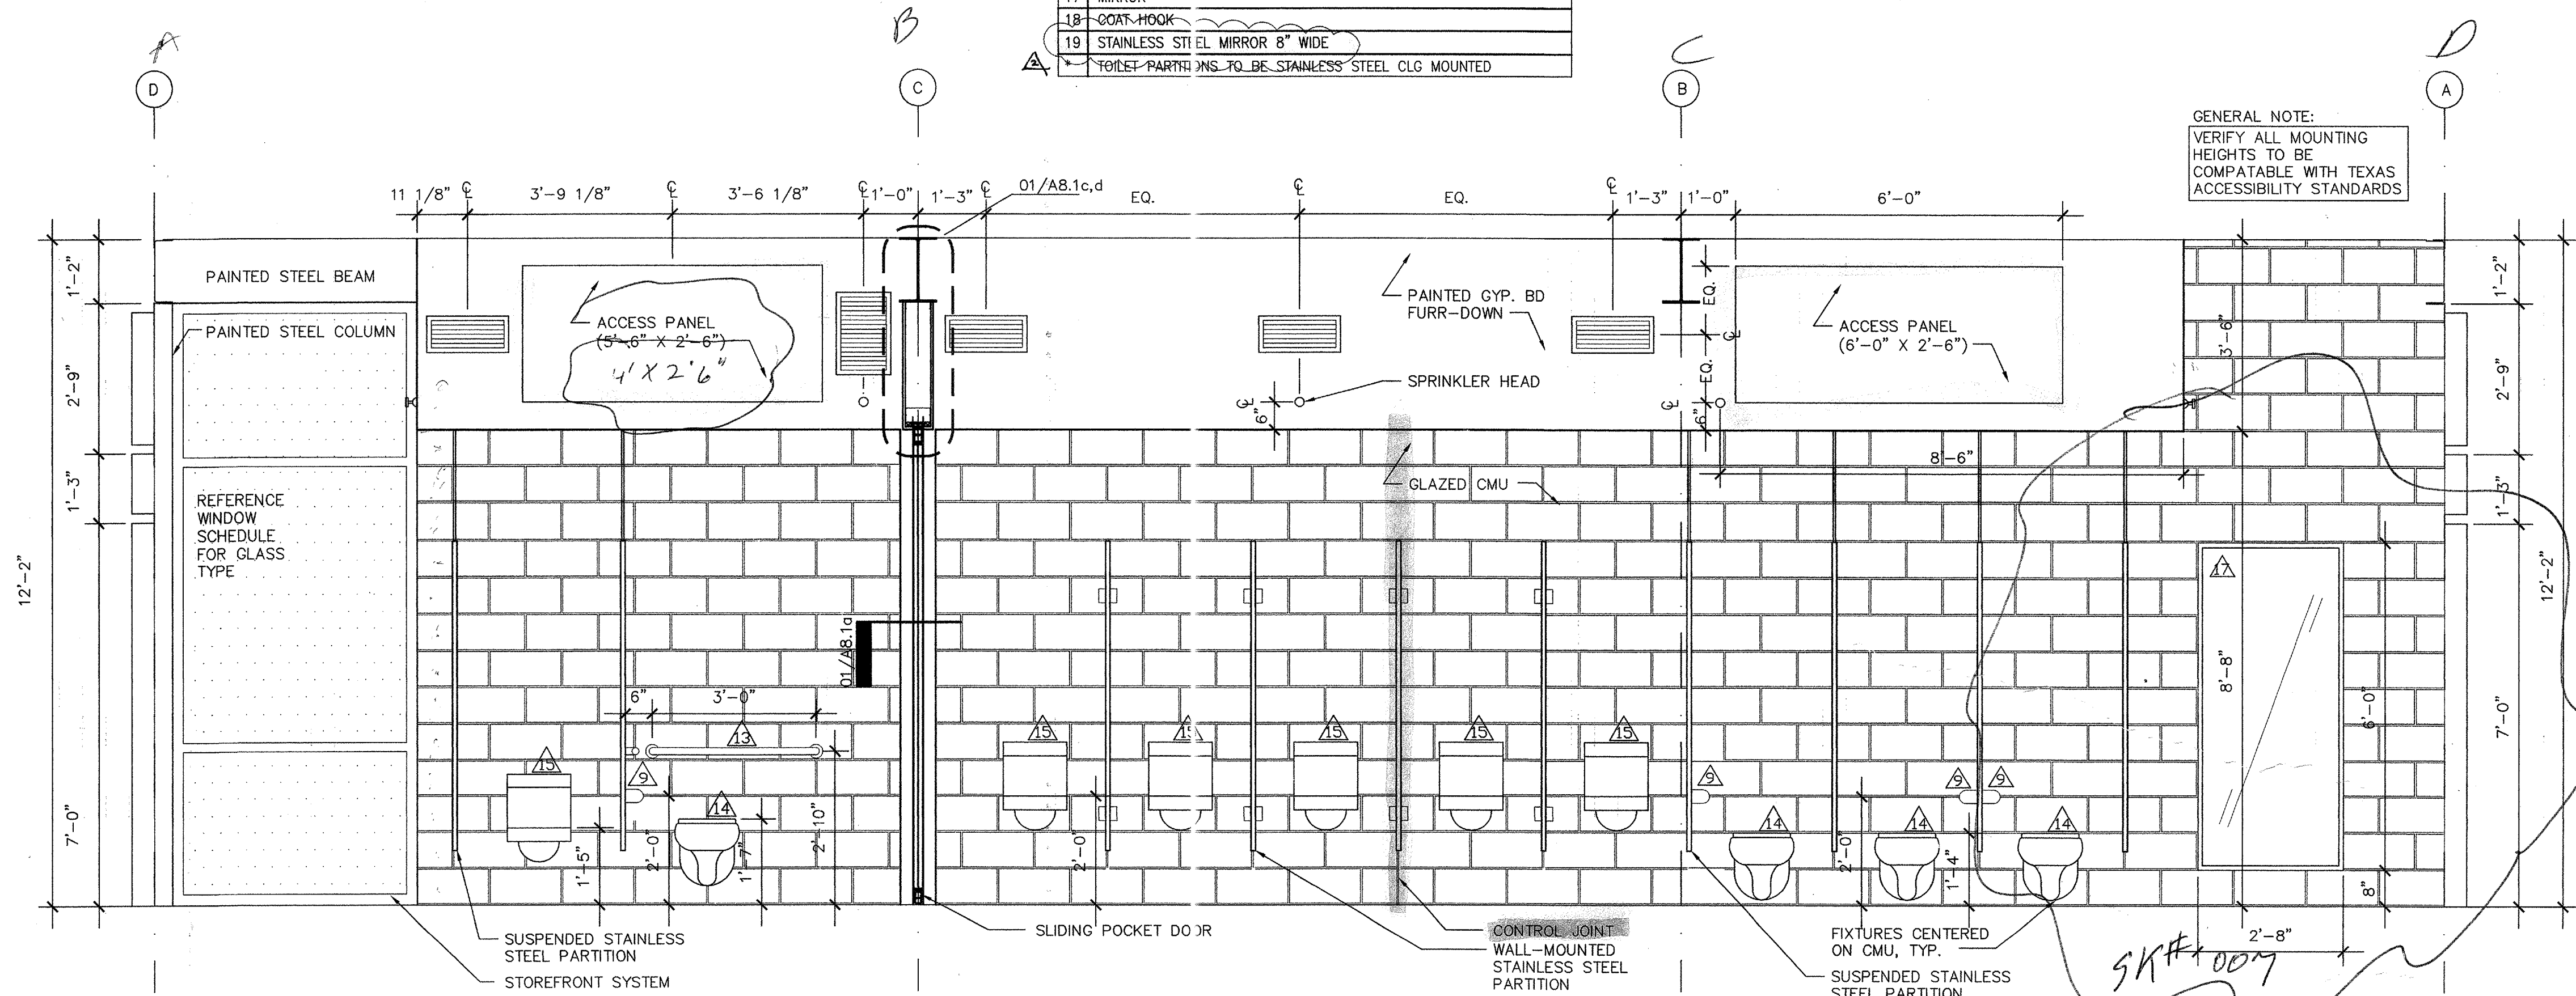

1 EAST ELEVATION
MEN'S ROOM 1/2"=1'-0"

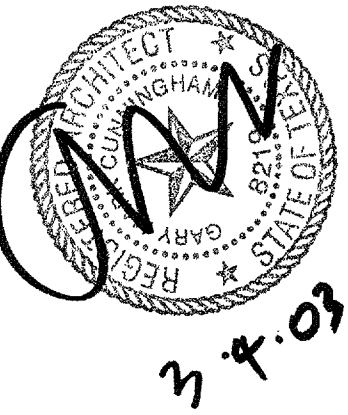

issue	date
DD	06/26/02
50% CD	11/05/02
100% CD	01/23/03
ADDENDUM 1	01/21/03
ADDENDUM 2	02/06/03