


BUTT-GLAZED GLASS FLUSH W/
MULLION W/ 3/8" SILICON JOINT
OVER 3" RIGID INSULATION,
BOTTOM LITE ONLY.


4 SOUTH ELEVATION
WOMEN'S ROOM

1/2"=1'-0"

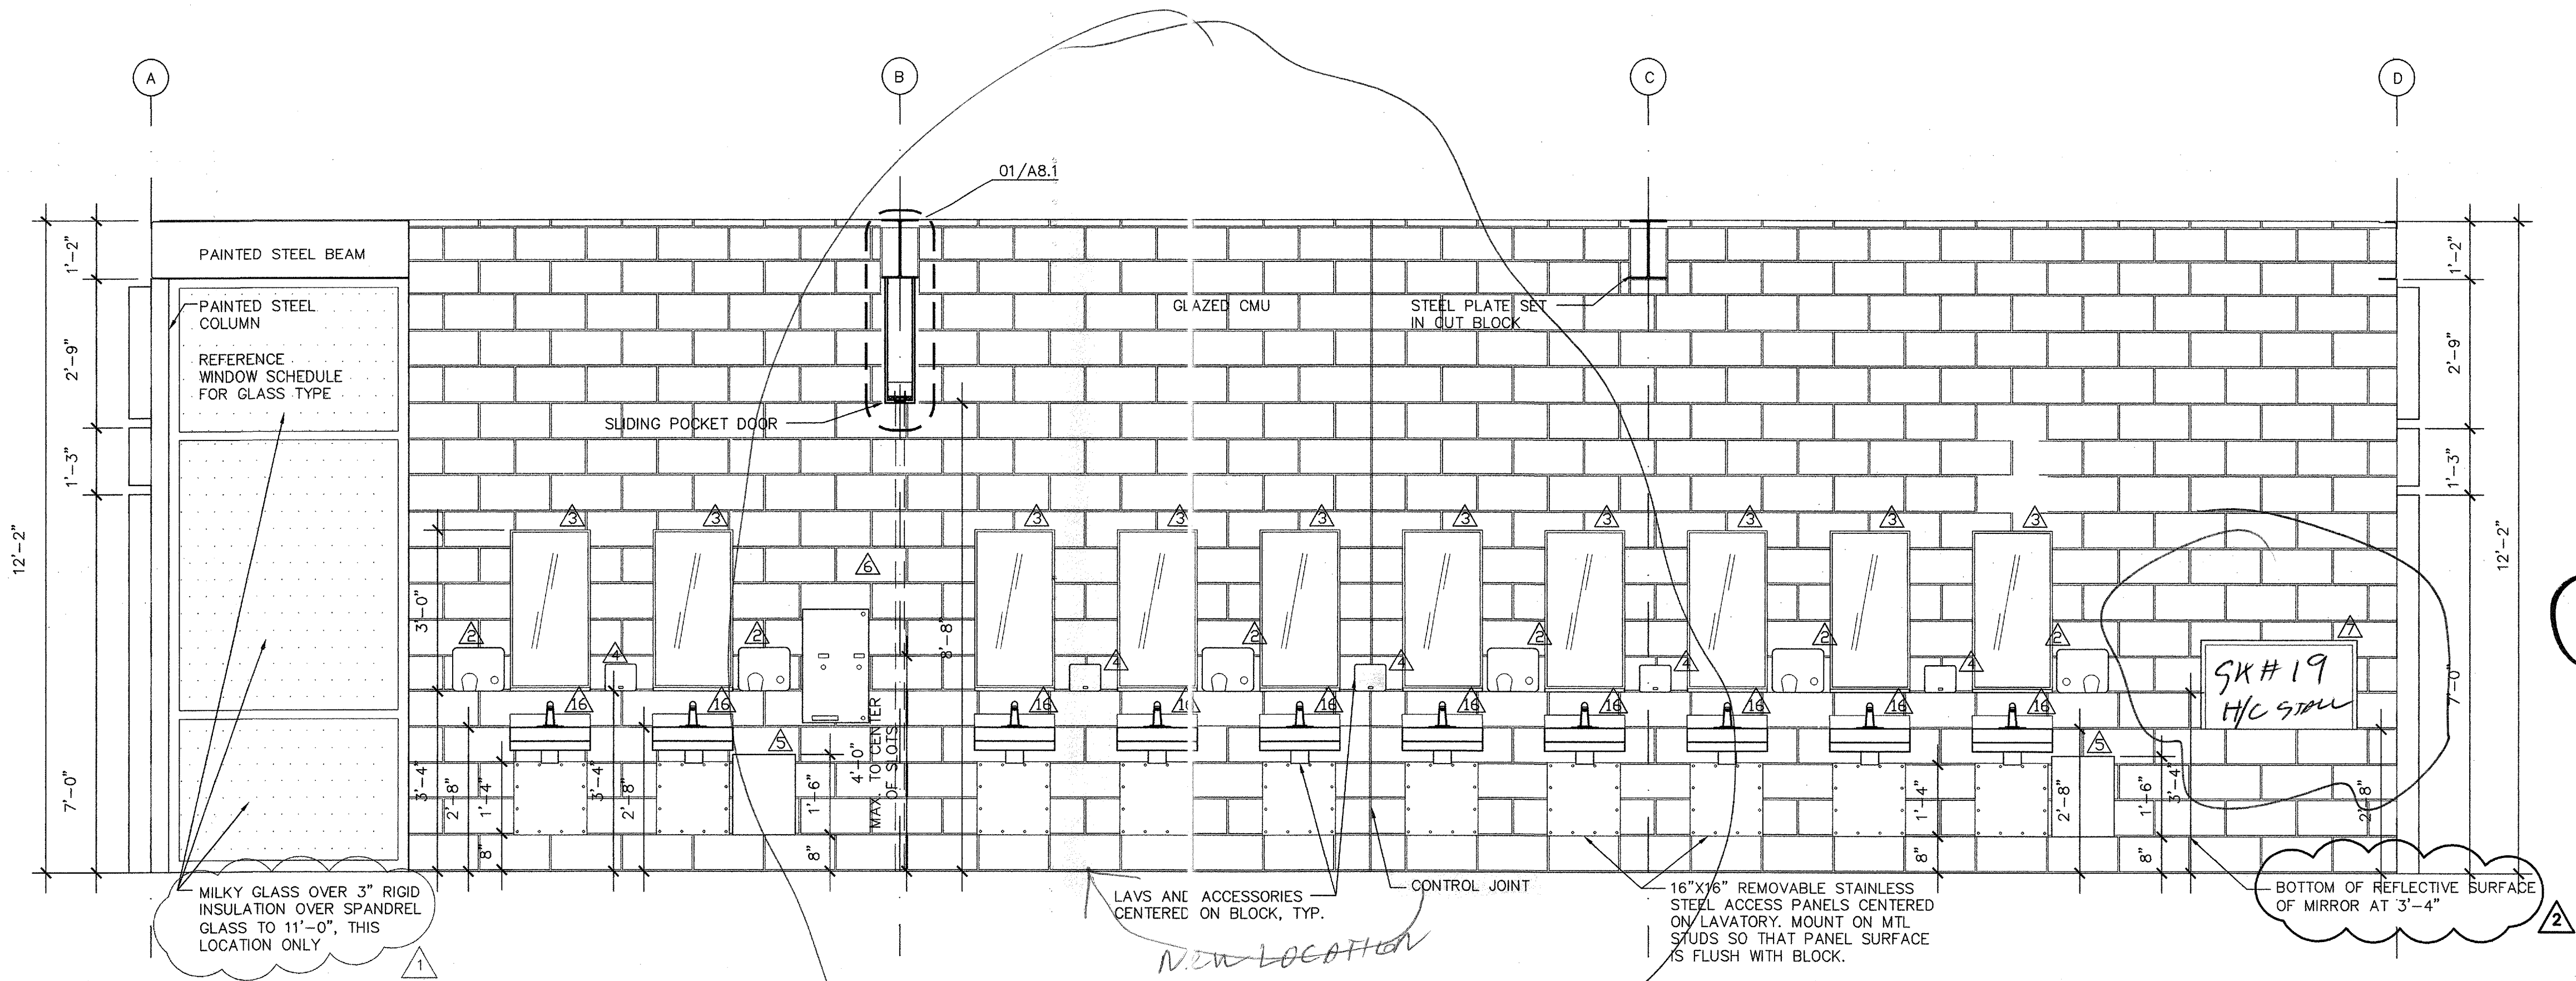

2 EAST ELEVATION
WOMEN'S ROOM


1/2"=1'-0"

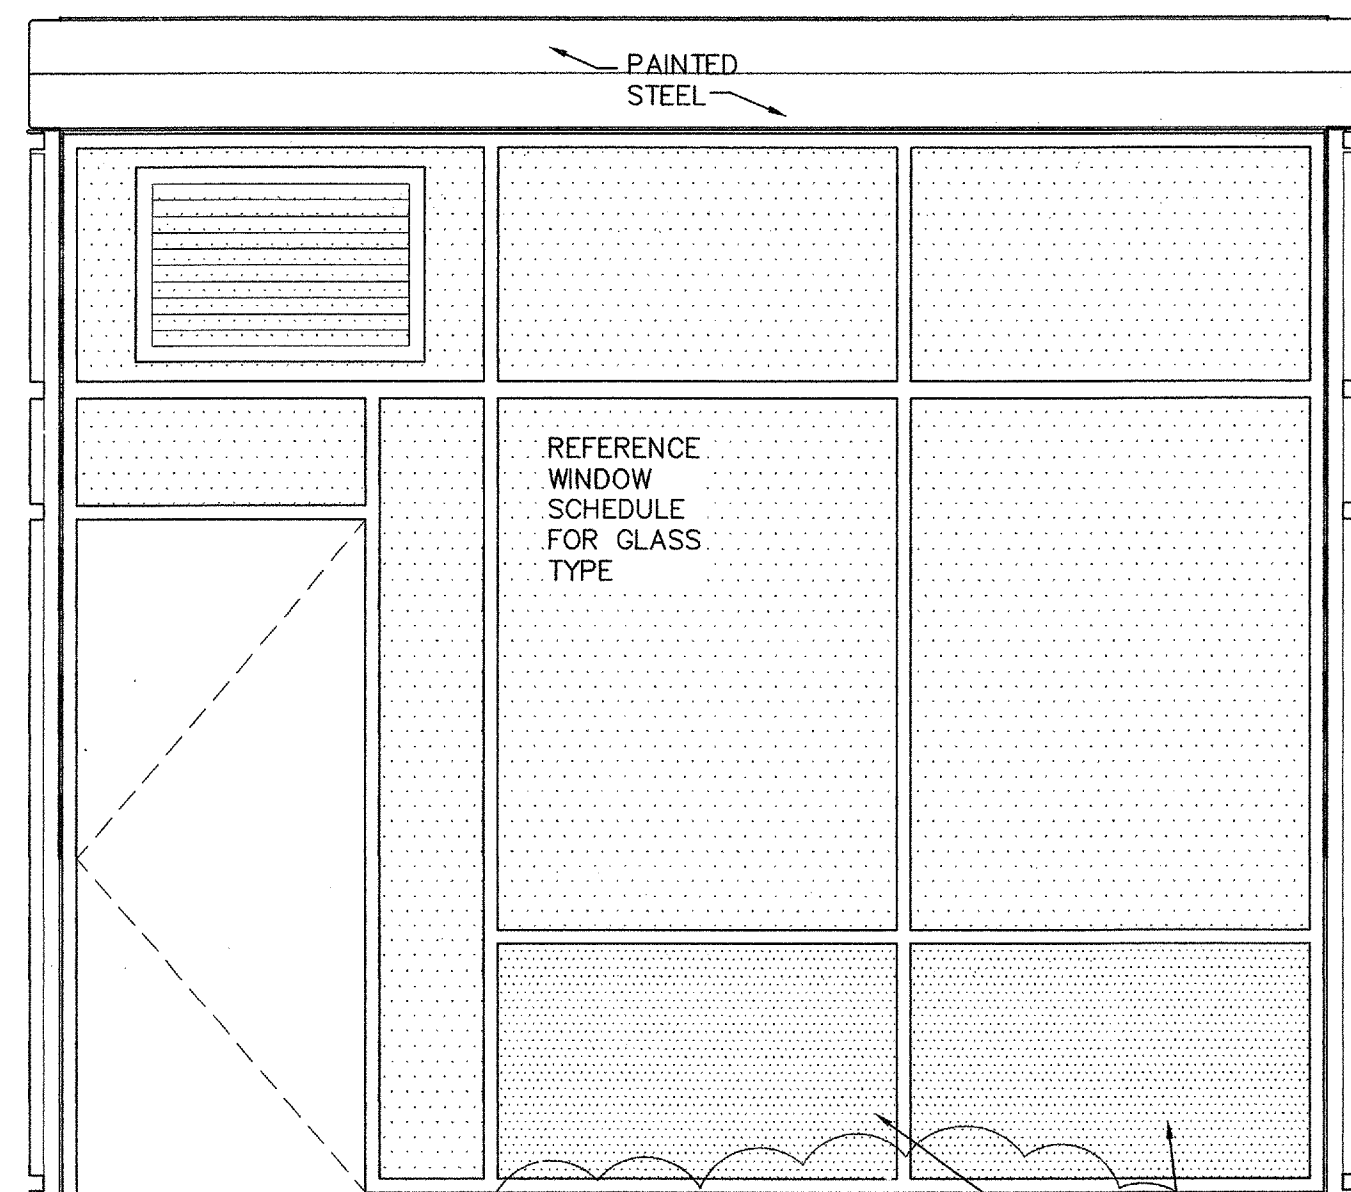

BUTT-GLAZED GLASS FLUSH W/
MULLION W/ 3/8" SILICON JOINT
OVER 3" RIGID INSULATION,
BOTTOM LITE ONLY.

3 NORTH ELEVATION
WOMEN'S ROOM


1/2"=1'-0"

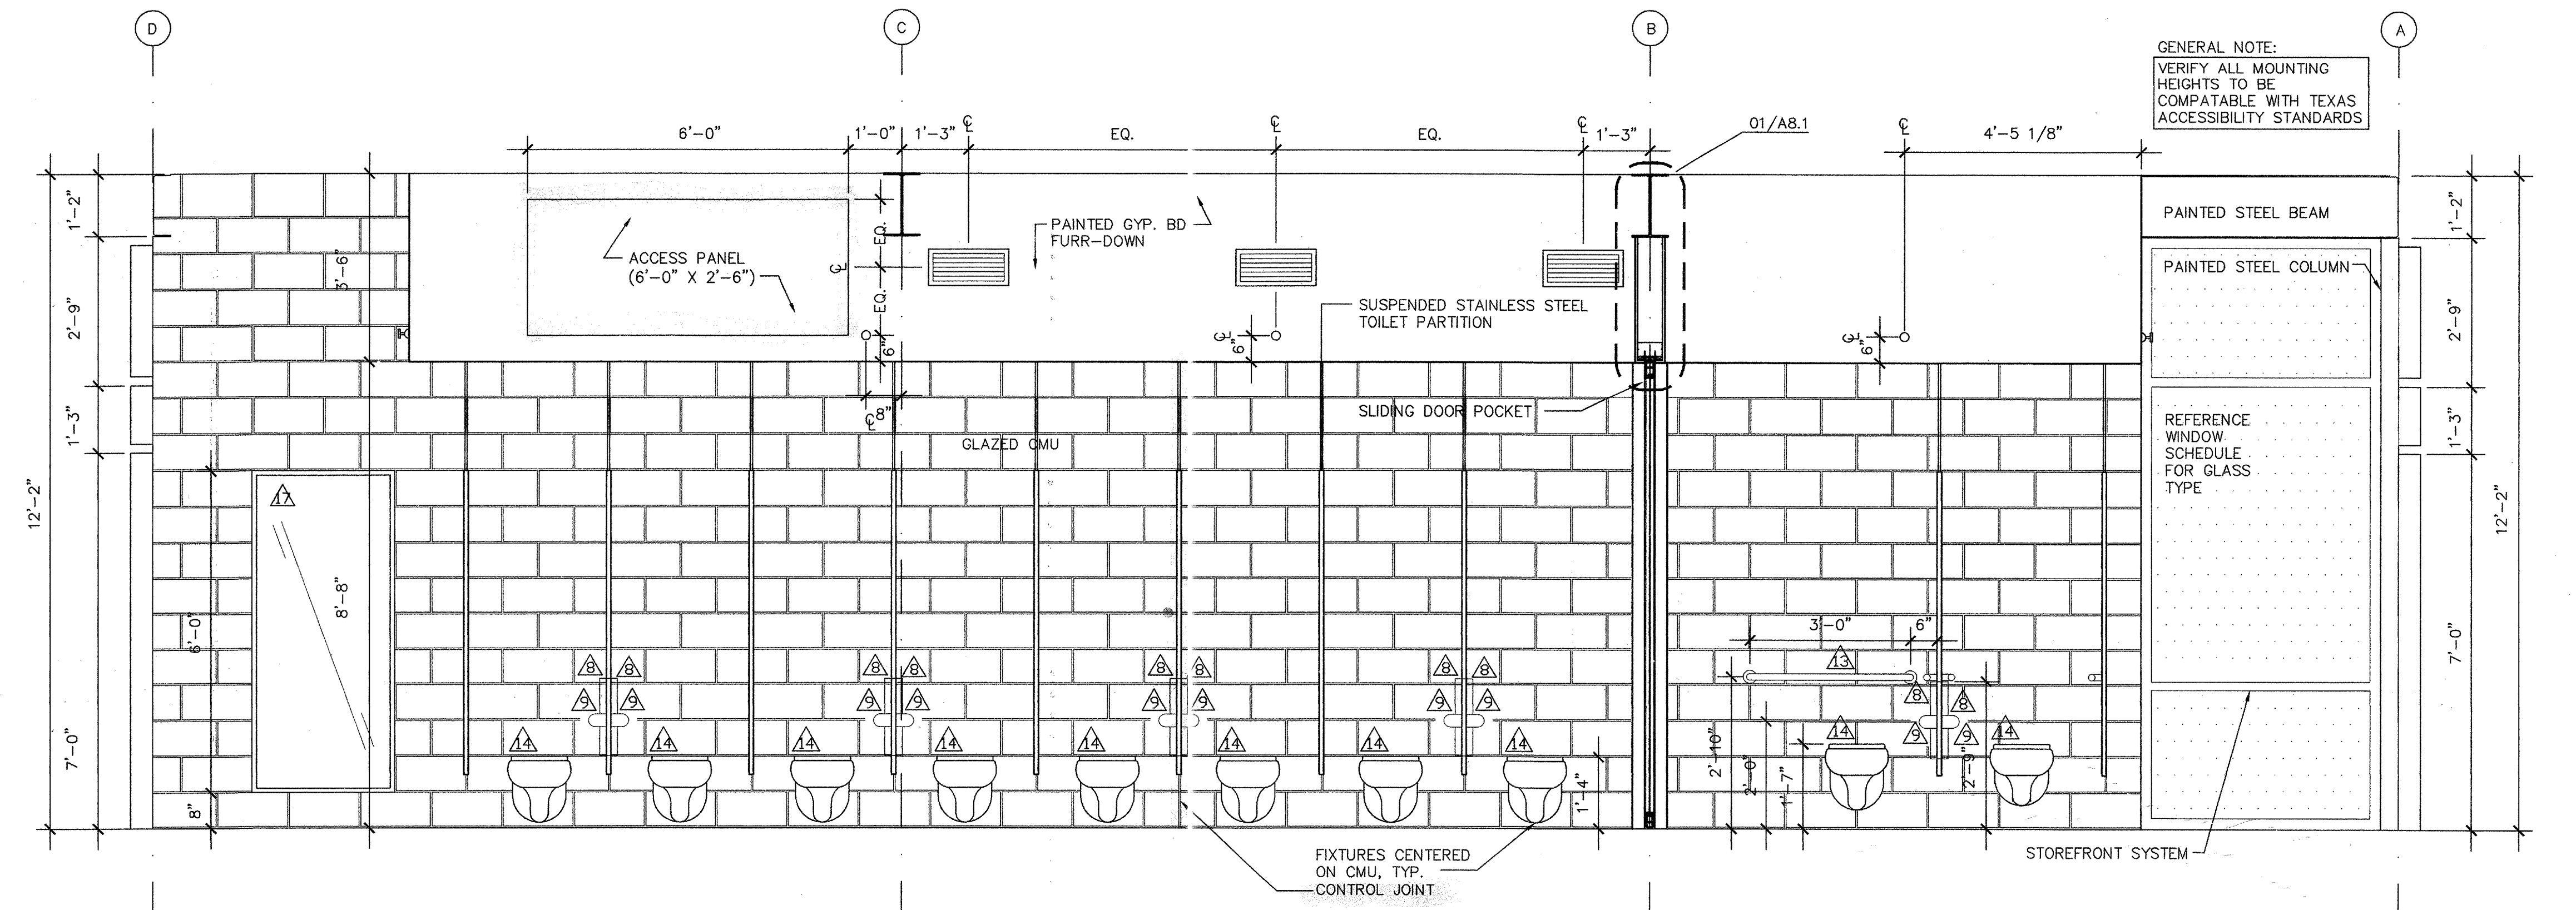

1 WEST ELEVATION
WOMEN'S ROOM

1/2"=1'-0"

GENERAL NOTE:
VERIFY ALL MOUNTING
HEIGHTS TO BE
COMPATIBLE WITH TEXAS
ACCESSIBILITY STANDARDS

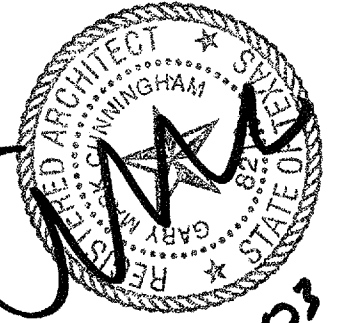

issue	date
DD	06/26/02
50% CD	11/05/02
100% CD	01/23/03
ADDENDUM 1	01/31/03
POST-BID REVISION	03/04/03