


2 SPRINKLER PLAN
PLAN 1/8"=1'-0"

CONTRACTOR TO COORDINATE WITH ALL OTHER TRADES AND ALL ARCHITECTURAL PLANS BEFORE INSTALLATION IS BEGUN. NO ADDED COST WILL BE ALLOWED FOR LACK OF COORDINATION WITH ALL PLANS AND OTHER TRADES.

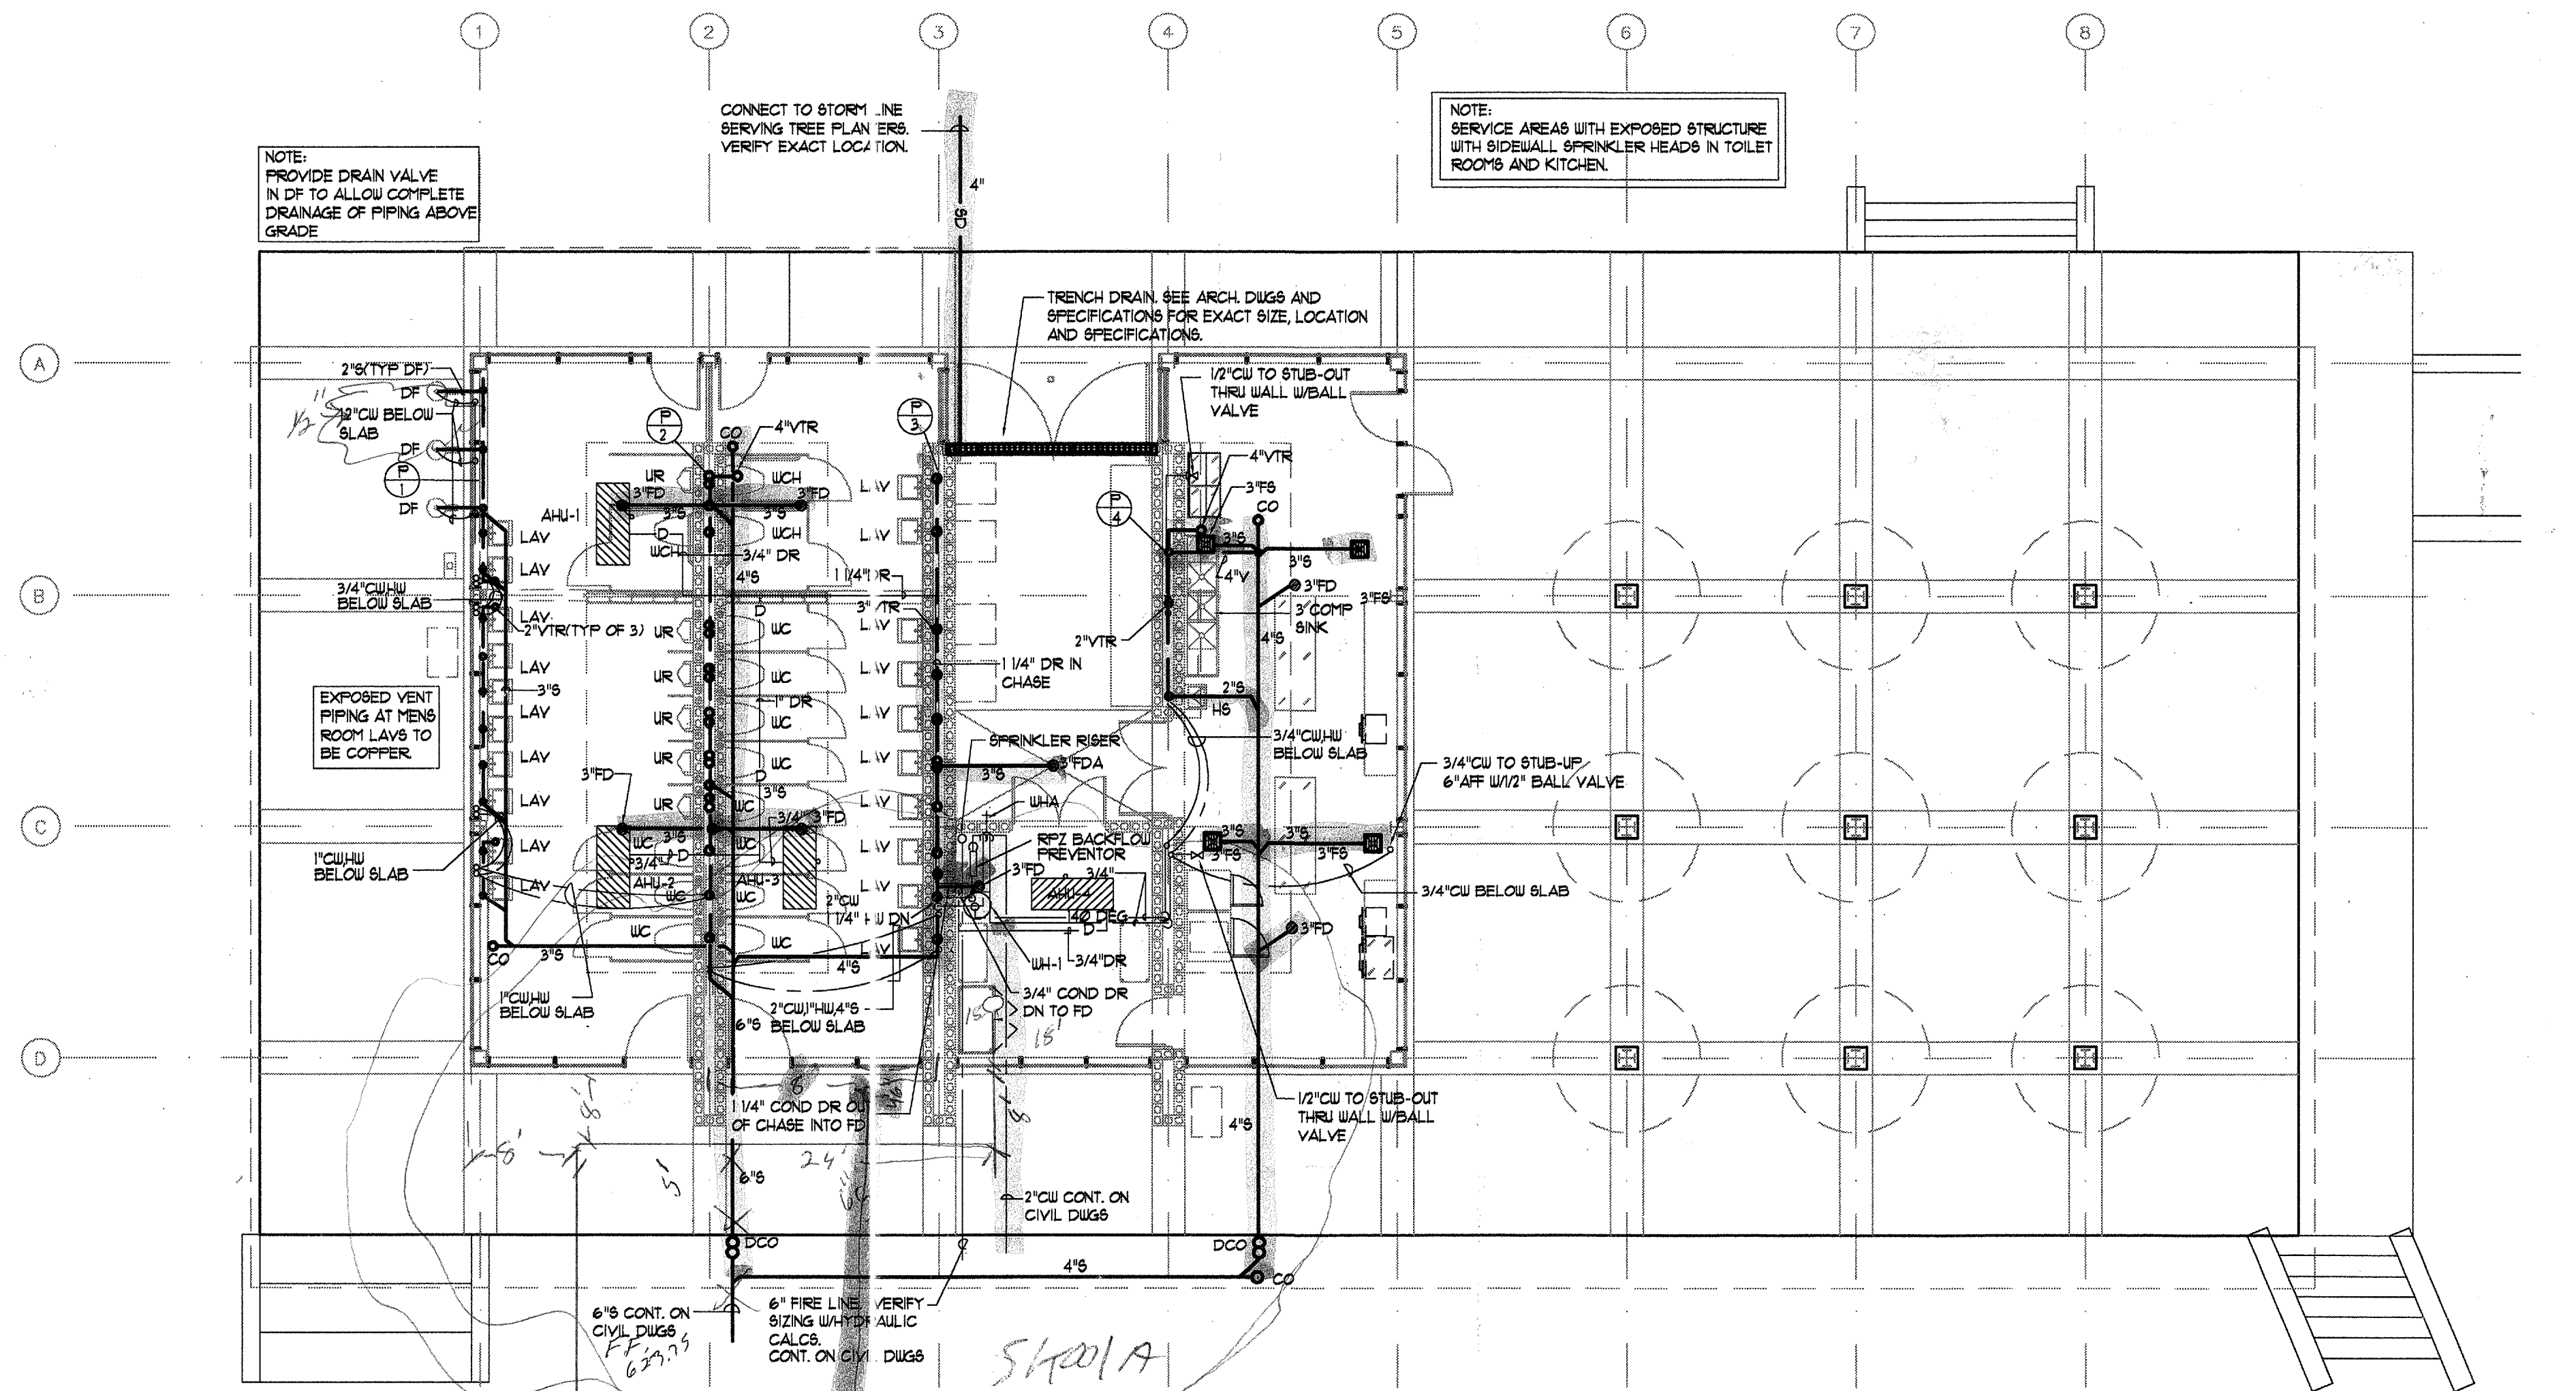

1 PLUMBING PLAN
PLAN 1/8"=1'-0"



date	issue
08/26/02	DD
10/31/02	50% CD
01/23/03	95% CD