

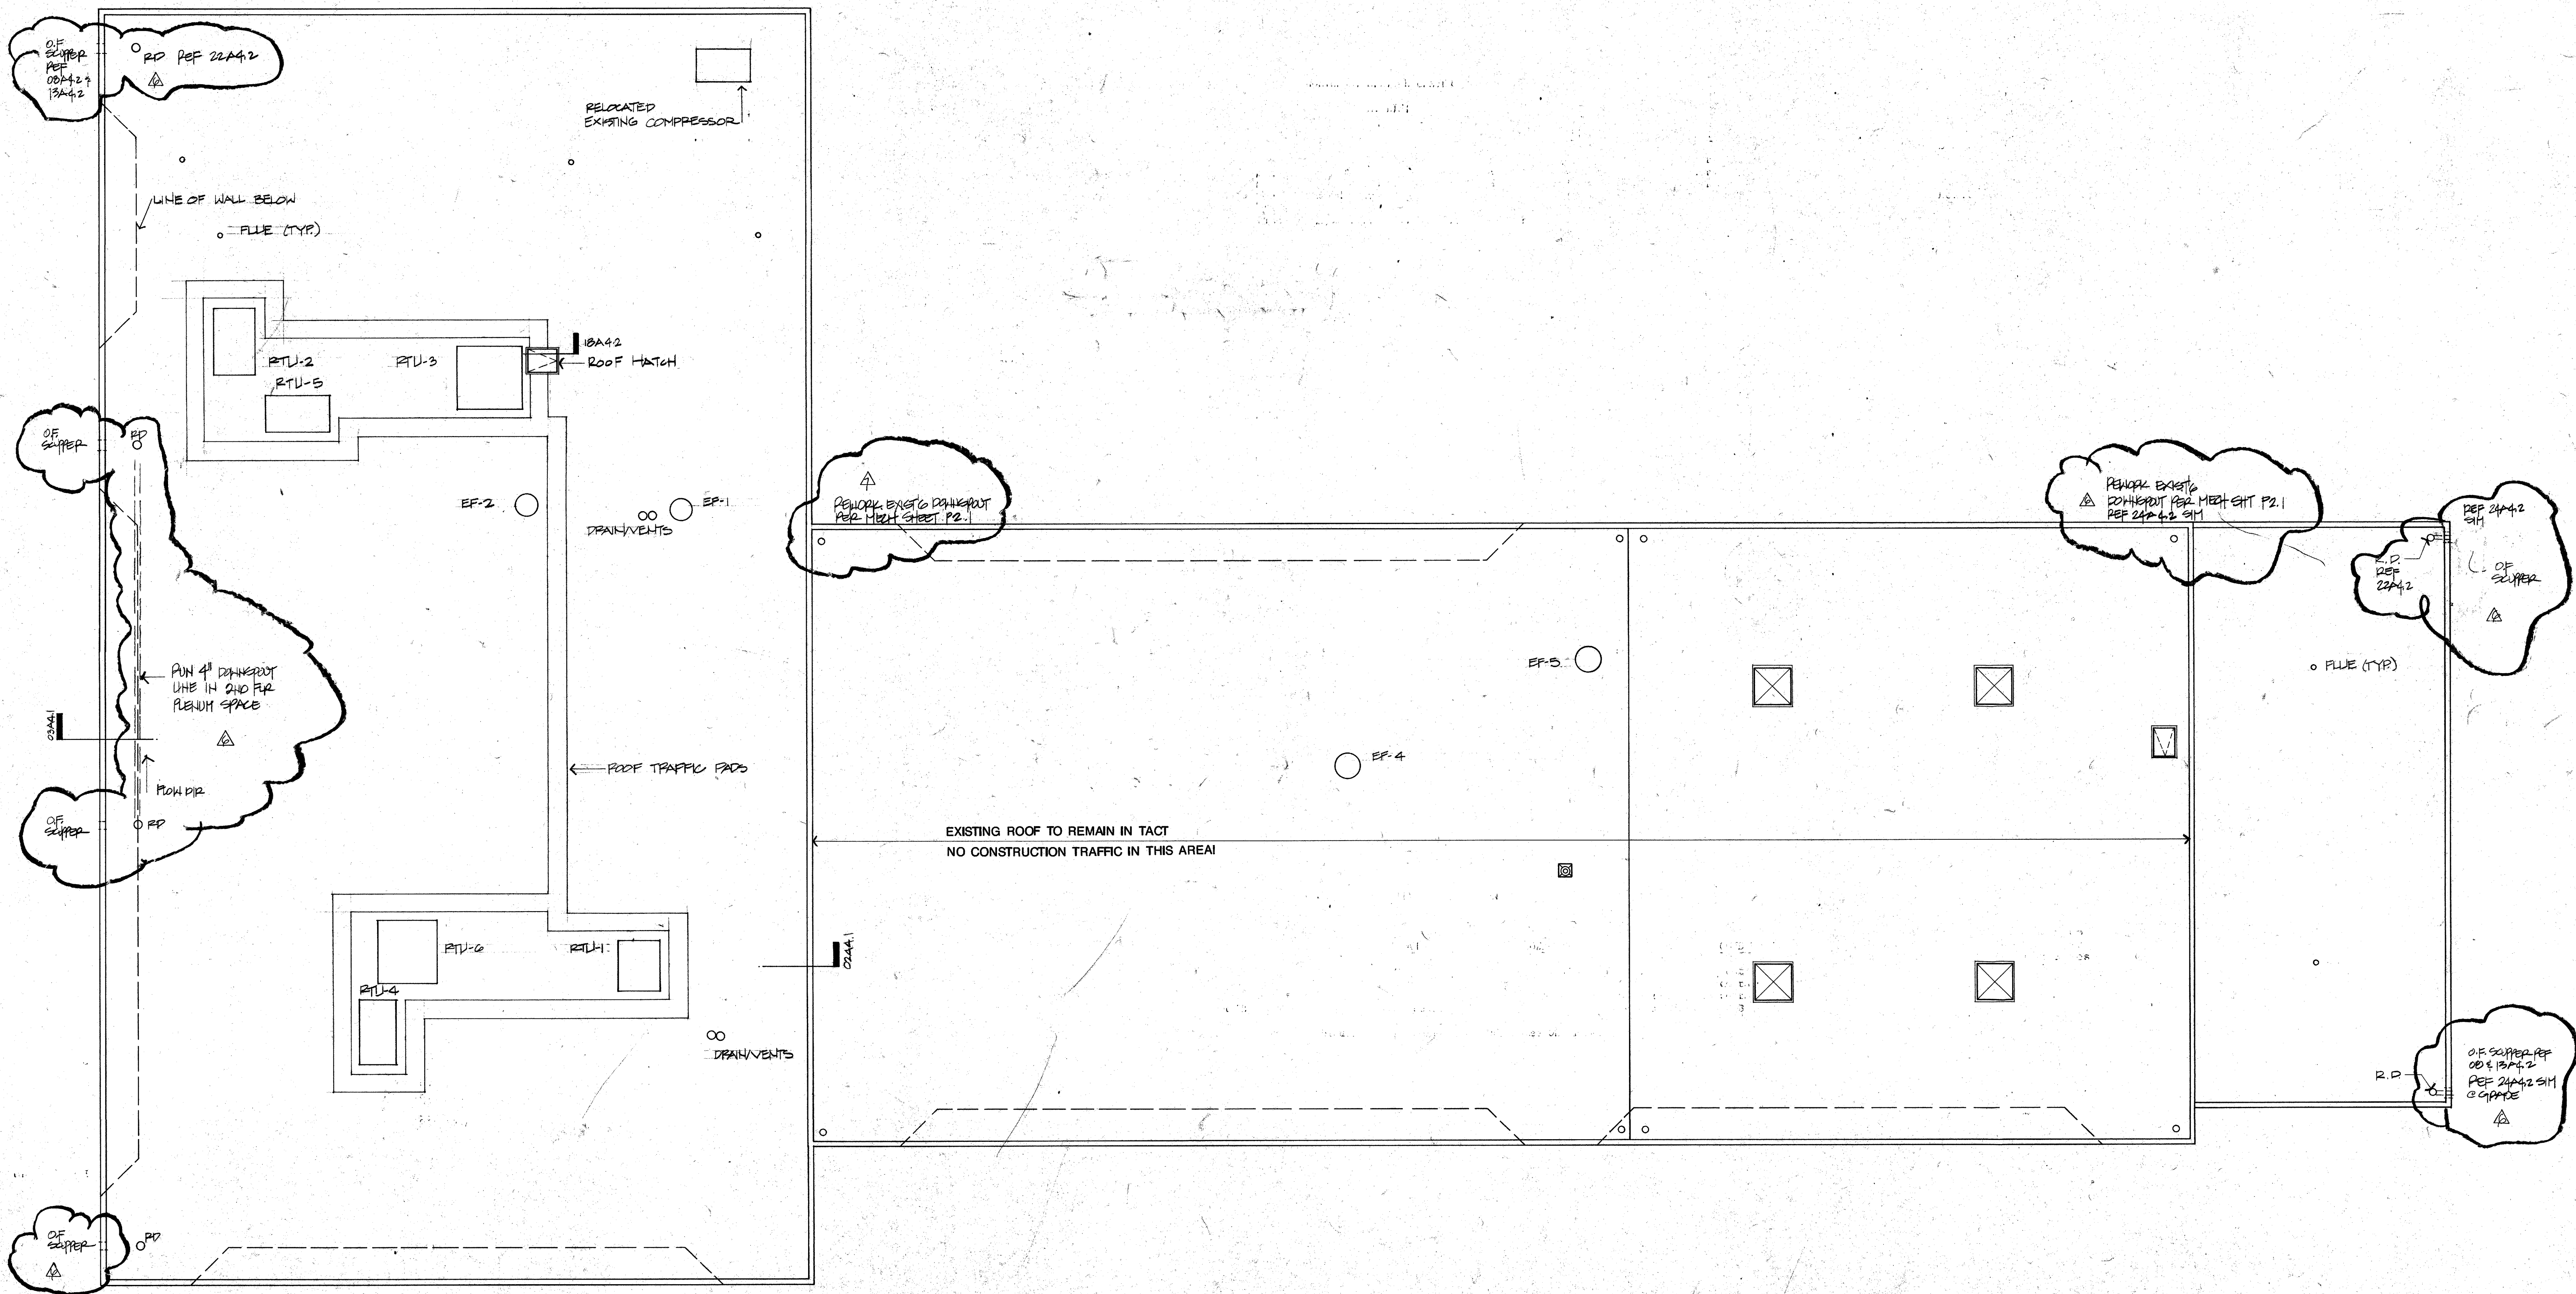


A B C D E F G H I J K L M N O P Q R S T U V W X Y Z AA BB CC DD EE FF GG HH II JJ KK LL MM NN OO PP QQ RR SS TT UU VV WW XX YY ZZ

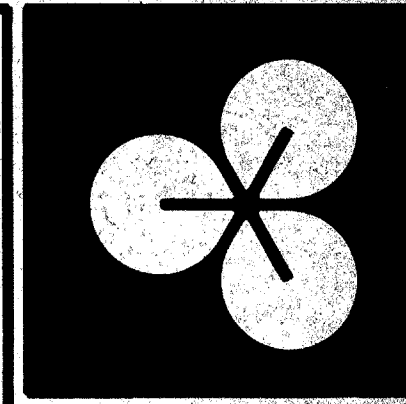

01 ROOF PLAN
A2.5 1/8"=1'-0"

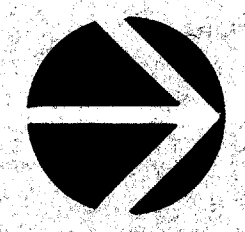

EDI ARCHITECTS, INC.
ARCHITECTURE PLANNING ENGINEERING INTERIOR DESIGN
8440 WALNUT HILL LANE
SUITE 100
DALLAS, TEXAS 75231
512 / 498-8300

TOWN OF
ADDISON

**ADDITION TO
PUBLIC WORKS SERVICE CENTER**
Westgrove Road
Addison Texas

DATE: 5-16-86
11 JUNE 86
24 JULY 1986 - BID

REV 6.7 10.07.86

SHEET NO:
A2.5
PROPOSED DEVELOPMENT
TOWN OF ADDISON SHEETS
JOB NO: 851-137