


1 DECK LAYOUT

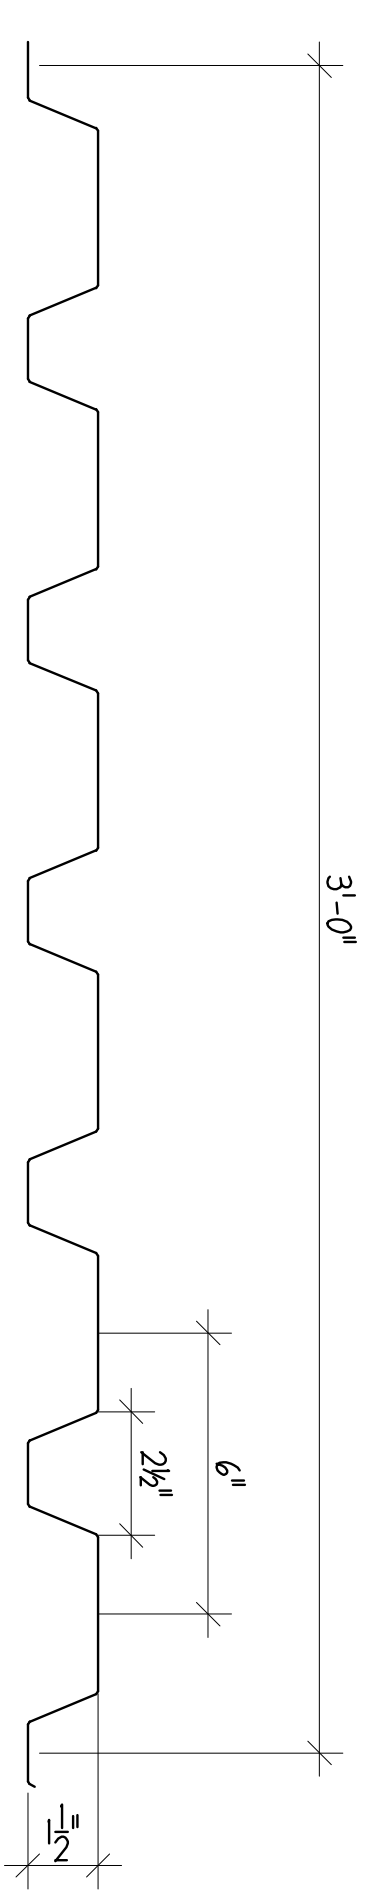

20 GA. B-DECK  
 3'-0"  
 6"  
 2 1/2"  
 1 1/2"

DECK FASTENING DETAIL

QUALITY IRONWORKS, INC. IS AN EQUAL OPPORTUNITY EMPLOYER. WE DO NOT DISCRIMINATE ON THE BASIS OF RACE, COLOR, SEX, RELIGION, NATIONAL ORIGIN, ANCESTRY, AGE, MARITAL STATUS, HANDICAP, OR OTHER PROTECTED CHARACTERISTICS. ALL EMPLOYEES MUST BE AT LEAST 18 YEARS OF AGE. QUALITY IRONWORKS, INC. IS AN EQUAL OPPORTUNITY EMPLOYER. WE DO NOT DISCRIMINATE ON THE BASIS OF RACE, COLOR, SEX, RELIGION, NATIONAL ORIGIN, ANCESTRY, AGE, MARITAL STATUS, HANDICAP, OR OTHER PROTECTED CHARACTERISTICS. ALL EMPLOYEES MUST BE AT LEAST 18 YEARS OF AGE.

**Quality Ironworks, Inc.**  
 1507 W. Commerce St.  
 Dallas, Tx 75208  
 Phone: (214) 688-0180  
 Fax: (214) 688-0281

ENGINEER SEAL

NO.	DATE	REVISIONS	DRAWN/CHK'D
1	8/21/12	FOR APPROVAL	CP
2	9/18/12	FOR FIELD USE	CP
3	1/7/13	AS BUILT	CP

NO.	DATE	REVISIONS	DRAWN/CHK'D
1	8/21/12	FOR APPROVAL	CP
2	9/18/12	FOR FIELD USE	CP
3	1/7/13	AS BUILT	CP

DATE: 8/15/12

CHECKED BY: CP

DRAWN BY: CP

JOB NO.: 31157

QI WORKS

VITRUVIAN PARK  
 VITRUVIAN WAY  
 ADDISON, TEXAS  
 ANDRES CONSTRUCTION  
 PARK RESTROOM

SHEET NO:  
**E1.1**