


1 BUILDING SECTION

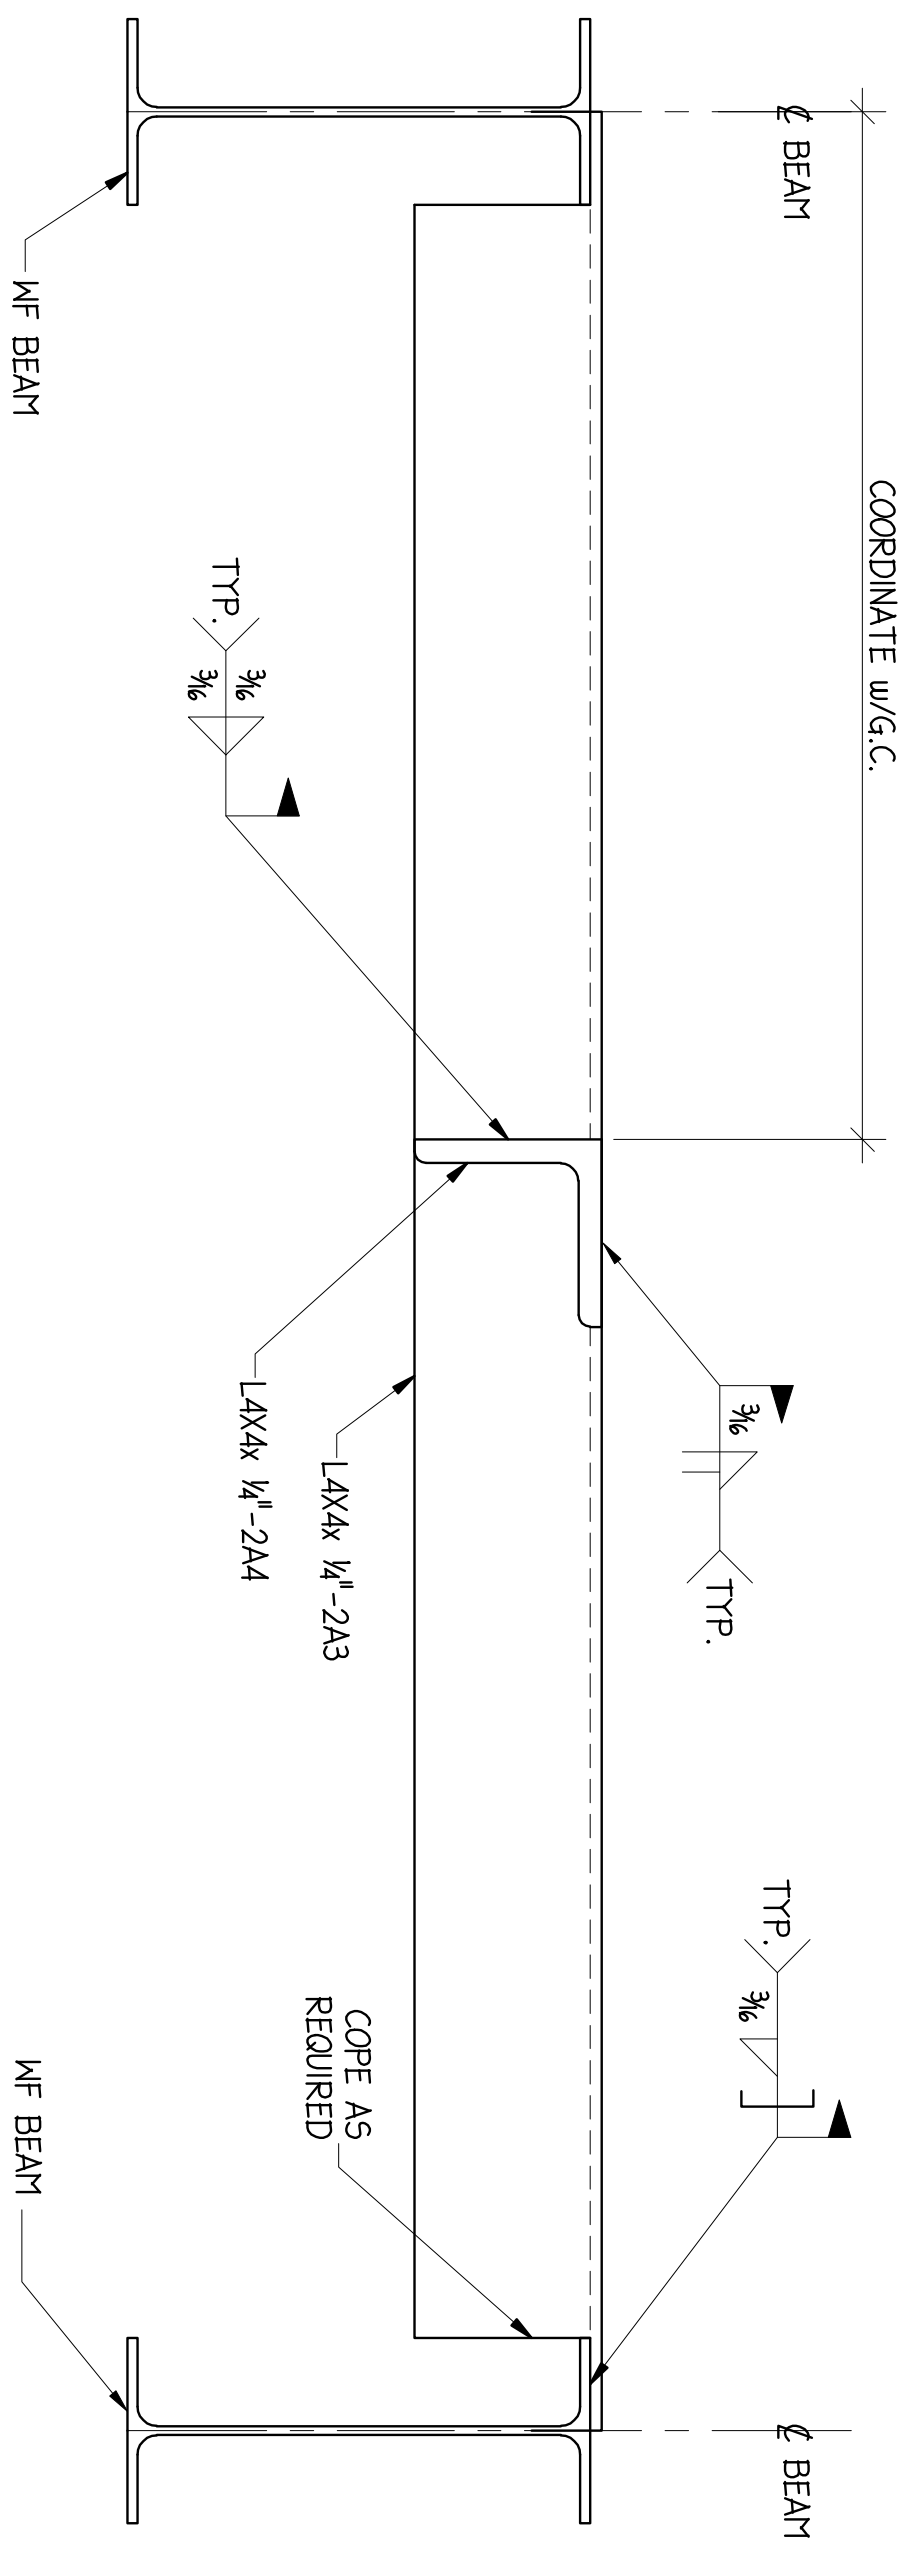

2 SKYLIGHT DETAIL

NO.	DATE	REVISIONS	DRAWN	CHK'D
1	8/21/12	FOR APPROVAL	CP	
2	9/18/12	FOR FIELD USE	CP	
3	1/7/13	A5 BUILT	CP	
4				
5				

QI WORKS
 JOB NO.: 31157
 DRAWN BY: CP
 CHECKED BY:
 DATE: 8/15/12

ENGINEER SEAL

 I, _____, a duly Licensed Professional Engineer in the State of Texas, hereby certify that I am the author of the design and drawings herein, and that I am a duly Licensed Professional Engineer in the State of Texas. My License No. is _____, and it expires on _____, 20____. I am not providing any services for this project outside of my license. I am not providing any services for this project outside of my license. I am not providing any services for this project outside of my license.

Quality Ironworks, Inc.
 1607 W. Commerce St.
 Dallas, Tx 75208
 Phone: (214) 688-0180
 Fax: (214) 688-0281

VITRUVIAN PARK
 VITRUVIAN WAY
 ADDISON, TEXAS
 ANDRES CONSTRUCTION
 PARK RESTROOM
 SHEET NO: **E2.1**