


**BENCHMARK:**  
SQUARE CUT ON INLET AT S.W. CORNER OF SOJOURN DR. AND ADDISON RD. ELEV. 641.95

**LEGEND:**

	EXISTING	PROPOSED
PROPERTY LINE	---	---
BUILDING LINE	---	---
SANITARY SEWER	8" SS	4" W
WATER	8" W	4" W
FIRE HYDRANT	⊙	⊙
WATER METER	⊙	⊙
WATER VALVE	⊙	⊙
REDUCER	⊙	⊙
POWER POLE	⊙	⊙
POWER POLE W/ STREET LIGHT	⊙	⊙
SEWER MANHOLE	⊙	⊙
SIGN POST	⊙	⊙
ELEC. JUNCTION BOX	⊙	⊙
ELEC. GUY WIRE	⊙	⊙
GAS	⊙	⊙
IRRIGATION METER	⊙	⊙
TAPPING SLEEVE & VALVE	⊙	⊙
TSV	⊙	⊙

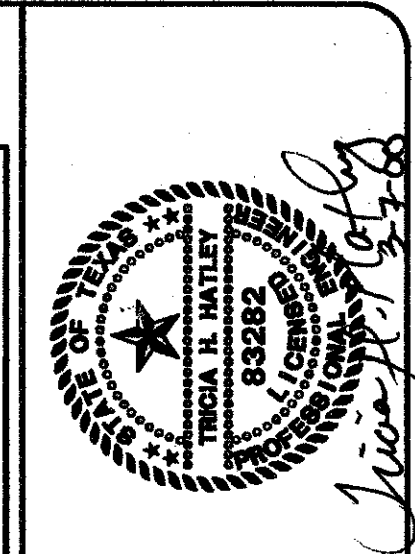

**FREESE NICHOLS**  
1541 W. Montford Lane, Suite 230-E  
Addison, TX 75001  
214-920-2500

OMNIPLAN ARCHITECTS  
**SOJOURN OFFICE CENTER**  
ADDISON, TEXAS  
SITWORK PLANS  
**UTILITY PLAN**

REVISION	DATE	BY	FILE	DATE	DESIGNED	DRAWN	CHECKED	THH
1	4/30/99	MW	206/UTIL	6/3/99	MW	GAH		
2	7/28/99	OG		7-28-99	MW	GAH		

Bar is one inch on original drawing if not one inch on this sheet, adjust scale.

SHEET **C-10**  
SEQ. 13 OF 16

**"AS-BUILTS"**