


- 16 REINFORCED EARTH SECTION, TYPICAL (C7-1)
- 11 TRASH RECEPTACLE, TYPICAL (C7-2)
- 3 EXPOSED AGGREGATE PAVING (C7-1)
- 2 PEDESTRIAN LIGHT POLE FOUNDATION (C7-3)
- 2 FENCE ELEVATION AND SECTION, TYP. (C7-5)
- 2 CONCRETE PAVING (C7-1)
- 14 INTEGRAL CURB AND GUTTER, TYP. (C7-1)

BULLETIN #2	03-10-03	
BULLETIN #1	12-30-02	
ISSUED FOR CONSTRUCTION	11-26-02	
ISSUED FOR CONSTRUCTION	09-30-02	
No.	Description	Date

DWG ISSUE & REVISION HISTORY

Stamp

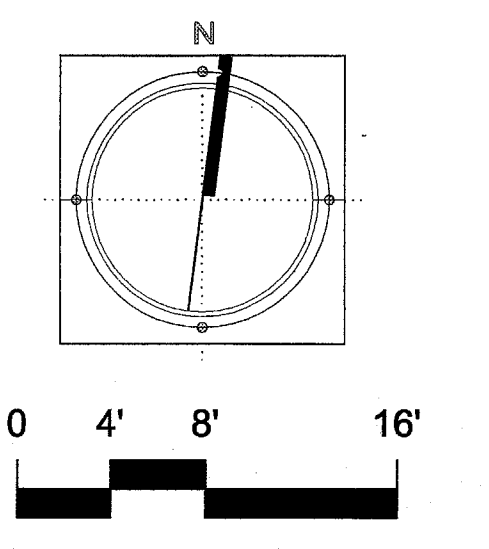

Project Title:
ADDISON ARTS & EVENTS DISTRICT
 ADDISON, TEXAS

Drawing Title:
MATERIALS PLAN DETAIL

Project No. 14516.00 Scale: 1/8"=1'-0"
 Drawn By: CB
 Checked By: DC
 Approved By: SEH
 Date: September 30, 2002

Drawing No. **C5-2**