

SEE SHEET NO. 110 FOR GENERAL NOTES

RECORD DRAWING 5/1/98


ADDENDUM #4 2/16/96
 ADDENDUM #2 1/22/96

LEGEND

ELECTRIC	— OHE —	MISC.	— 48" RCP —
○	LIGHT POLE	— EX. STORM SEWER	— CHAIN LINK FENCE
pp	POWER POLE	— WOOD FENCE	— EXISTING ASPHALT
—	GUY WIRE	— EXISTING DIRT OR GRAVEL	— EX. CONCRETE
TELEPHONE	— T —	— TREE/TREE LINE	— EX. CURB
●	TELEPHONE MANHOLE	— PROP. EDGE OF PAVEMENT NO CURB	— EX. PROPERTY LINE
□	TELEPHONE PEDESTAL	— PROP. CENTERLINE	— PROP. R.O.W.
TS	TELEPHONE SIGN	— PROP. INLET	— T.P. TOP OF PAVEMENT
GM	GAS METER	— T.C. TOP OF CURB	— C.R. CURB RETURN
GS	GAS SIGN	— EX. GUTTER	— B-20 BORING LOCATION
LAND USE	— G —	—	
R/R	RAILROAD SIGN		
△	SIGN		
SURVEY			
I.R.	FOUND IRON ROD		
■	TEMP BENCHMARK		
WW	WASTEWATER		
MH	WASTEWATER MANHOLE		
CO	CLEANOUT		
○	WATER		
FH	FIRE HYDRANT		
WM	METER		
T	WATER VALVE		

TOWN OF ADDISON
SPECIAL EVENTS AREA

MATCH LINE 'B' STA. 3+50

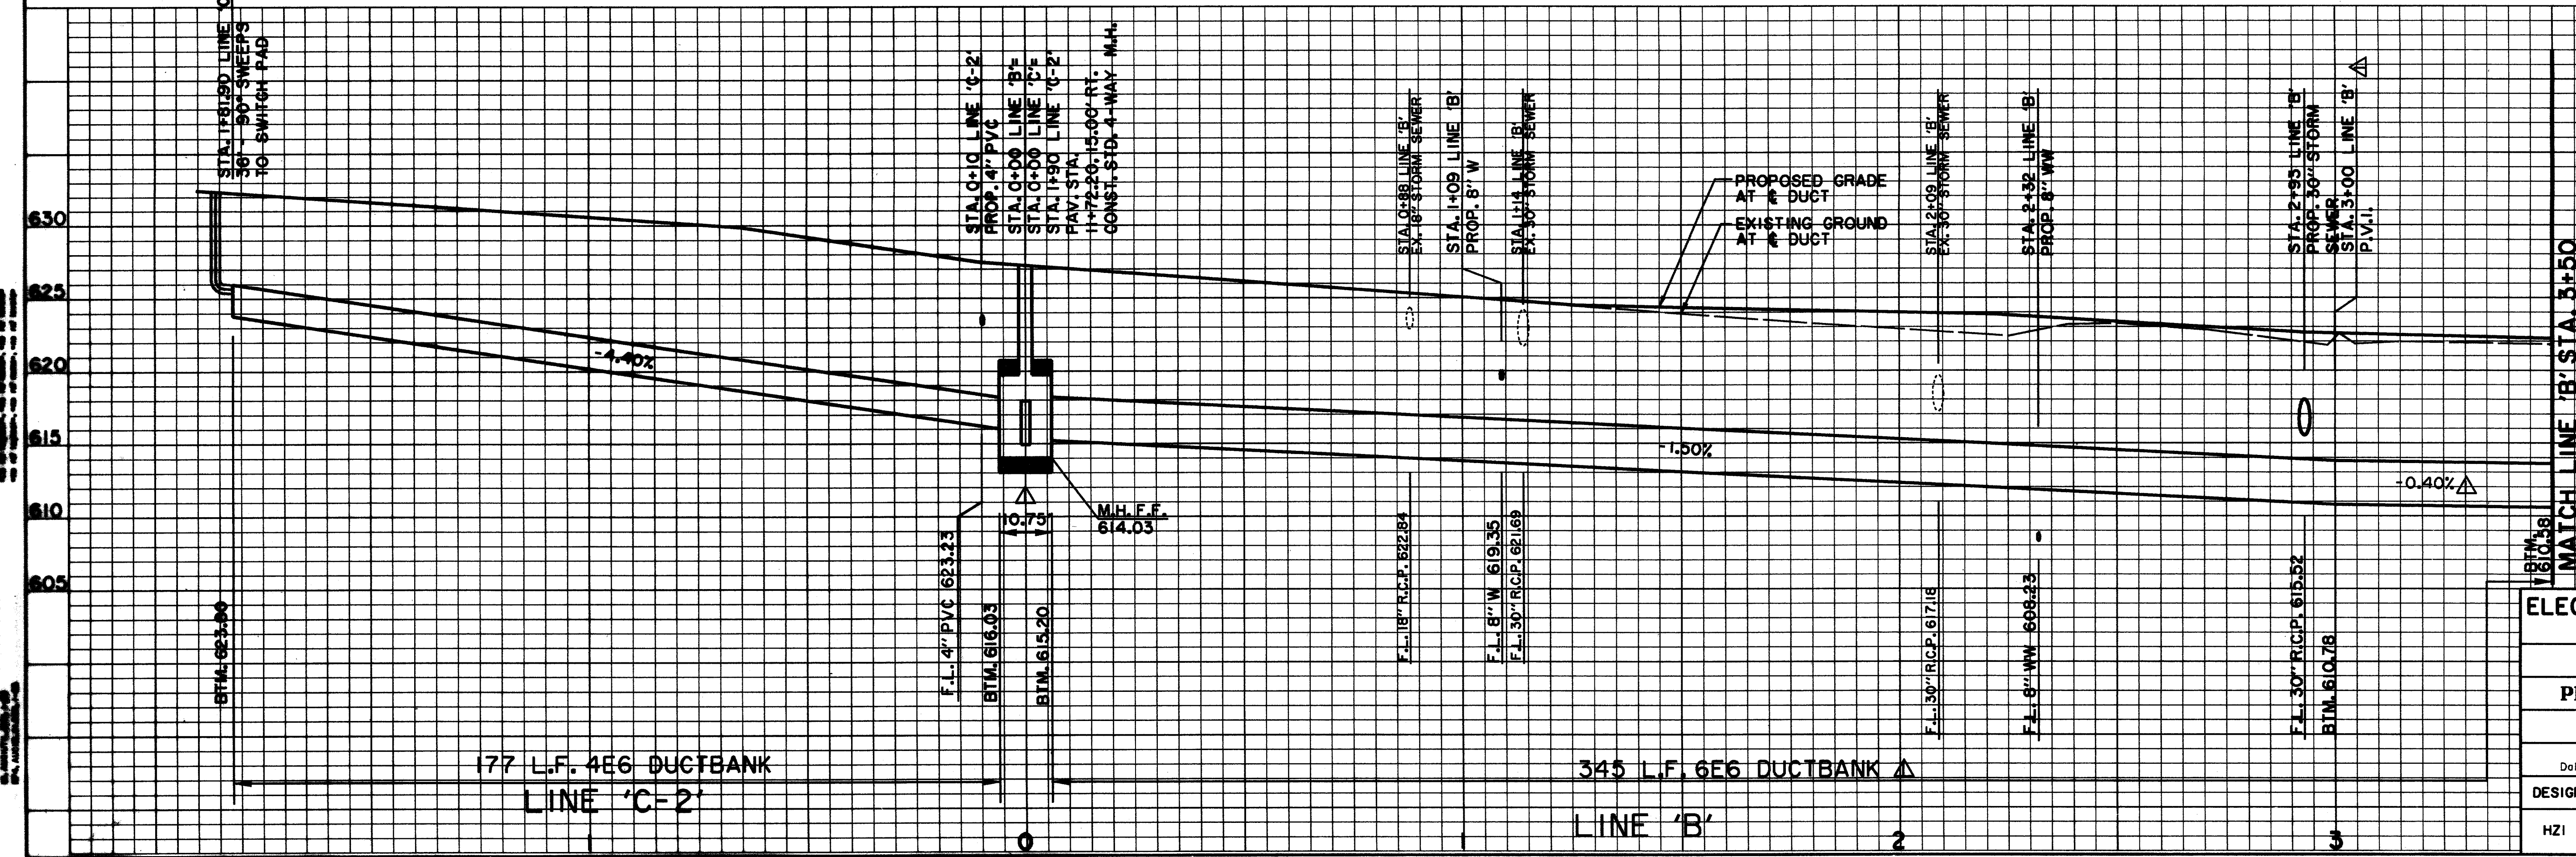


BENCHMARKS:

635	BM#1 "I" CUT AT CENTER BACK OF CURB OF INLET, 190 FEET SOUTH FROM THE CENTERLINE INTERSECTION OF ADDISON CIRCLE, WEST SIDE OF QUORUM DRIVE. ELEV. 621.89
630	BM#2 "I" CUT AT CENTER BACK OF CURB OF INLET, 200 FEET NORTH FROM THE CENTERLINE INTERSECTION OF ADDISON CIRCLE, WEST SIDE OF QUORUM DRIVE. ELEV. 621.68

ISSUED FOR CONSTRUCTION
MARCH 28, 1996

THE SEAL APPEARING ON THIS DOCUMENT WAS AUTHORIZED BY
KENNETH A. ROBERTS, P.E. 55446
ON MARCH 28, 1996.

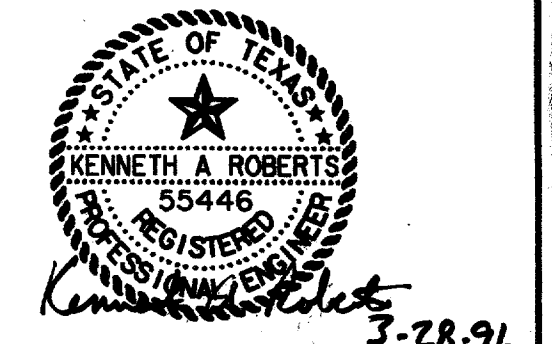

ELECTRICAL DUCTBANK PLAN & PROFILE
LINE 'B'
ADDISON CIRCLE
PHASE 1 PUBLIC INFRASTRUCTURE
TOWN OF ADDISON, TEXAS

Hutt-Zollars, Inc./Engineering/Architecture
 Dallas, Fort Worth, Houston, El Paso, Phoenix, Tustin, Ontario, San Clemente

DESIGN	DRAWN	APPR.	SCALE	DATE	PROJECT NO.	NO.
HZI	HZI	KAR	H ₂ 1"=20' V ₂ 1"=6'	JAN. 96	1822-06	106

137