
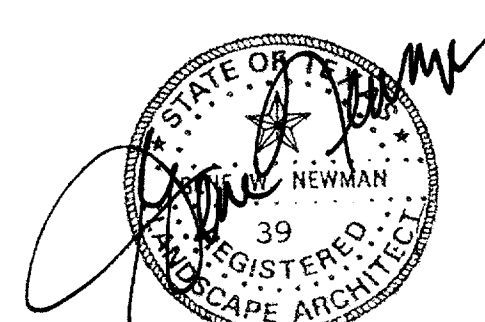


? See P 122

2 A

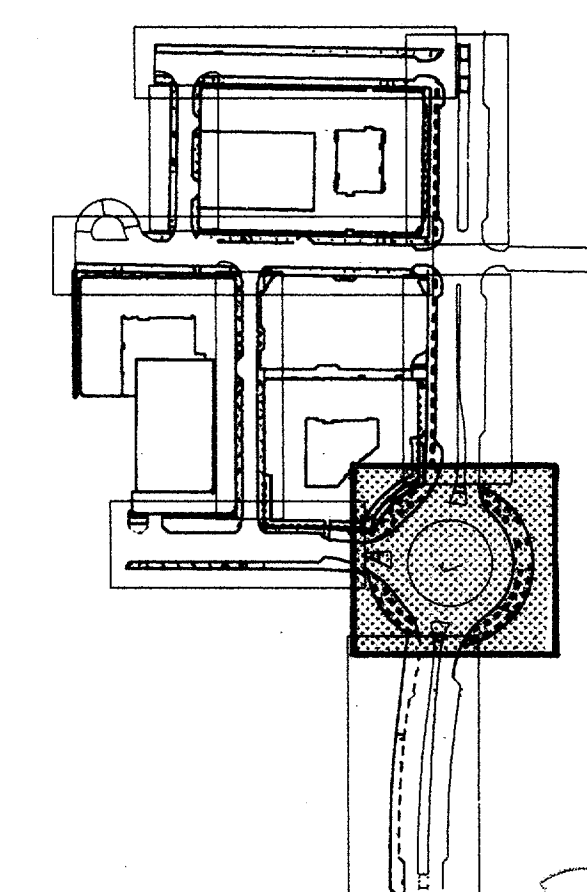

**Newman, Jackson, Bieberstein, Inc.**  
 Landscape Architecture Urban and Development Planning  
 12710 Cott Road, Suite 210 Dallas, Texas (214) 299-2095 Fax (214) 299-2022



Planting & Furniture Plan  
**ADDISON CIRCLE**

PHASE 1

TOWN OF ADDISON, TEXAS

Huitt-Zullars, Inc./Engineering/Architecture  
 Dallas, Fort Worth, Houston, El Paso, Phoenix, Austin, Ontario, San Clemente

DESIGN	DRAWN	APPR.	SCALE	DATE	PROJECT NO.	NO.
PS	TS	GN	1" = 20'-0"	12-4-95	0030-95	123 137

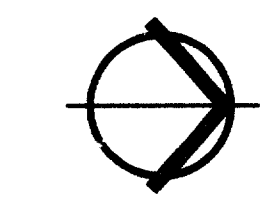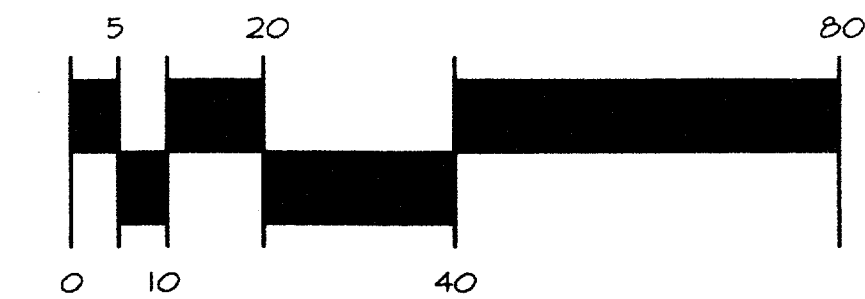

RECORD DRAWING 5/1/98

Revisions:  
 1-22-96 Addendum #2

Issued for Construction  
 March 28, 1996