
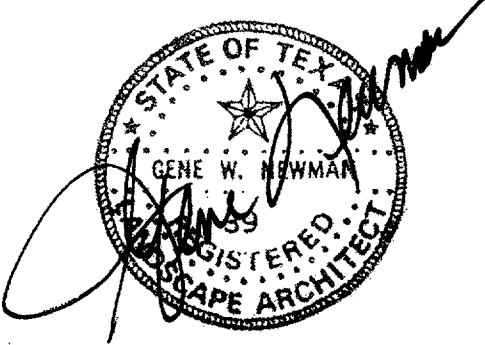
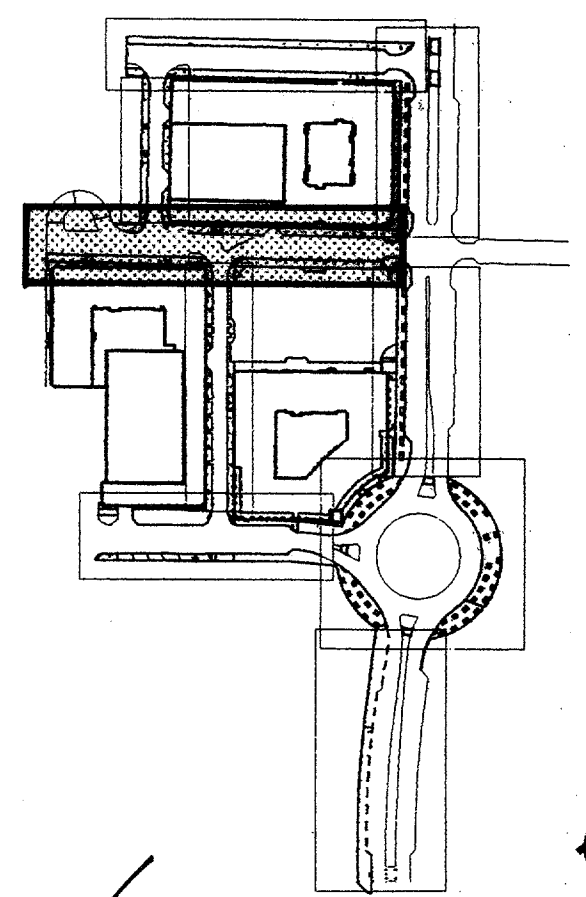


All existing landscaping and irrigation disrupted/destroyed by utility construction around the water tower shall be repaired per the Town of Addison landscape and irrigation specifications. All turf areas shall be tilled to a depth of 4 inches, raked smooth and solid sodded with Buffalo grass approved by the Town of Addison.

what is depth of hole?

Bob see sch. for consistent

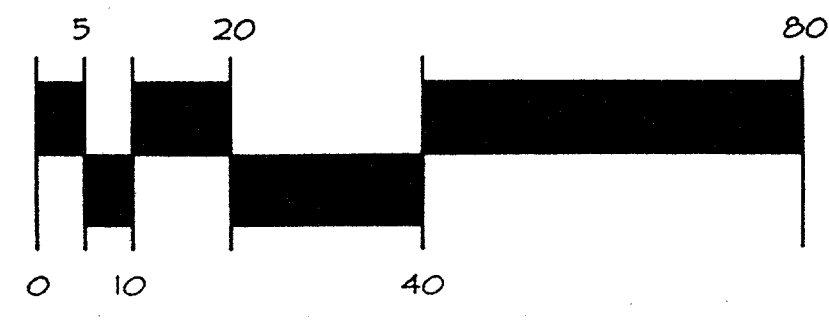

Newman, Jackson, Bieberstein, Inc.
Landscape Architecture Urban and Development Planning
12710 Colt Road, Suite 210 Dallas, Texas (214) 233-2033 Fax (214) 233-2022

Planting & Furniture Plan						
ADDISON CIRCLE						
PHASE 1						
TOWN OF ADDISON, TEXAS						
Hutt-Zollars, Inc./Engineering/Architecture Dallas, Fort Worth, Houston, El Paso, Phoenix, Tustin, Ontario, San Clemente						
DESIGN	DRAWN	APPR.	SCALE	DATE	PROJECT NO.	NO.
PS	TS	GN	1" = 20'-0"	12-4-95	0030-95	126 137

Issued for Construction
March 28, 1996

RECORD DRAWING 5/1/98
Revisions:
Δ 1-22-96 Addendum #2