


LEGEND

ELECTRIC — OH —	48" RCP	MISC.
○ LIGHT POLE	— EX. STORM SEWER	— CHAIN LINK FENCE
□ POWER POLE	— CHAIN LINK FENCE	— WOOD FENCE
— GUY WIRE	— EXISTING ASPHALT	— EXISTING DIRT OR GRAVEL
TELEPHONE — T —	— EX. CONCRETE	— TREE/TREE LINE
● TELEPHONE MANHOLE	— EX. PROPERTY LINE	— PROP. CENTERLINE
□ TELEPHONE PEDESTAL	— PROP. R.O.W.	— PROP. R.O.W.
— TELEPHONE SIGN	— TOP OF PAVEMENT	— T.P. CUT
GAS — G —	— TOP OF CURB	— C.R. CURB
○ GAS METER	— EX. PROPERTY LINE	— EX. GUTTER
— GAS SIGN	— PROP. R.O.W.	— BORING LOCATION
LAND USE	— PROP. R.O.W.	— B-20
— RAILROAD SIGN	— PROP. R.O.W.	
— SIGN	— PROP. R.O.W.	
SURVEY	— PROP. R.O.W.	
— FOUND IRON ROD	— PROP. INLET	
— TEMP BENCHMARK	— T.P. CUT	
WASTEWATER — WW —	— C.R. CURB	
● WASTEWATER MANHOLE	— EX. GUTTER	
— CLEANOUT	— BORING LOCATION	
WATER — W —		
— FIRE HYDRANT		
— METER		
— WATER VALVE		

NOTE: SIDEWALK BEYOND RIGHT OF WAY TO BE CONSTRUCTED BY OTHERS WITH THE ADDISON CIRCLE APARTMENTS PRIVATE DEVELOPMENT. CONTRACTOR SHALL COORDINATE INTERFACE IN THE FIELD. SEE SIDEWALK DETAILS IN THIS PLAN SET.

- NOTES:**
1. SEE DEMOLITION PLAN FOR PAVEMENT REMOVAL LIMITS.
 2. SEE SURFACE PATTERNING PLANS FOR BRICK PATTERNS AND SLOPES.
 3. POUR SIDEWALK AROUND NOTED LEAVEOUTS PER LOCATIONS ON STREETScape PLANS.

RECORD DRAWING 5/1/98
 DELETED DETECTABLE WARNING STRIP 11/8/96
 REVISED LEAVEOUTS ON WITT PLACE 5/13/96
 ADDENDUM #4 2/16/96
 ADDENDUM #2 1/22/96

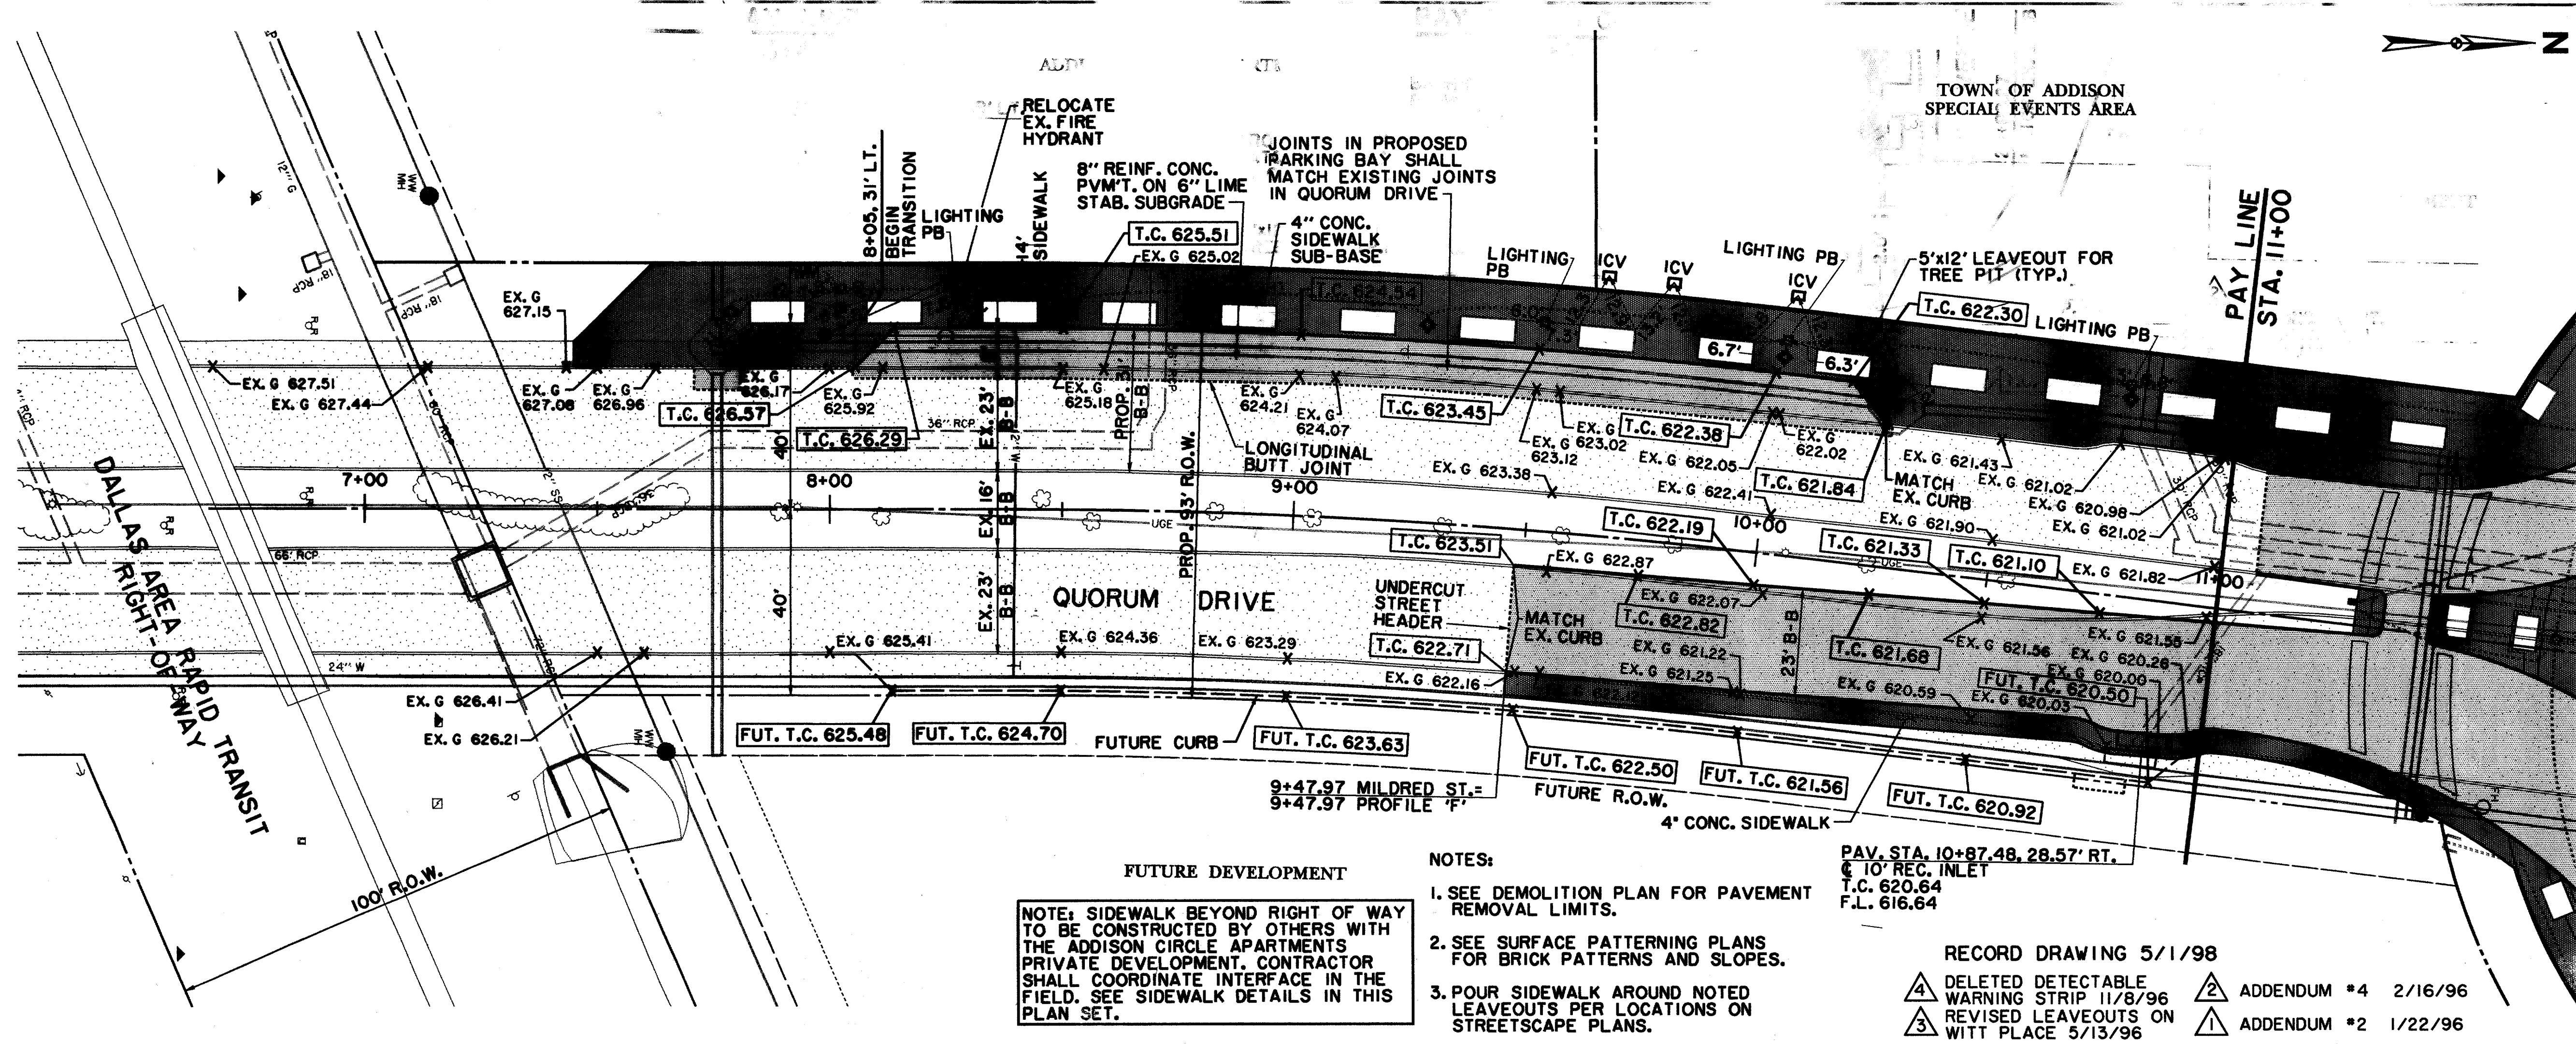

NOTE: SIDEWALK BEYOND RIGHT OF WAY TO BE CONSTRUCTED BY OTHERS WITH THE ADDISON CIRCLE APARTMENTS PRIVATE DEVELOPMENT. CONTRACTOR SHALL COORDINATE INTERFACE IN THE FIELD. SEE SIDEWALK DETAILS IN THIS PLAN SET.

- NOTES:**
1. SEE DEMOLITION PLAN FOR PAVEMENT REMOVAL LIMITS.
 2. SEE SURFACE PATTERNING PLANS FOR BRICK PATTERNS AND SLOPES.
 3. POUR SIDEWALK AROUND NOTED LEAVEOUTS PER LOCATIONS ON STREETScape PLANS.

RECORD DRAWING 5/1/98
 DELETED DETECTABLE WARNING STRIP 11/8/96
 REVISED LEAVEOUTS ON WITT PLACE 5/13/96
 ADDENDUM #4 2/16/96
 ADDENDUM #2 1/22/96


BENCHMARKS:

BM#1
 "C" CUT AT CENTER BACK OF CURB OF INLET, 190 FEET SOUTH FROM THE CENTERLINE INTERSECTION OF ADDISON CIRCLE, WEST SIDE OF QUORUM DRIVE.
 ELEV. 621.89

BM#2
 "C" CUT AT CENTER BACK OF CURB OF INLET, 200 FEET NORTH FROM THE CENTERLINE INTERSECTION OF ADDISON CIRCLE, WEST SIDE OF QUORUM DRIVE.
 ELEV. 621.68

ISSUED FOR CONSTRUCTION MARCH 28, 1996

THE SEAL APPEARING ON THIS DOCUMENT WAS AUTHORIZED BY KENNETH A. ROBERTS, P.E. 55446 ON MARCH 28, 1996.

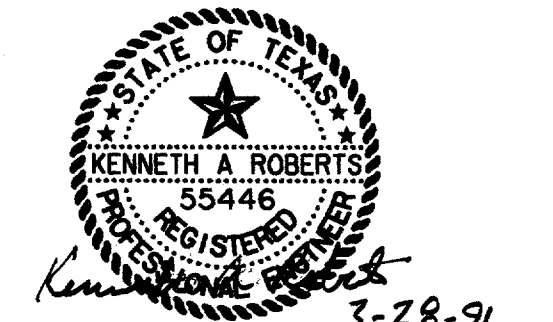

PAVING PLAN
ADDISON CIRCLE & QUORUM DRIVE
ADDISON CIRCLE
PHASE I PUBLIC INFRASTRUCTURE
TOWN OF ADDISON, TEXAS

Huii-Zollars, Inc./Engineering/Architecture
 Dallas, Fort Worth, Houston, El Paso, Phoenix, Tustin, Ontario, San Clemente

DESIGN	DRAWN	APPR.	SCALE	DATE	PROJECT NO.	NO.
HZI	HZI	KAR	1"=20'	JAN 96	1822-04	19