


FOR REVISIONS
 DATE
 BY

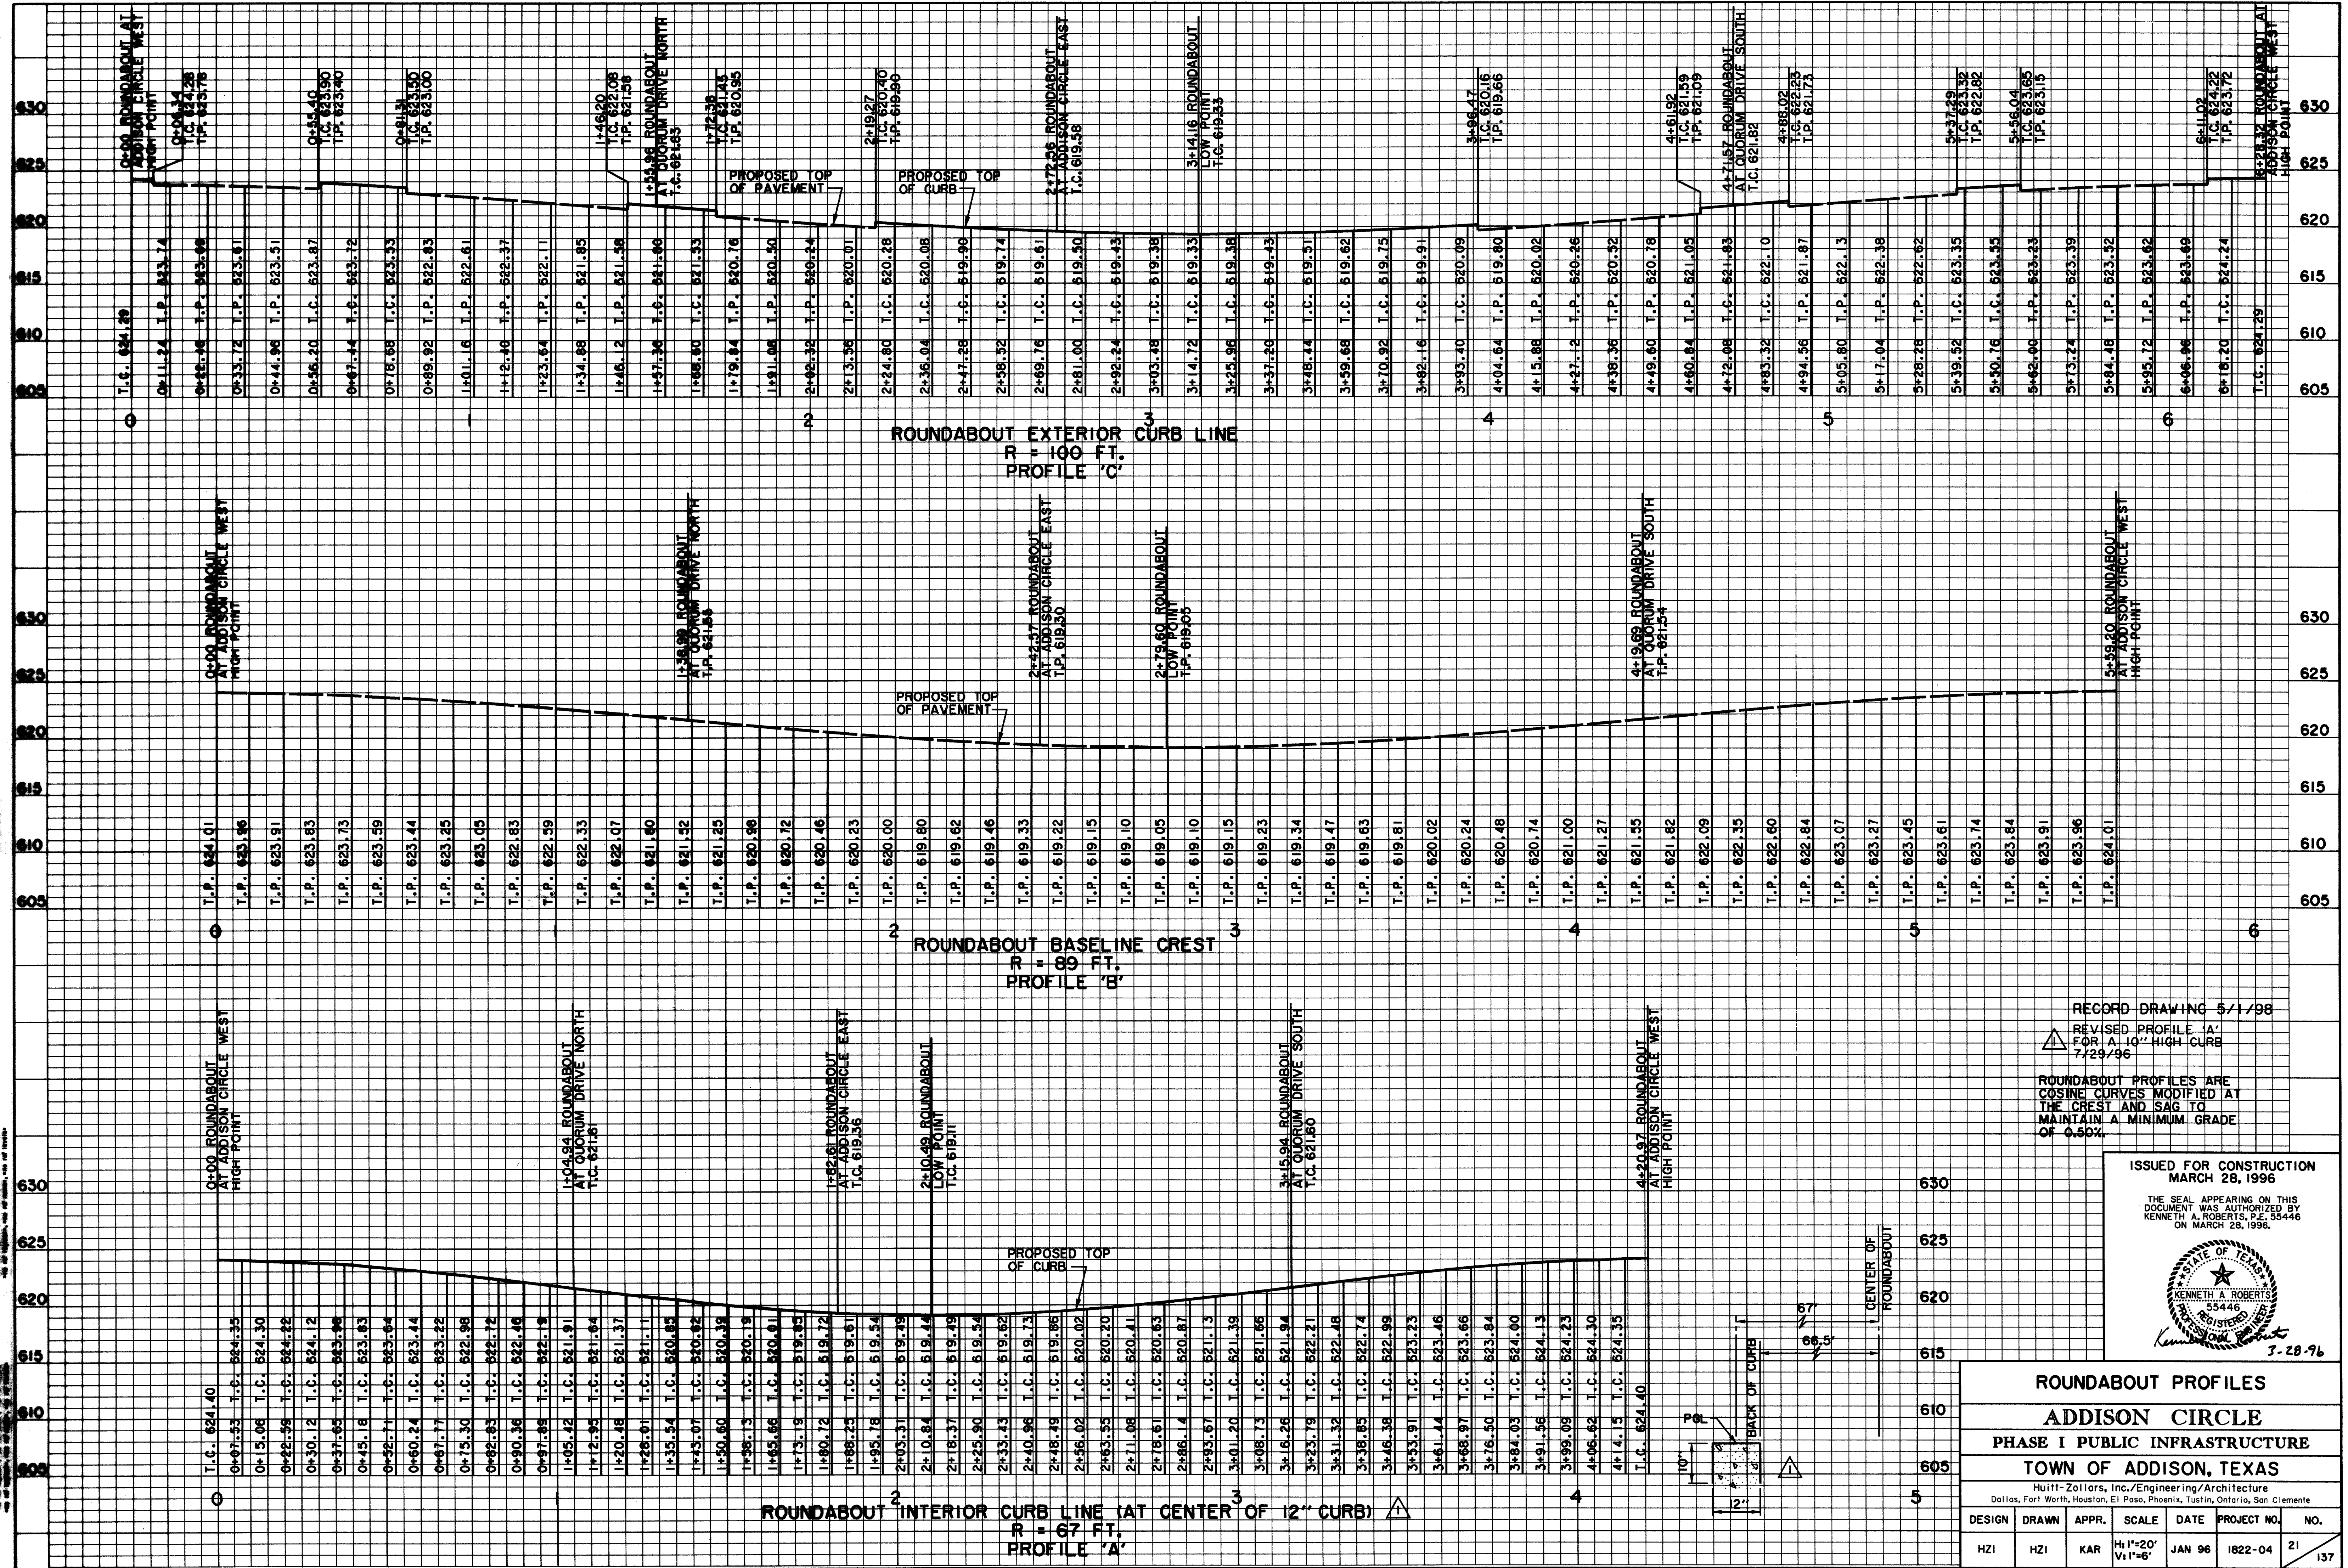

RECORD DRAWING 5/1/98
 REVISED PROFILE 'A'
 FOR A 10" HIGH CURB
 7/29/96
 ROUNDABOUT PROFILES ARE
 COSINE CURVES MODIFIED AT
 THE CREST AND SAG TO
 MAINTAIN A MINIMUM GRADE
 OF 0.50%.

ISSUED FOR CONSTRUCTION
 MARCH 28, 1996

THE SEAL APPEARING ON THIS
 DOCUMENT WAS AUTHORIZED BY
 KENNETH A. ROBERTS, P.E. 55446
 ON MARCH 28, 1996.

3-28-96

ROUNDABOUT PROFILES						
ADDISON CIRCLE						
PHASE I PUBLIC INFRASTRUCTURE						
TOWN OF ADDISON, TEXAS						
Huitt-Zollars, Inc./Engineering/Architecture Dallas, Fort Worth, Houston, El Paso, Phoenix, Tustin, Ontario, San Clemente						
DESIGN	DRAWN	APPR.	SCALE	DATE	PROJECT NO.	NO.
HZI	HZI	KAR	H _v 1"=20' V _h 1"=6'	JAN 96	1822-04	21
						137