
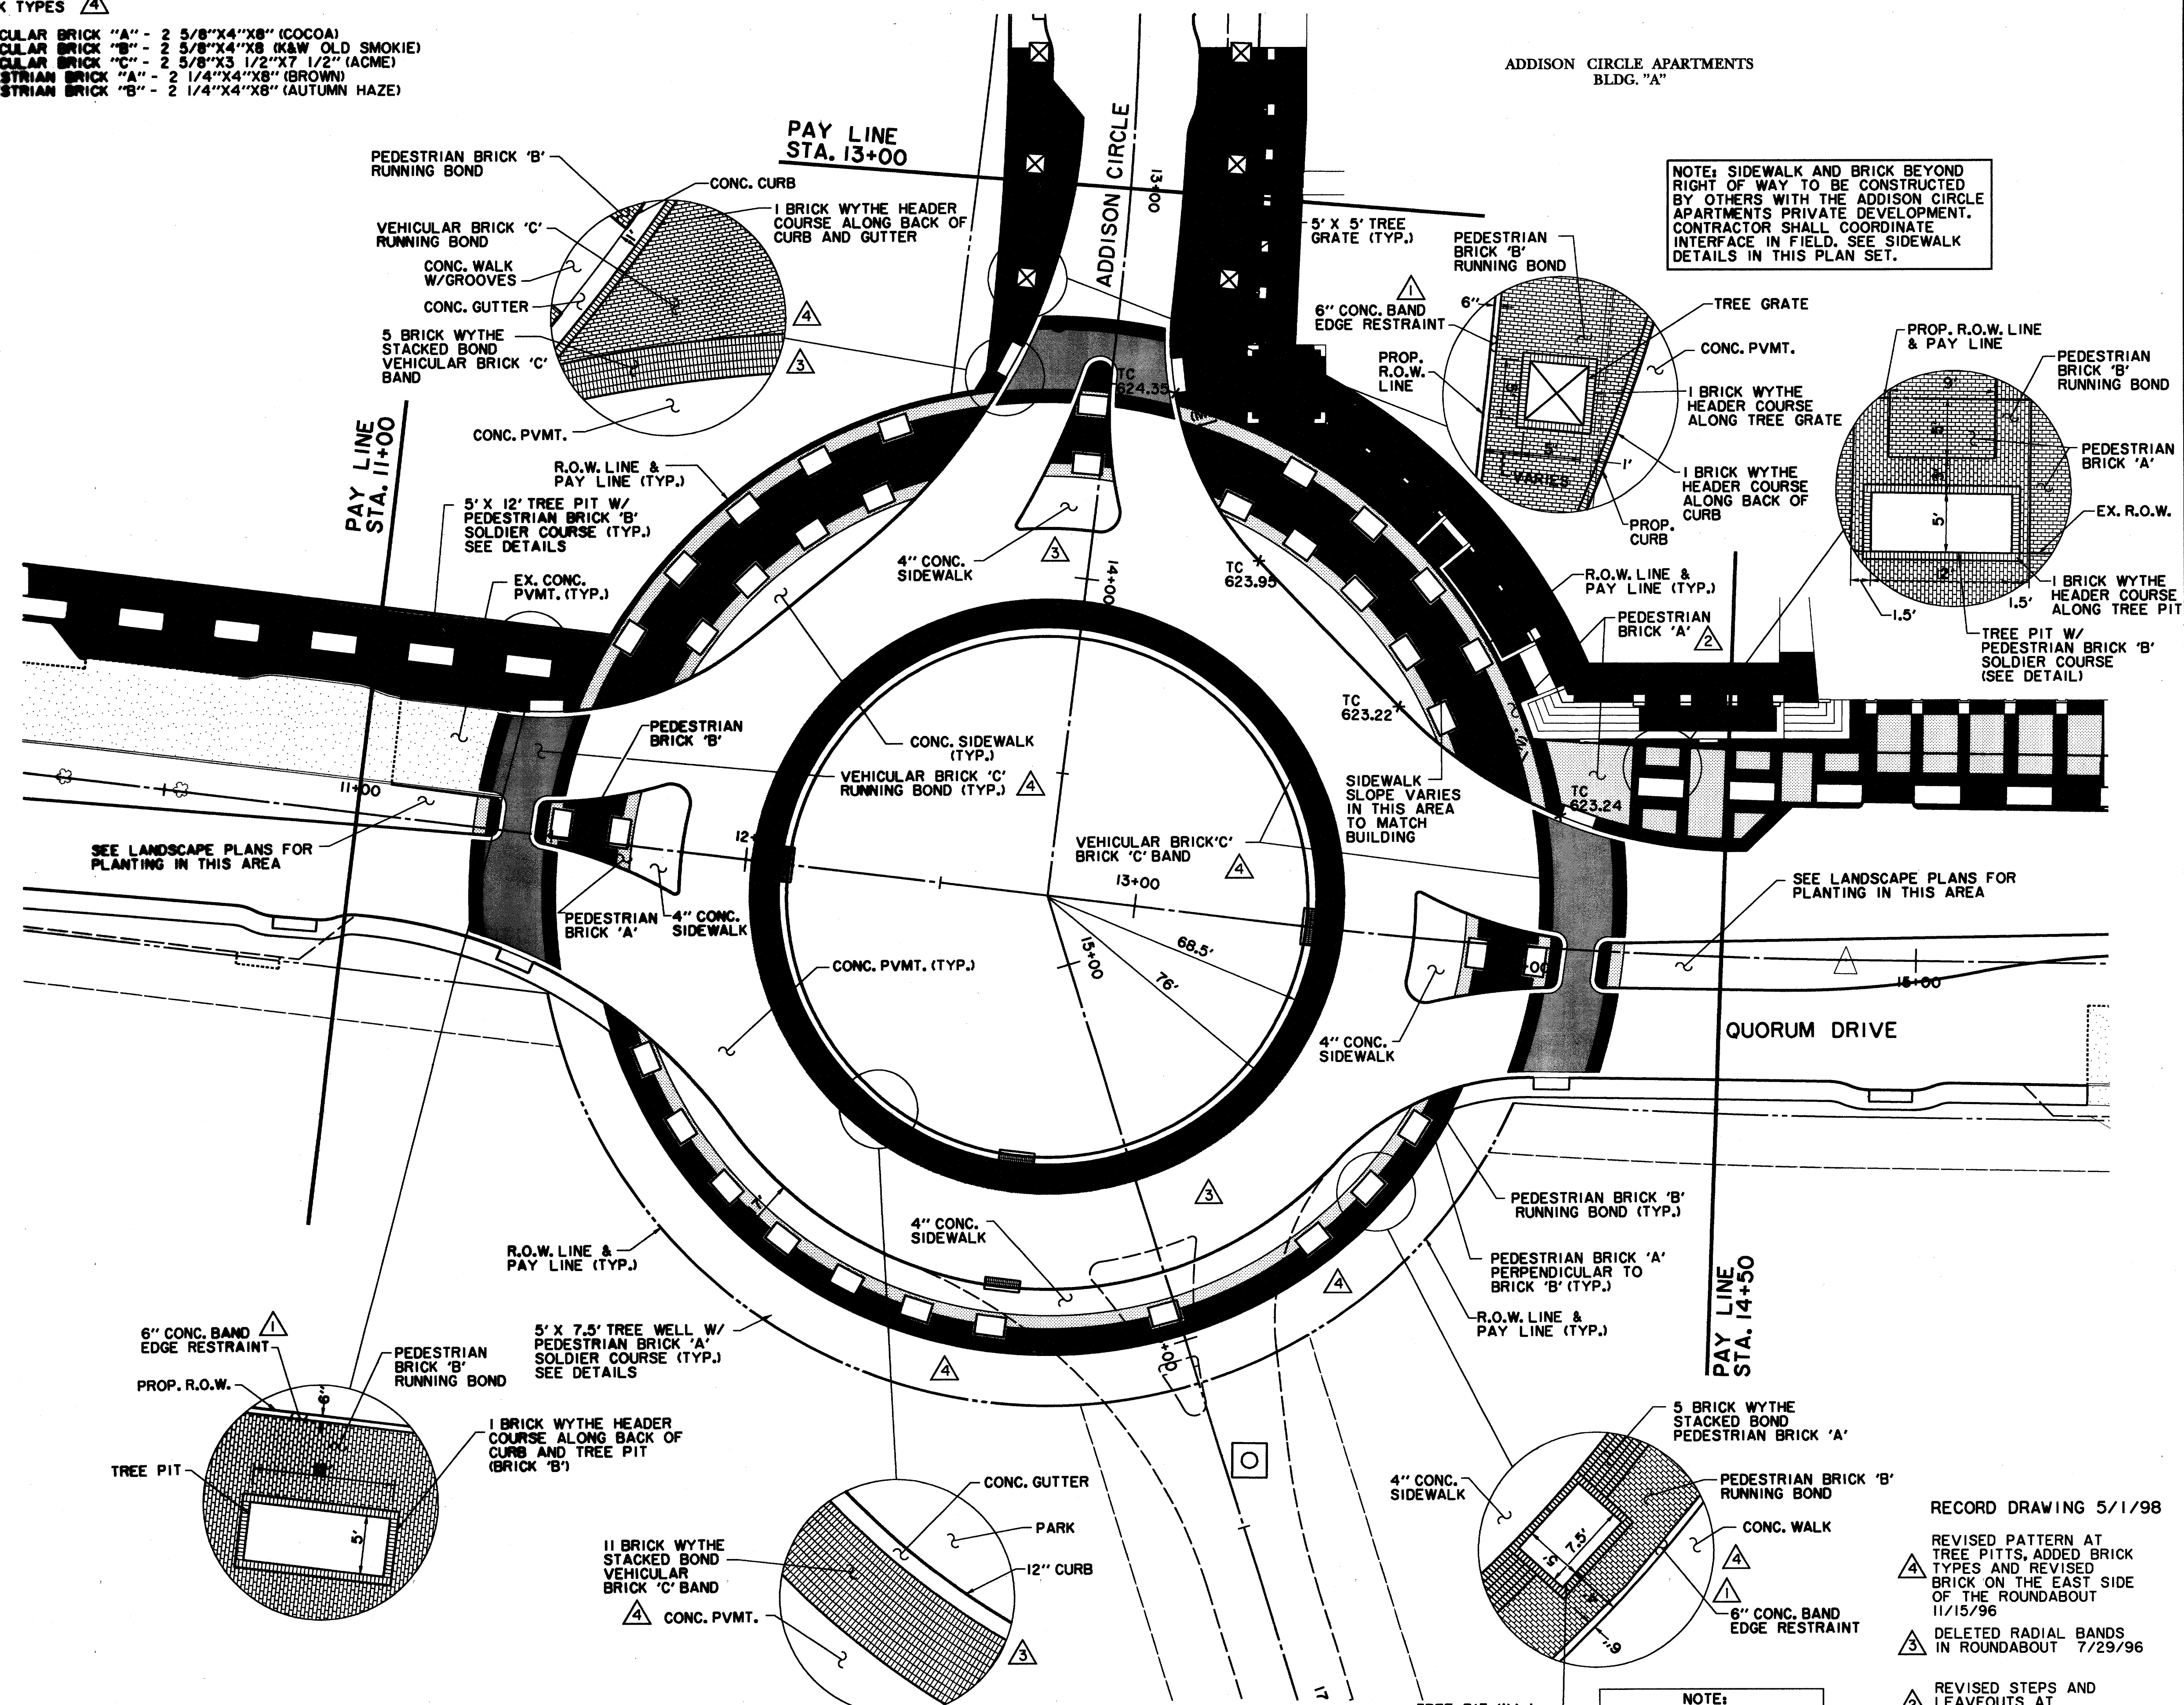


BRICK TYPES

- VEHICULAR BRICK "A" - 2 5/8"x4"x8" (COCOA)
- VEHICULAR BRICK "B" - 2 5/8"x4"x8" (K&W OLD SMOKIE)
- VEHICULAR BRICK "C" - 2 5/8"x3 1/2"x7 1/2" (ACME)
- PEDESTRIAN BRICK "A" - 2 1/4"x4"x8" (BROWN)
- PEDESTRIAN BRICK "B" - 2 1/4"x4"x8" (AUTUMN HAZE)

ADDISON CIRCLE APARTMENTS
BLDG. "A"

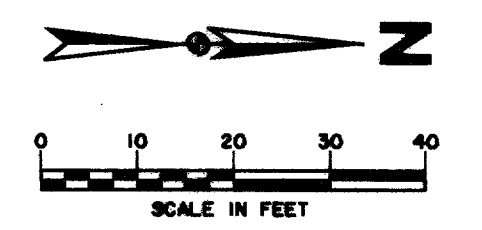

LEGEND

	ELECTRIC ONE		48" RCP		MISC. EX. STORM SEWER
	LIGHT POLE		CHAIN LINK FENCE		WOOD FENCE
	POWER POLE		EXISTING ASPHALT		EXISTING DIRT OR GRAVEL
	GUY WIRE		EX. CONCRETE		TREE/TREE LINE
	TELEPHONE T		EXISTING CURB		PROP. EDGE OF PAVEMENT NO CURB
	TELEPHONE MANHOLE		PROP. CURB		EX. PROPERTY LINE
	TELEPHONE PEDESTAL		PROP. CENTERLINE		PROP. R.O.W.
	TELEPHONE SIGN		PROP. INLET		TOP OF PAVEMENT
	GAS G		T.C.		TOP OF CURB
	GAS METER		C.R.		CURB RETURN
	GAS SIGN		EX. G		EXISTING GUTTER
	RAILROAD SIGN		B-20		BORING LOCATION
	SIGN				
	FOUND IRON ROD				
	TEMP BENCHMARK				
	WASTEWATER MANHOLE				
	CLEANOUT				
	WATER W				
	FIRE HYDRANT				
	METER				
	WATER VALVE				

BENCHMARKS:

BM#1 "I" CUT AT CENTER BACK OF CURB OF INLET, 190 FEET SOUTH FROM THE CENTERLINE INTERSECTION OF ADDISON CIRCLE, WEST SIDE OF QUORUM DRIVE. ELEV. 621.89

BM#2 "I" CUT AT CENTER BACK OF CURB OF INLET, 200 FEET NORTH FROM THE CENTERLINE INTERSECTION OF ADDISON CIRCLE, WEST SIDE OF QUORUM DRIVE. ELEV. 621.68

ISSUED FOR CONSTRUCTION
MARCH 28, 1996

THE SEAL APPEARING ON THIS DOCUMENT WAS AUTHORIZED BY KENNETH A. ROBERTS, P.E. 55446 ON MARCH 28, 1996.

- RECORD DRAWING 5/1/98
- 4 REVISED PATTERN AT TREE PITS, ADDED BRICK TYPES AND REVISED BRICK ON THE EAST SIDE OF THE ROUNDABOUT 11/15/96
 - 3 DELETED RADIAL BANDS IN ROUNDABOUT 7/29/96
 - 2 REVISED STEPS AND LEAVEOUTS AT BLDG. "A" 5/13/96
 - 1 ADDENDUM #2 1/22/96

NOTE: ALL DIMENSIONS ARE RADIAL FOR THIS DETAIL

SURFACE PATTERNING PLAN
QUORUM DRIVE & ADDISON CIRCLE

ADDISON CIRCLE

PHASE I PUBLIC INFRASTRUCTURE

TOWN OF ADDISON, TEXAS

Huitt-Zollars, Inc./Engineering/Architecture
Dallas, Fort Worth, Houston, El Paso, Phoenix, Tustin, Ontario, San Clemente

DESIGN	DRAWN	APPR.	SCALE	DATE	PROJECT NO.	NO.
HZI	HZI	KAR	1"=20'	JAN 96	1822-04	44

137