


NOTE: REFER TO DRAWING 54C FOR LEGEND, SCHEDULE, NOTES AND DETAILS.

MATCH LINE 'A' SEE SHEET 54E

MATCH LINE 'B' SEE SHEET 54E

RECORD DRAWING 5/1/98

THE SEAL APPEARING ON THIS DOCUMENT WAS AUTHORIZED BY GERALD W. INZER, P.E. 56258 ON AUGUST 20, 1997.

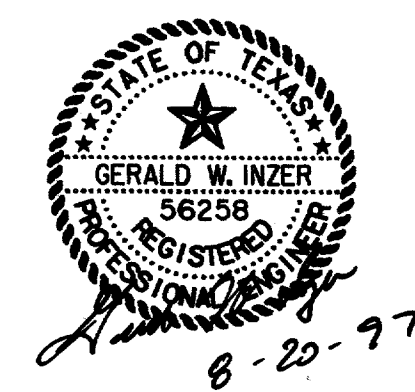

STREET LIGHT CONDUIT PLAN						
ADDISON CIRCLE						
PHASE I PUBLIC INFRASTRUCTURE						
TOWN OF ADDISON, TEXAS						
Huitt-Zollars, Inc./Engineering/Architecture Dallas, Fort Worth, Houston, El Paso, Phoenix, Tustin, Ontario						
DESIGN	DRAWN	APPR.	SCALE	DATE	PROJECT NO.	NO.
HZ1	HZ1	GW1	1"=30'	AUG 97	1822-13	54D