


ISSUED FOR CONSTRUCTION
MARCH 28, 1996

THE SEAL APPEARING ON THIS DOCUMENT WAS AUTHORIZED BY KENNETH A. ROBERTS, P.E. 55446 ON MARCH 28, 1996.

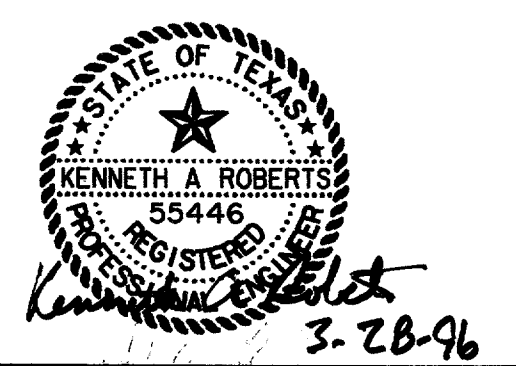

STORM WATER PROFILES
LATERALS A, B, D, & E
ADDISON CIRCLE
PHASE I PUBLIC INFRASTRUCTURE
TOWN OF ADDISON, TEXAS

Huitt-Zollars, Inc./Engineering/Architecture Dallas, Fort Worth, Houston, El Paso, Phoenix, Tustin, Ontario, San Clemente				
DESIGN	DRAWN	APPR.	SCALE	DATE
HZI	HZI	KAR	H ₁ 1"=20' V ₁ 1"=6'	JAN 96
PROJECT NO.			NO.	
1822-04			75	
			137	

RECORD DRAWING 5/1/98
ADDENDUM #2 1/22/96