


LEGEND

ELECTRIC — OHE —	MISC.
○ LIGHT POLE	48" RCP
PP □ POWER POLE	EX. STORM SEWER
— GUY WIRE	CHAIN LINK FENCE
TELEPHONE — T —	WOOD FENCE
MH ● TELEPHONE MANHOLE	EXISTING ASPHALT
□ TELEPHONE PEDESTAL	EXISTING DIRT OR GRAVEL
TS ○ TELEPHONE SIGN	EX. CONCRETE
GM ⊙ GAS METER	TREE/TREE LINE
GS ⊙ GAS SIGN	EXISTING CURB
LAND USE	PROP. CURB
R/R RAILROAD SIGN	PROP. EDGE OF PAVEMENT NO CURB
□ SIGN	EX. PROPERTY LINE
SURVEY	PROP. CENTERLINE
I.R. FOUND IRON ROD	PROP. R.O.W.
TEMP BENCHMARK	PROP. INLET
WASTEWATER — WW —	T.P. TOP OF PAVEMENT
MH ● WASTEWATER MANHOLE	T.C. TOP OF CURB
CO ○ CLEANOUT	C.R. CURB RETURN
WATER — W —	EX. G EXISTING GUTTER
FH ○ FIRE HYDRANT	B-20 BORING LOCATION
WM ⊙ METER	
T WATER VALVE	

RECORD DRAWING 5/1/98

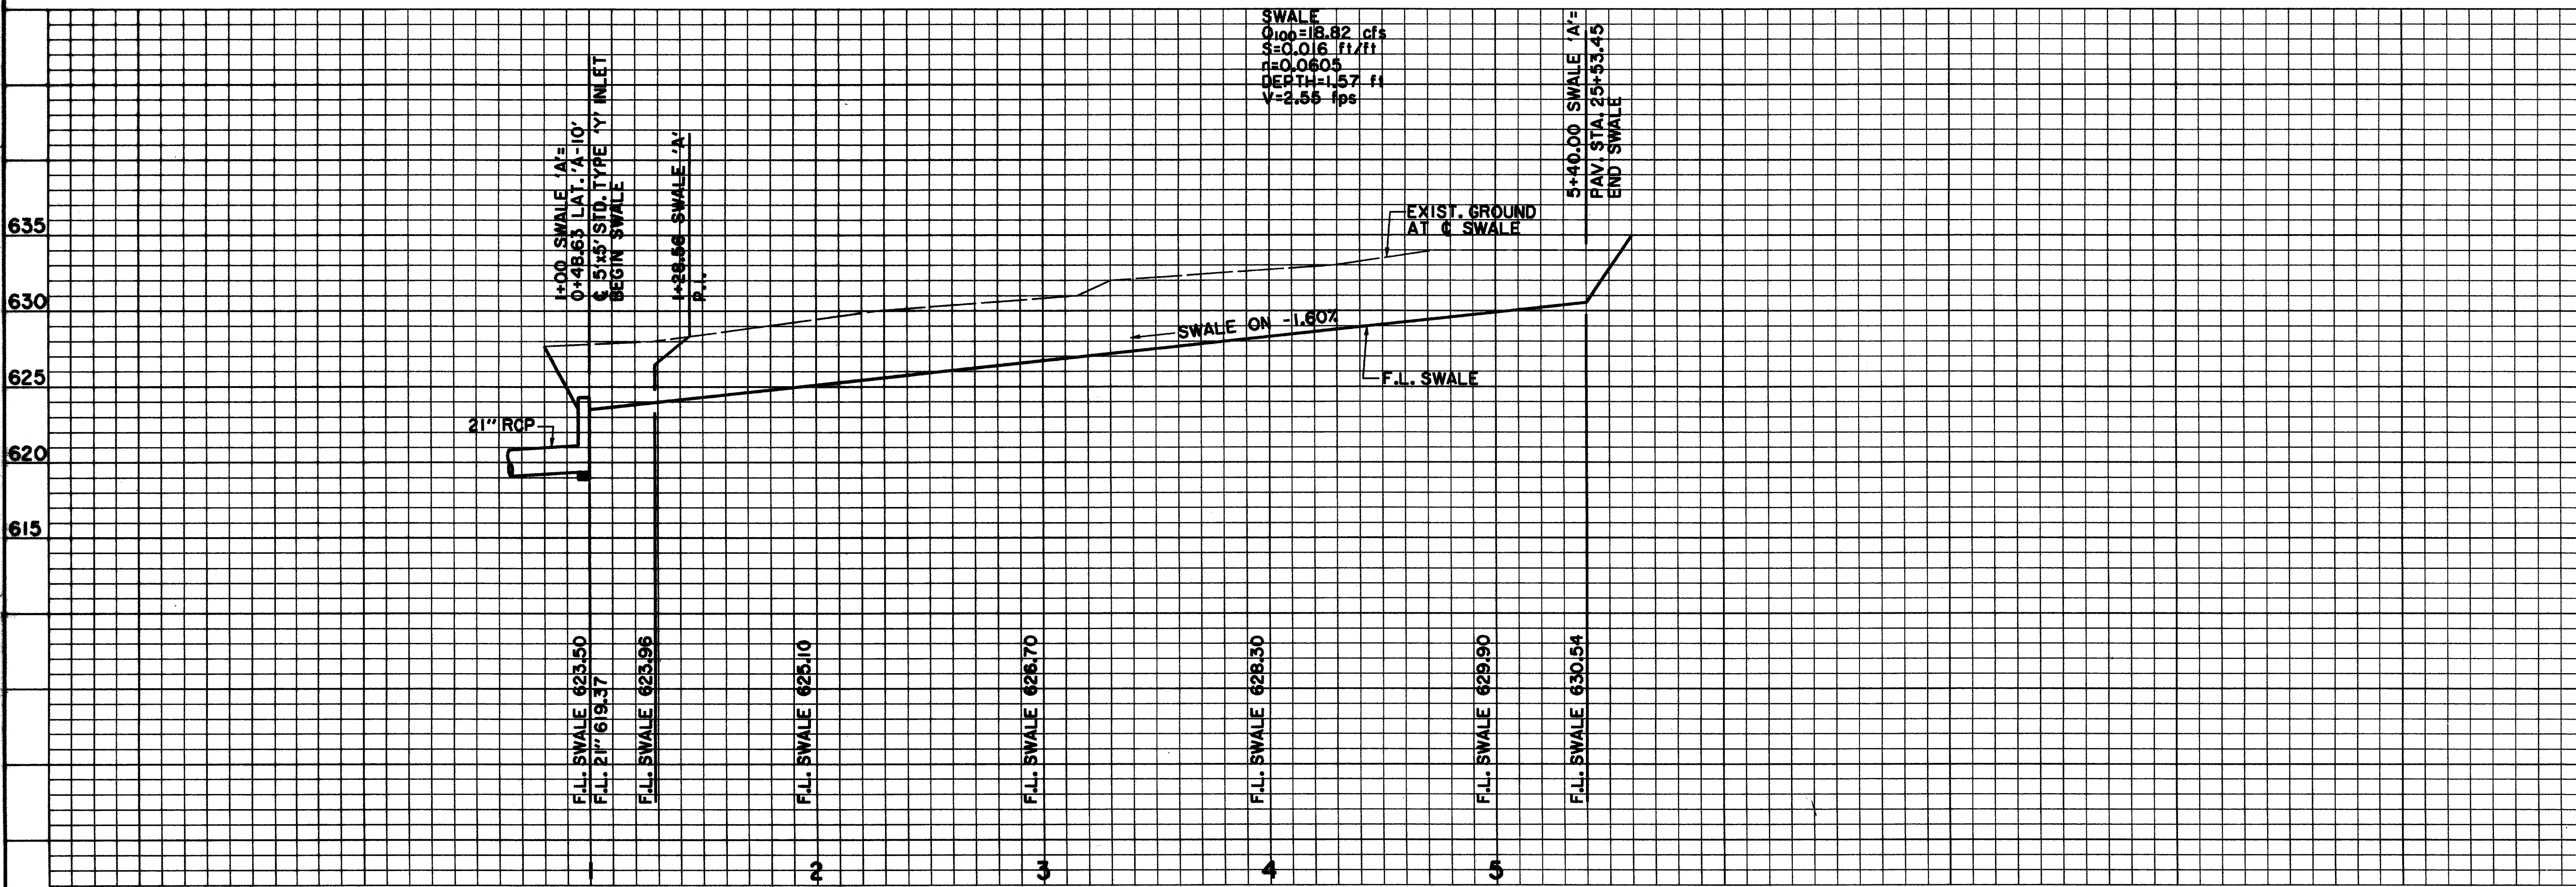

BENCHMARKS:

BM#2
"I" CUT AT CENTER BACK OF CURB OF INLET, 200 FEET NORTH FROM THE CENTERLINE INTERSECTION OF ADDISON DRIVE, WEST SIDE OF QUORUM DRIVE.
ELEV. 621.68

635
BM#3
"I" CUT AT CENTER BACK OF CURB OF INLET, 620 FEET NORTH FROM THE CENTERLINE INTERSECTION OF ADDISON DRIVE, WEST SIDE OF QUORUM DRIVE.
ELEV. 624.50

625
ISSUED FOR CONSTRUCTION
MARCH 28, 1996

620
THE SEAL APPEARING ON THIS DOCUMENT WAS AUTHORIZED BY
KENNETH A. ROBERTS, P.E. 55446
ON MARCH 28, 1996.

615

SWALE 'A' GRADING PLAN & PROFILE
STA. 1+00 TO STA. 7+23.49

ADDISON CIRCLE

PHASE I PUBLIC INFRASTRUCTURE

TOWN OF ADDISON, TEXAS

Huitt-Zollars, Inc./Engineering/Architecture
Dallas, Fort Worth, Houston, El Paso, Phoenix, Tusin, Ontario, San Clemente

DESIGN	DRAWN	APPR.	SCALE	DATE	PROJECT NO.	NO.
HZ1	HZ1	KAR	H: 1"=40' V: 1"=6'	JAN 96	1822-04	77 / 137