

TOWN OF ADDISON  
SPECIAL EVENTS AREA

TOWN OF ADDISON

FUTURE DEVELOPMENT

FUTURE DEVELOPMENT

FUTURE DEVELOPMENT

FUTURE DEVELOPMENT


DALLAS AREA RAPID TRANSIT  
RIGHT-OF-WAY

SEE WASTEWATER PLANS  
FOR CONTINUATION TO  
DALLAS NORTH TOLL WAY

RECORD DRAWING 5/1/98

ISSUED FOR CONSTRUCTION  
MARCH 28, 1996

THE SEAL APPEARING ON THIS  
DOCUMENT WAS AUTHORIZED BY  
KENNETH A. ROBERTS, P.E. 55446  
ON MARCH 28, 1996.

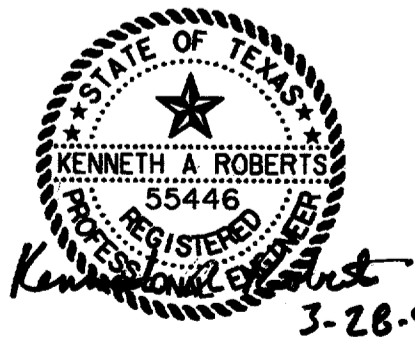

**NOTES:**  
THIS PLAN IS TO ILLUSTRATE THE OVERALL  
LAYOUT OF WATER AND WASTEWATER LINES.  
SEE WATER AND WASTEWATER PLAN/PROFILE  
SHEETS FOR DETAILED DESIGN.

<b>WATER &amp; WASTEWATER SITE MAP</b>							
<b>ADDISON CIRCLE</b>							
<b>PHASE I PUBLIC INFRASTRUCTURE</b>							
<b>TOWN OF ADDISON, TEXAS</b>							
Huitl-Zollars, Inc./Engineering/Architecture Dallas, Fort Worth, Houston, El Paso, Phoenix, Tustin, Ontario, San Clemente							
DESIGN	DRAWN	APPR.	SCALE	DATE	PROJECT NO.	NO.	
HZI	HZI	KAR	1"=50'	JAN 96	1822-04	82	137