


LEGEND

ELECTRIC — OHE —	48" RCP	MISC.
⊕ LIGHT POLE	— EX. STORM SEWER	
PP ⊕ POWER POLE	— CHAIN LINK FENCE	
— GUY WIRE	— WOOD FENCE	
TELEPHONE — T —	— EXISTING ASPHALT	
● TELEPHONE MANHOLE	— EXISTING DIRT OR GRAVEL	
⊕ TELEPHONE PEDESTAL	— EX. CONCRETE	
TS ⊕ TELEPHONE SIGN	— TREE/TREE LINE	
GM ⊕ GAS METER	— EXISTING CURB	
GS ⊕ GAS SIGN	— PROP. CURB	
LAND USE	— PROP. EDGE OF PAVEMENT NO CURB	
RR ⊕ RAILROAD SIGN	— EX. PROPERTY LINE	
⊕ SIGN	— PROP. CENTERLINE	
SURVEY	— PROP. R.O.W.	
I.R. ⊕ FOUND IRON ROD	— PROP. INLET	
⊕ TEMP BENCHMARK	T.P. ⊕ TOP OF PAVEMENT	
WW ⊕ WASTEWATER MANHOLE	T.C. ⊕ TOP OF CURB	
CO ⊕ CLEANOUT	C.R. ⊕ CURB RETURN	
⊕ WATER — W —	EX. G ⊕ EXISTING GUTTER	
FH ⊕ FIRE HYDRANT	⊕ B-20 BORING LOCATION	
WM ⊕ METER		
T ⊕ WATER VALVE		

NOTE:
PUBLIC CONTRACT PAY LINE FOR WATER SERVICE INSTALLATION IS TO THE MAIN LINE SIDE OF METER CANS OR VAULTS. COORDINATE WITH PRIVATE CONTRACTOR TO SET METER CANS AND VAULTS PER TOWN OF ADDISON GENERAL REQUIREMENTS PRIOR TO CONSTRUCTION OF SIDEWALKS.

RECORD DRAWING 5/1/98

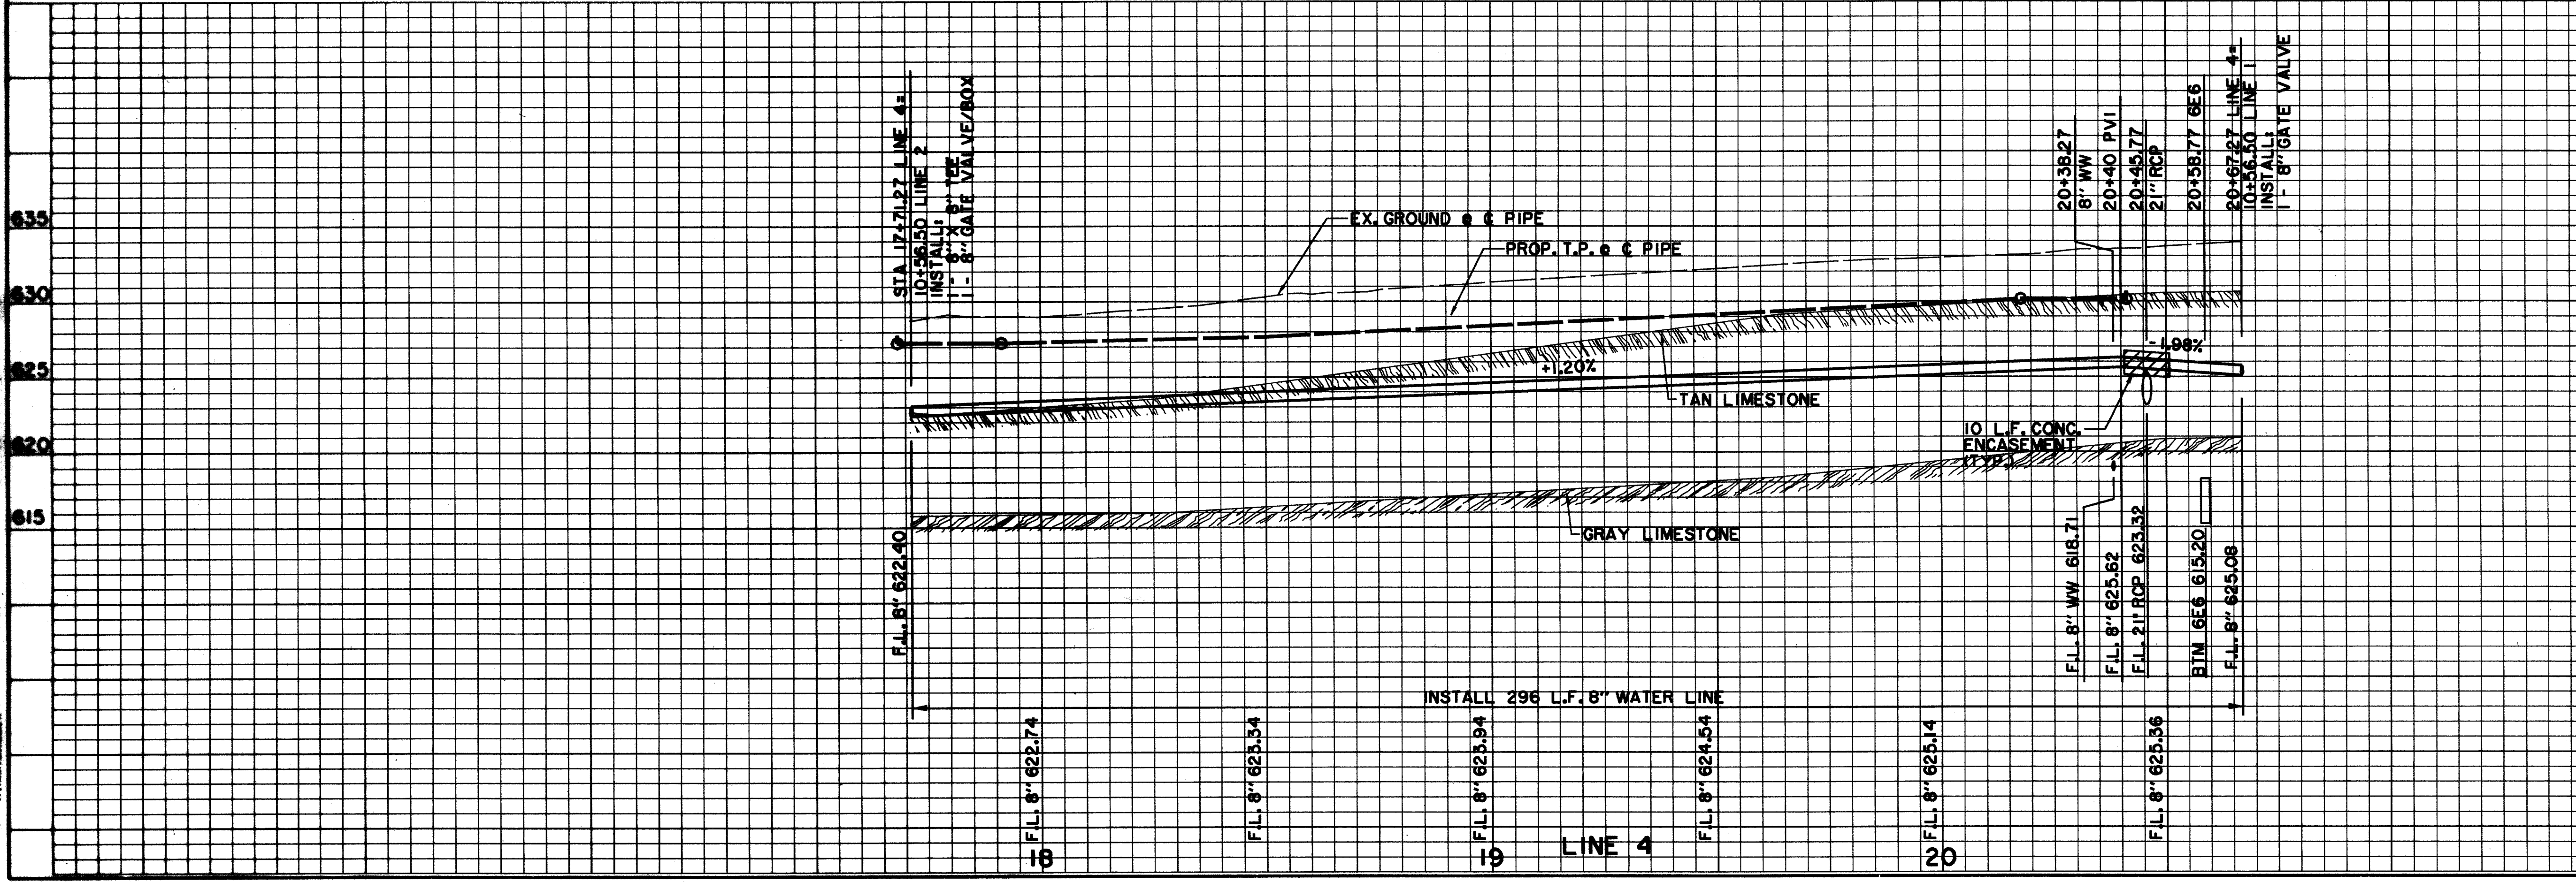

BENCHMARKS:

BM#2
"I" CUT AT CENTER BACK OF CURB OF INLET, 200 FEET NORTH FROM THE CENTERLINE INTERSECTION OF ADDISON DRIVE, WEST SIDE OF QUORUM DRIVE.
ELEV. 621.68

BM#3
"I" CUT AT CENTER BACK OF CURB OF INLET, 620 FEET NORTH FROM THE CENTERLINE INTERSECTION OF ADDISON DRIVE, WEST SIDE OF QUORUM DRIVE.
ELEV. 624.50

ISSUED FOR CONSTRUCTION
MARCH 28, 1996

THE SEAL APPEARING ON THIS DOCUMENT WAS AUTHORIZED BY
KENNETH A. ROBERTS, P.E. 55446
ON MARCH 28, 1996.

WATER PLAN & PROFILE			
LINE 4			
ADDISON CIRCLE			
PHASE I PUBLIC INFRASTRUCTURE			
TOWN OF ADDISON, TEXAS			
Huitt-Zollars, Inc./Engineering/Architecture Dallas, Fort Worth, Houston, El Paso, Phoenix, Tustin, Ontario, San Clemente			
DESIGN	DRAWN	APPR.	SCALE
HZI	HZI	KAR	H ₁ 1"=20' V ₁ 1"=6'
DATE	PROJECT NO.	NO.	
JAN 96	1822-04	87	137