


LEGEND

ELECTRIC — O—E	48" RCP	MISC. EX. STORM SEWER
LIGHT POLE	CHAIN LINK FENCE	WOOD FENCE
POWER POLE	EXISTING ASPHALT	EXISTING DIRT OR GRAVEL
GUY WIRE	EX. CONCRETE	TREE/TREE LINE
TELEPHONE — T—	PROP. CURB	PROP. EDGE OF PAVEMENT NO CURB
TELEPHONE MANHOLE	EX. PROPERTY LINE	PROP. CENTERLINE
TELEPHONE PEDESTAL	PROP. R.O.W.	PROP. INLET
TELEPHONE SIGN	T.P.	TOP OF PAVEMENT
GAS — G—	T.C.	TOP OF CURB
GAS METER	C.R.	CURB RETURN
GAS SIGN	EX. G.	EXISTING GUTTER
LAND USE	BORING LOCATION	B-20
RAILROAD SIGN	SURVEY	
SIGN	FOUND IRON ROD	
SURVEY	TEMP BENCHMARK	
WASTEWATER — WW—	WASTEWATER MANHOLE	
CLEANOUT	WATER — W—	
FIRE HYDRANT	METER	
WATER VALVE		

FUTURE DEVELOPMENT

RECORD DRAWING 5/1/98
 REVISD SIZE AND ALIGNMENT OF LATERAL TO BLDG. 'A' 5/30/96

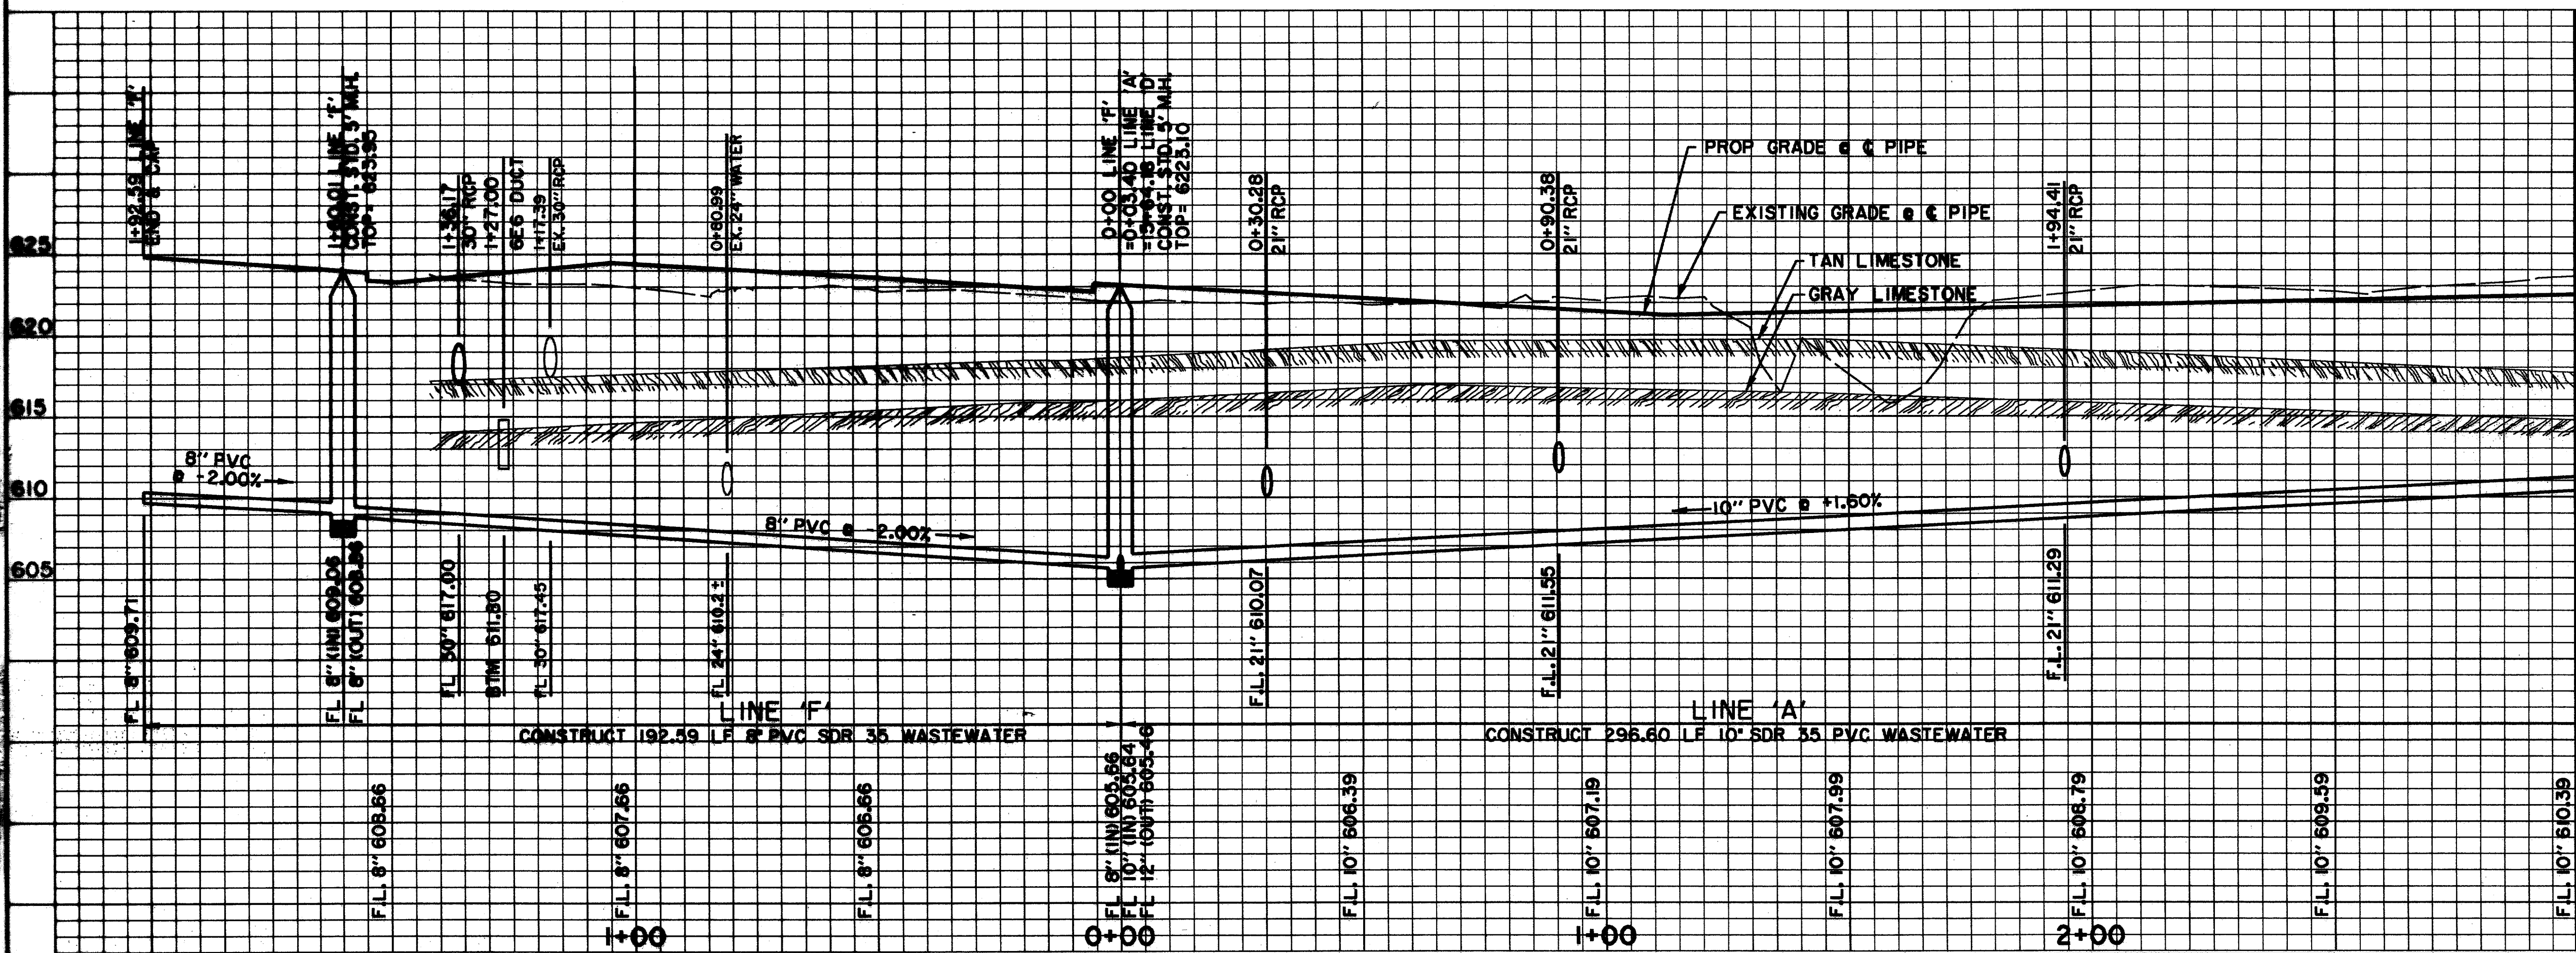

BENCHMARKS:

BM#2
 "C" CUT AT CENTER BACK OF CURB OF INLET, 200 FEET NORTH FROM THE CENTERLINE INTERSECTION OF ADDISON CIRCLE, WEST SIDE OF QUORUM DRIVE.
 ELEV. 621.68

625

BM#3
 "C" CUT AT CENTER BACK OF CURB OF INLET, 620 FEET NORTH FROM THE CENTERLINE INTERSECTION OF ADDISON CIRCLE, WEST SIDE OF QUORUM DRIVE.
 ELEV. 624.50

620

615

ISSUED FOR CONSTRUCTION MARCH 28, 1996

THE SEAL APPEARING ON THIS DOCUMENT WAS AUTHORIZED BY KENNETH A. ROBERTS, P.E. 55446 ON MARCH 28, 1996.

3-28-96

WASTEWATER PLAN & PROFILE						
LINE 'A' STA. 0+00 TO STA. 3+00						
LINE 'F' STA. 0+00 TO STA. 1+79.04						
ADDISON CIRCLE						
PHASE I PUBLIC INFRASTRUCTURE						
TOWN OF ADDISON, TEXAS						
Huitl-Zollars, Inc./Engineering/Architecture Dallas, Fort Worth, Houston, El Paso, Phoenix, Tustin, Ontario, San Clemente						
DESIGN	DRAWN	APPR.	SCALE	DATE	PROJECT NO.	NO.
HZI	HZI	KAR	H _v 1"=20' V _v 1"=6'	JAN 96	1822-04	92
						137