



H:\PROJECTS\2012\1018221\DWG\ACM6021.DWG
 DATE PLOTTED: 10/27/12 10:58 AM
 PLOTTER: HP DesignJet T1100e
 PLOT SCALE: 1"=20'

ALL INFORMATION CONTAINED HEREIN IS THE PROPERTY OF HUIF-ZOLLERS, INC. AND IS TO BE USED ONLY FOR THE PROJECT AND SITE SPECIFICALLY IDENTIFIED HEREIN. ANY REUSE OR MODIFICATION OF THIS INFORMATION WITHOUT THE WRITTEN CONSENT OF HUIF-ZOLLERS, INC. IS STRICTLY PROHIBITED.

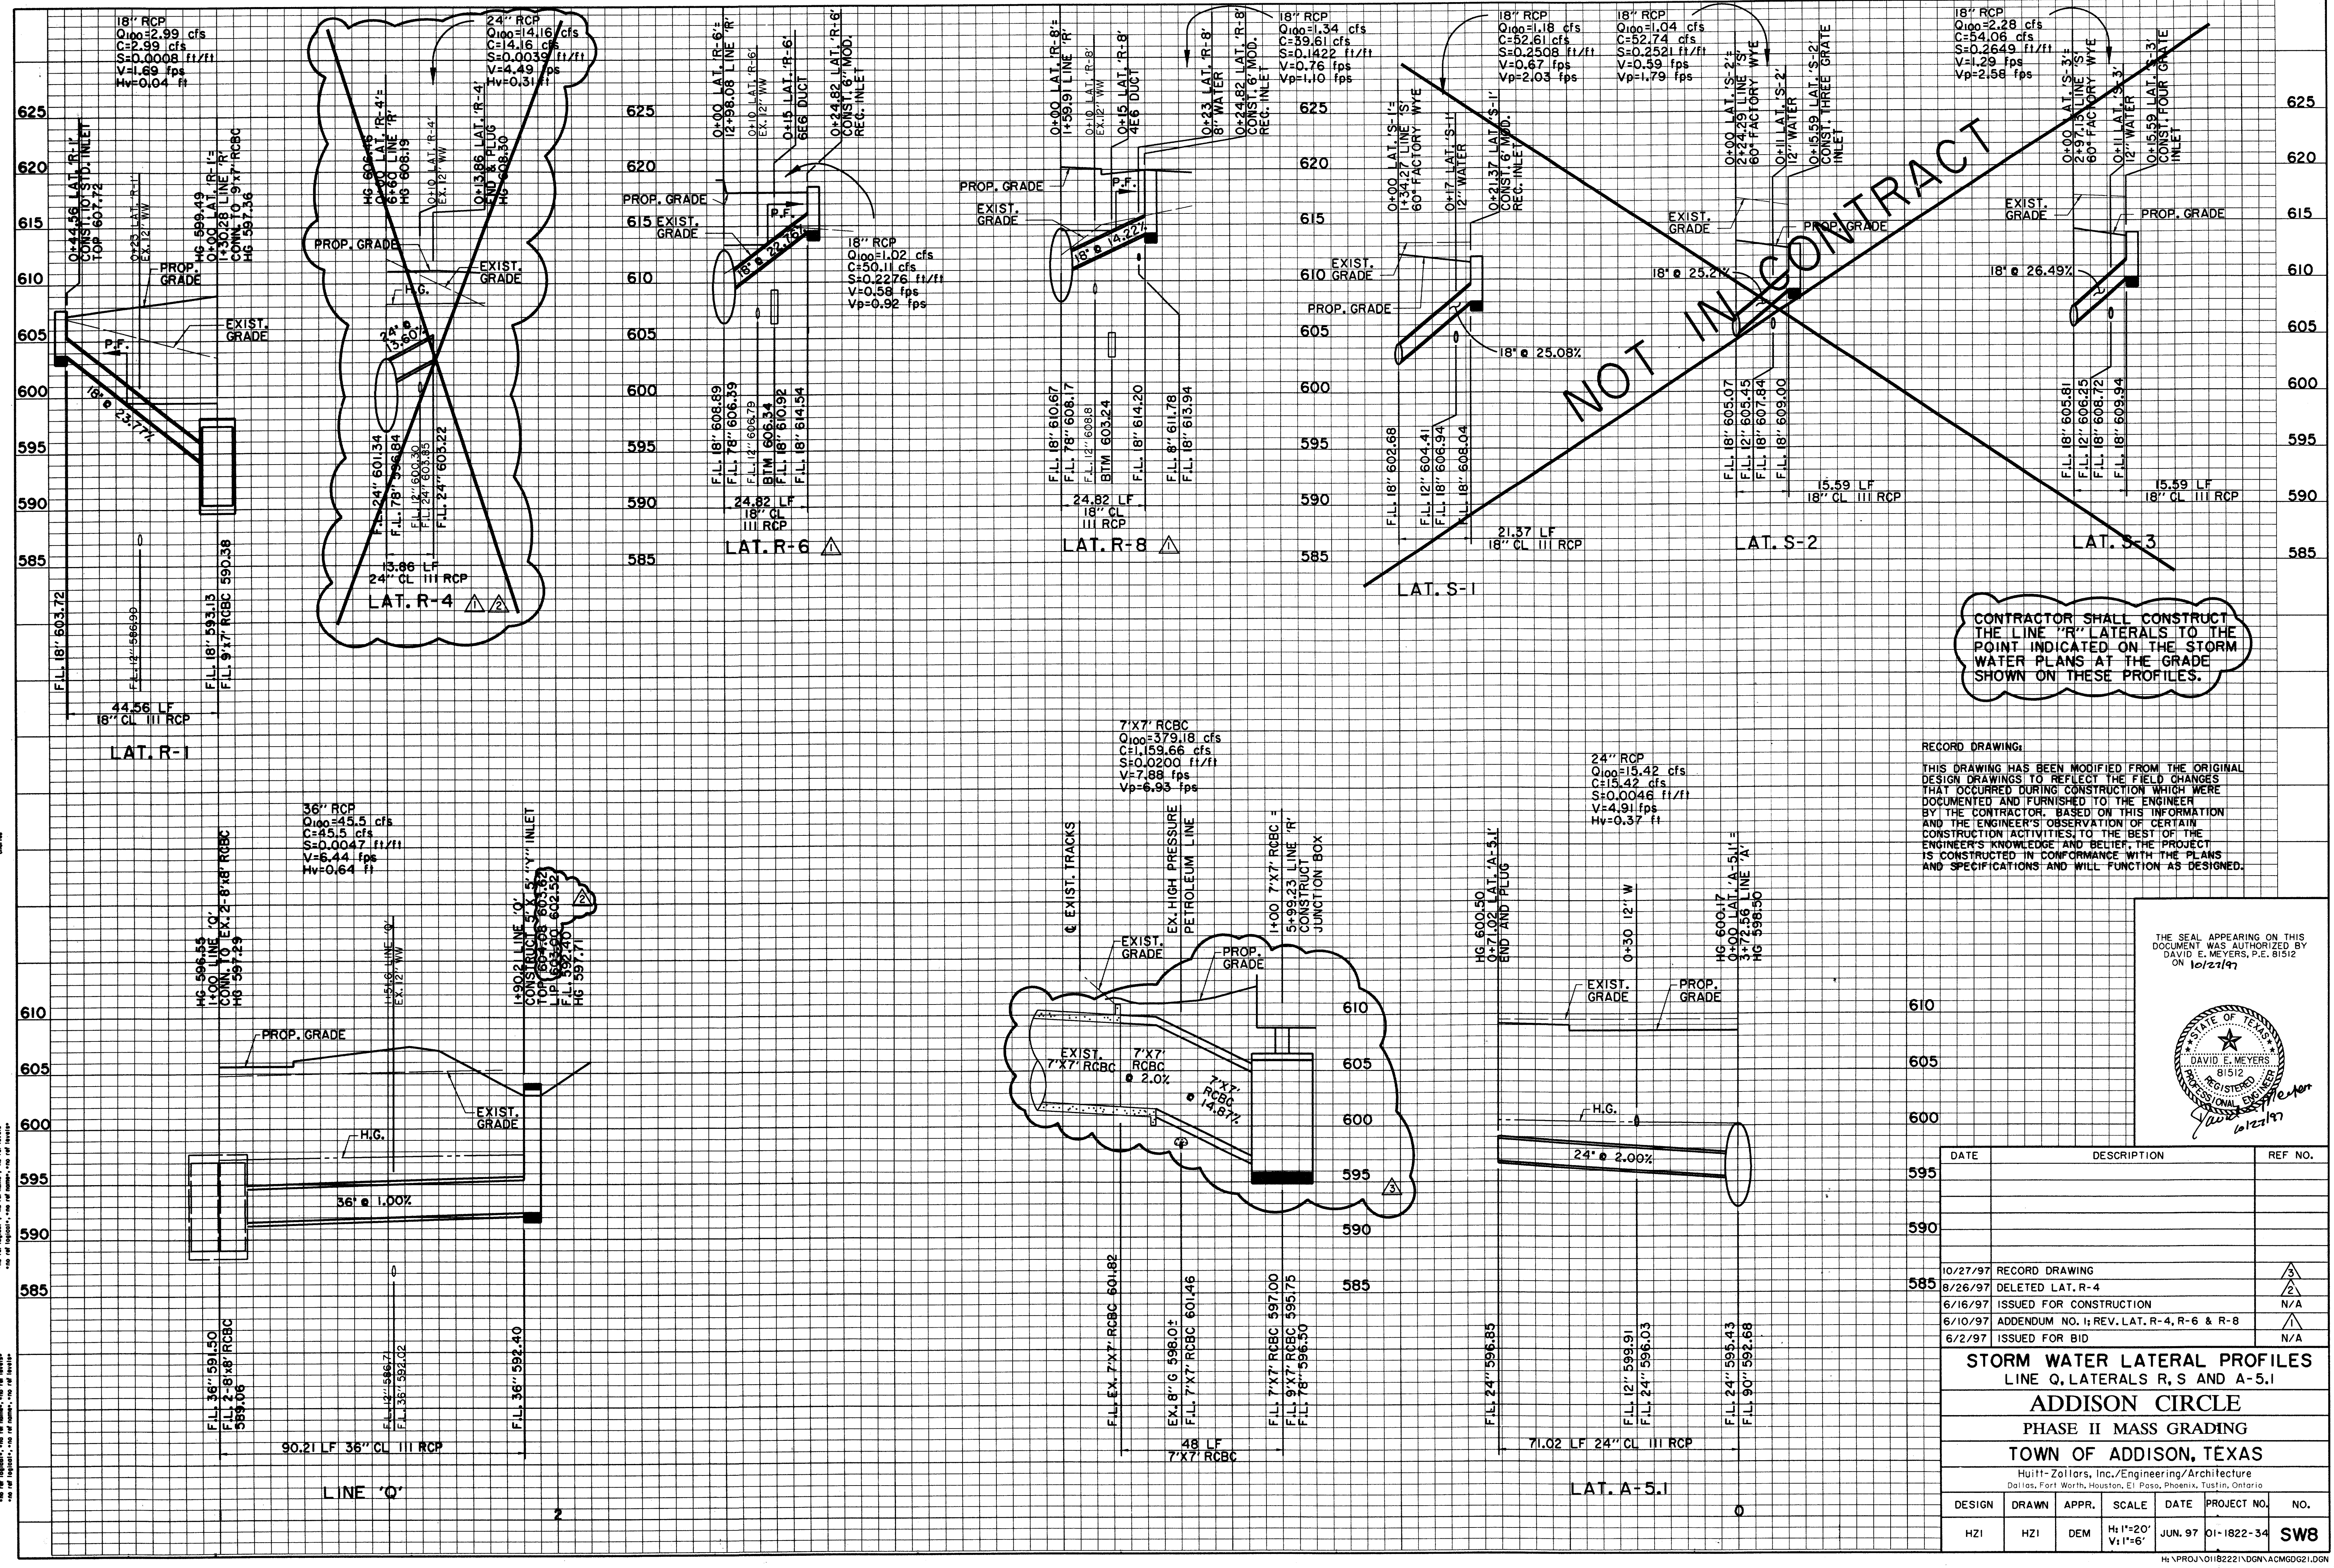

RECORD DRAWING:
 THIS DRAWING HAS BEEN MODIFIED FROM THE ORIGINAL DESIGN DRAWINGS TO REFLECT THE FIELD CHANGES THAT OCCURRED DURING CONSTRUCTION WHICH WERE DOCUMENTED AND FURNISHED TO THE ENGINEER BY THE CONTRACTOR. BASED ON THIS INFORMATION AND THE ENGINEER'S OBSERVATION OF CERTAIN CONSTRUCTION ACTIVITIES TO THE BEST OF THE ENGINEER'S KNOWLEDGE AND BELIEF, THE PROJECT IS CONSTRUCTED IN CONFORMANCE WITH THE PLANS AND SPECIFICATIONS AND WILL FUNCTION AS DESIGNED.

THE SEAL APPEARING ON THIS DOCUMENT WAS AUTHORIZED BY
 DAVID E. MEYERS, P.E. 81512
 ON 10/27/12

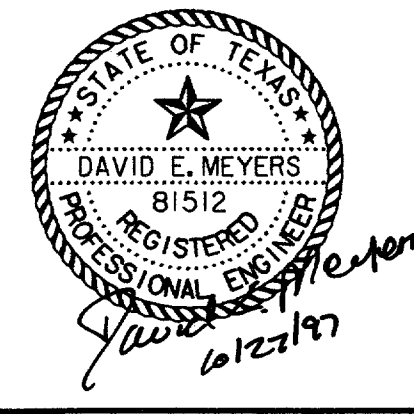

DATE	DESCRIPTION	REF NO.
10/27/12	RECORD DRAWING	3
8/26/12	DELETED LAT. R-4	2
6/16/12	ISSUED FOR CONSTRUCTION	N/A
6/10/12	ADDENDUM NO. 1; REV. LAT. R-4, R-6 & R-8	1
6/2/12	ISSUED FOR BID	N/A

STORM WATER LATERAL PROFILES
 LINE O, LATERALS R, S AND A-5.1
ADDISON CIRCLE
 PHASE II MASS GRADING
 TOWN OF ADDISON, TEXAS

DESIGN	DRAWN	APPR.	SCALE	DATE	PROJECT NO.	NO.
HZ1	HZ1	DEM	H: 1"=20' V: 1"=6'	JUN. 97	01-1822-34	SW8