



TYPICAL ROOF

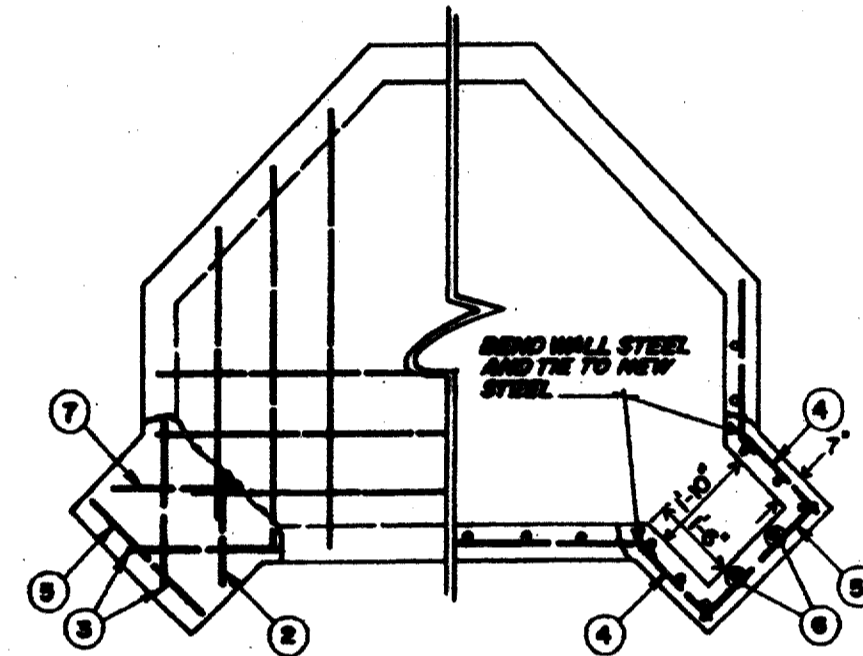

TYPICAL FLOOR / WALL

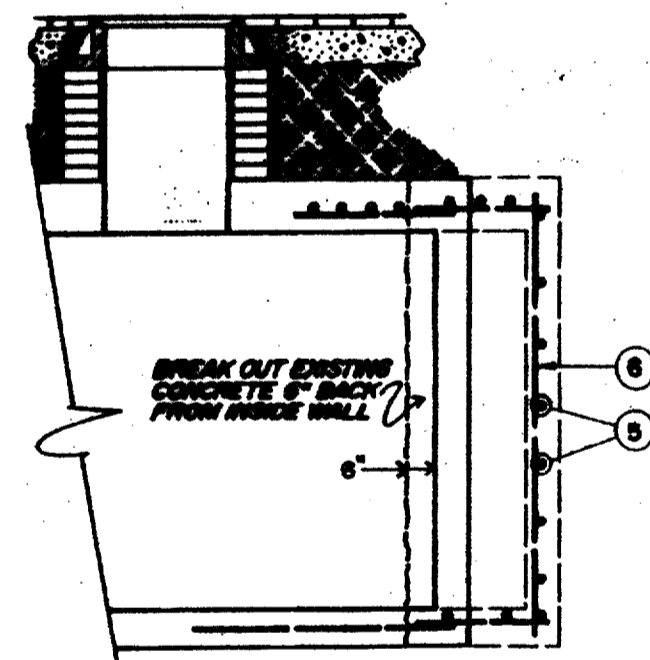


FLOOR / ROOF / WALL VIEW


ITEM	LENGTH			QUANTITY			
	FT.	IN.		FLOOR	WALL	ROOF	WALL
1	2	9				4	4
2	2	3	1			8	7
3	3	0	2				2
4	2	0	2	10	2	22	
5	2	11	1	6	1	8	
6	7	3					8
7	2	5	1				1

DEEP PANELS ON NEW OR EXISTING TYPE  
"C" AND "B" - See Job Sketch


DETAIL #21

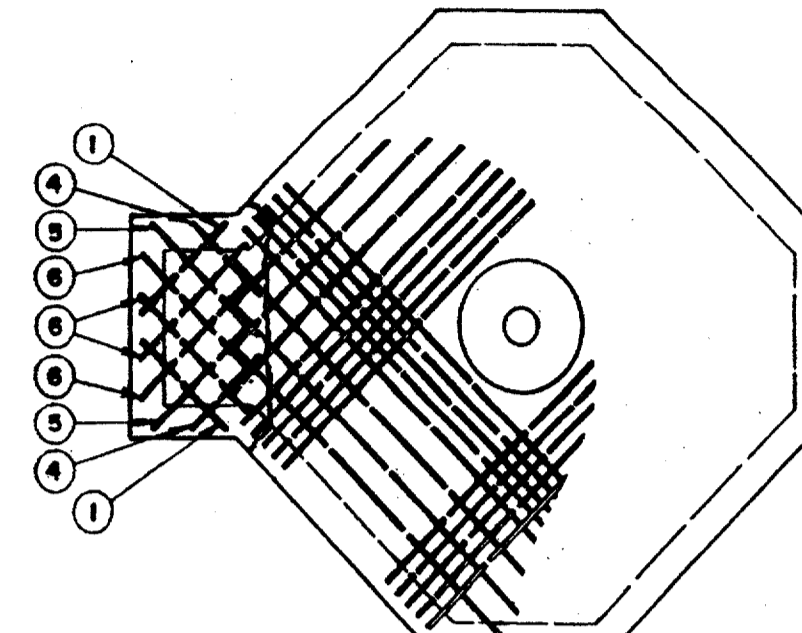

TYPICAL ROOF

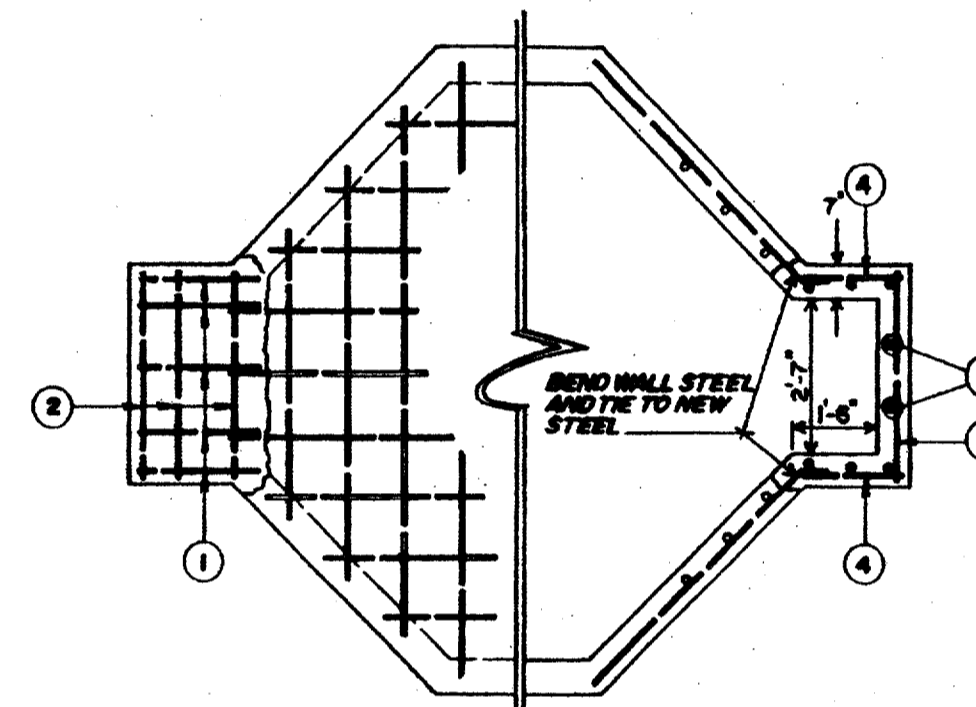

TYPICAL FLOOR / WALL

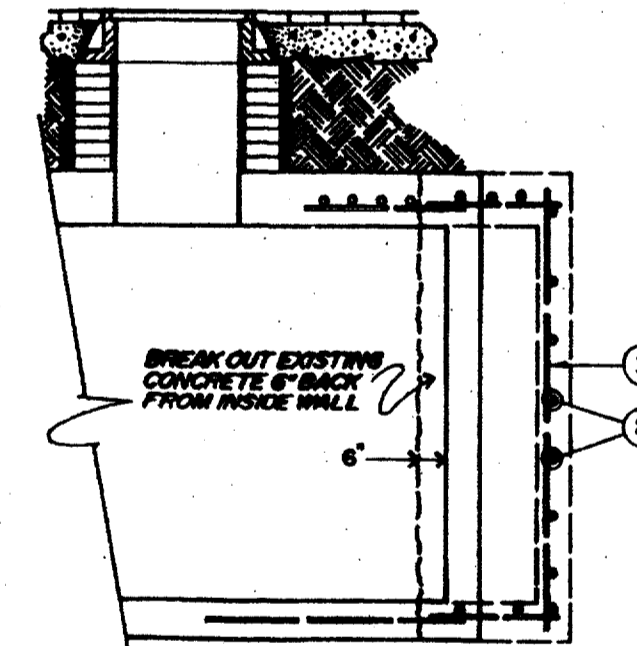

FLOOR / ROOF / WALL VIEW

ITEM	LENGTH			QUANTITY			
	FT.	IN.		FLOOR	WALL	ROOF	WALL
1	2	3	5			2	7
2	3	6	3	7			10
3	7	3			8		8
4	1	9		14	2	16	
5	2	6				2	2
6	2	9				4	4

DEEP PANELS ON NEW OR EXISTING TYPE  
"B", "C" AND "D" - See Job Sketch

RECORD  
DRAWING

10/3/97 ISSUED FOR CONSTRUCTION

E20

TU ELECTRIC		DATE 05-12-92		CH. JRC	APP. JES	ENG. JRC	APP. PRN	W.A.	NO.	DATE	REVISION DESCRIPTION	DRAWN	CH.	APP.	APP.
SCALE (H=NO SCALE) (V=NO SCALE)		LIST OF DRAWINGS		W.A.	ESTIMATE	DWG TYPE	UNIT ID								
NETWORK UNDERGROUND APPURTENANCE SHEETS MISCELLANEOUS DETAILS															
E-NUA-1 SHEET NO. 9															