


NOTE: CONTRACTOR SHALL CONTACT ALL UTILITIES AND PRIVATE APARTMENT DEVELOPER TO INSURE THAT ALL NECESSARY SLEEVES ARE INSTALLED PRIOR TO PAVING.

NOTE: MINIMUM COVER OF CONDUIT SLEEVES SHALL BE 3' FROM TOP OF CURB.

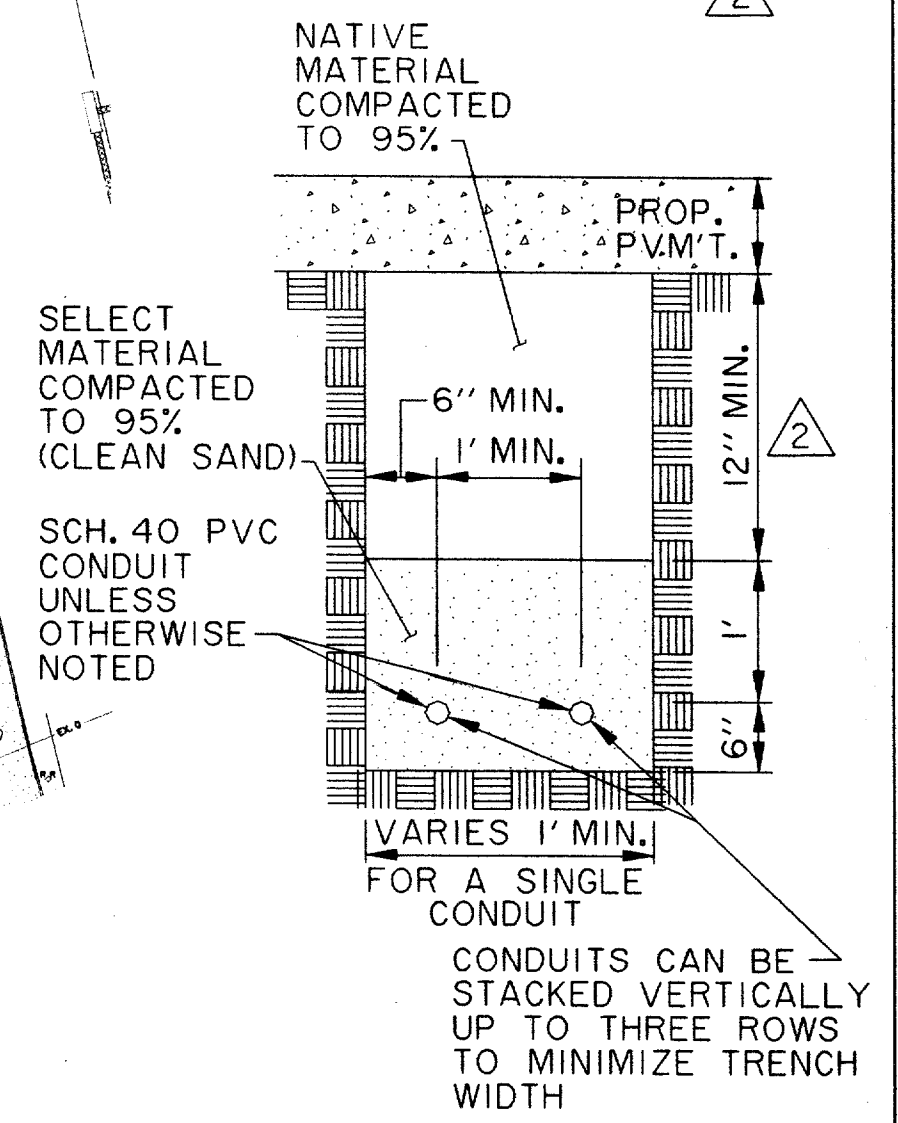

TYPICAL CONDUIT/SLEEVE EMBEDMENT
N.T.S.

THE SEAL APPEARING ON THIS DOCUMENT WAS AUTHORIZED BY DAVID E. MEYERS, P.E. 81512



RECORD DRAWING

STREET	STATION	SLEEVE SIZE AND USE
SPECTRUM DR.	9+93.43	1-4" IRRIGATION
SPECTRUM DR.	10+30.00	2-4" ELECTRICAL
SPECTRUM DR.	11+19.00	2-2" FIRE ALARM, 1-3" SPARE
SPECTRUM DR.	11+42.00	1-4" IRRIGATION
SPECTRUM DR.	11+66.00	2-2" TV, 2-4" TELEPHONE
SPECTRUM DR.	12+10.00	4-4" & 2-2" TELEPHONE
SPECTRUM DR.	13+58.00	4-4" & 2-2" TELEPHONE, 1-6" GAS, 2-4" ELECTRICAL
SPECTRUM DR.	15+05.00	2-4" ELECTRICAL, 1-4" IRRIGATION
SPECTRUM DR.	17+15.00	2-4" ELECTRICAL
SPECTRUM DR.	17+79.00	1-4" IRRIGATION
SPECTRUM DR.	17+89.00	4-4" & 2-2" TELEPHONE, 1-4" IRR.
MORRIS AVE.	15+45.00	2-4" ELECTRICAL
MORRIS AVE.	15+63.00	4-4" & 2-2" TELEPHONE
MORRIS AVE.	16+08.74	1-6" GAS, 2-4" TELEPHONE
MORRIS AVE.	16+20.00	1-4" TELEPHONE FOR TOWNHOMES
MORRIS AVE.	17+70.00	1-4" IRRIGATION
MORRIS AVE.	17+95.00	1-4" IRRIGATION
MORRIS AVE.	18+30.00	1-4" GAS
MORRIS AVE.	18+55.00	1-4" IRRIGATION
MORRIS AVE.	20+30.00	2-4" ELECTRICAL
MORRIS AVE.	20+47.50	4-4", 2-2" TELEPHONE
MILDRED PLACE	14+80.00	2-4" ELECTRICAL
MILDRED PLACE	15+52.00	1-4" IRRIGATION
MILDRED PLACE	15+59.00	2-3" TV, 2-4" TELEPHONE
MILDRED PLACE	15+85.00	1-2" FIRE ALARM, 1-3" SPARE, 1-2" SECURITY
MILDRED PLACE	17+15.00	1-4" IRRIGATION
MILDRED PLACE	17+25.00	2-4" ELECTRICAL
LEWIS PLACE	9+50.00	2-4" ELECTRICAL
LEWIS PLACE	10+35.00	1-2" FIRE ALARM, 1-3" SPARE, 1-2" SECURITY
LEWIS PLACE	11+05.00	1-4" IRRIGATION
LEWIS PLACE	11+50.00	2-3" TV, 2-4" TELEPHONE
LEWIS PLACE	11+95.00	2-6" GAS
LEWIS PLACE	12+85.00	2-4" ELECTRICAL, 1-6" GAS, 4-4" & 2-2" TELEPHONE
LEWIS PLACE	13+64.00	2-4" TELEPHONE
McENTIRE PLACE	15+10.00	1-4" IRRIGATION
McENTIRE PLACE	15+65.00	1-4" IRRIGATION
McENTIRE PLACE	16+70.20	1-4" IRRIGATION (BY BORE)
McENTIRE PLACE	18+48.29	1-4" IRRIGATION (BY BORE)
McENTIRE PLACE	18+50.00	1-4" IRRIGATION
McENTIRE PLACE	19+60.12	1-4" IRRIGATION (BY BORE)
McENTIRE PLACE	19+65.00	1-4" IRRIGATION

STREET	STATION	SLEEVE SIZE AND USE
ADDISON CIRCLE	16+08.00	1-4" IRRIGATION
ADDISON CIRCLE	16+17.00	4-4" & 2-2" TELEPHONE, 2-4" SPARE, 1-6" IRRIGATION
ADDISON CIRCLE	17+00.00	2-2" TV, 2-2" FIRE ALARM, 1-3" SPARE, 2-4" TELEPHONE
ADDISON CIRCLE	17+40.00	1-4" IRRIGATION, 2-4" ELECTRICAL
ADDISON CIRCLE	17+58.00	1-4" IRRIGATION
ADDISON CIRCLE	18+05.00	1-4" IRRIGATION
ADDISON CIRCLE	18+20.00	1-4" IRRIGATION
ADDISON CIRCLE	18+25.00	1-4" IRRIGATION, 2-4" ELECTRICAL
ADDISON CIRCLE	18+27.00	2-4" IRRIGATION
ADDISON CIRCLE	18+57.00	1-4" IRRIGATION
ADDISON CIRCLE	18+70.00	1-4" IRRIGATION
ADDISON CIRCLE	18+77.00	1-4" IRRIGATION
ADDISON CIRCLE	19+50.00	2-4" ELECTRICAL
ADDISON CIRCLE	20+68.00	1-4" IRRIGATION
ADDISON CIRCLE	20+85.00	1-4" IRRIGATION, 2-4" ELECTRICAL
ADDISON CIRCLE	21+46.00	4-4" & 2-2" TELEPHONE, 2-4" ELECTRICAL
ADDISON CIRCLE	22+60.00	2-4" ELECTRICAL, 1-4" IRRIGATION
ADDISON CIRCLE	22+78.00	1-4" IRRIGATION
ADDISON CIRCLE	23+50.00	2-4" ELECTRICAL, 1-4" IRRIGATION
ADDISON CIRCLE	24+80.00	2-4" ELECT., 1-6" GAS, 4-4" & 2-2" TELE., 1-4" IRR.
ADDISON CIRCLE	27+25.00	2-4" ELECTRICAL, 1-6" GAS, 4-4" TELEPHONE

DATE	DESCRIPTION	REF NO.
3/26/98	REVISED AND ADDED IRRIGATION SLEEVES	6
2/18/98	ADDED 4-4" TELEPHONE SLEEVES	5
1/28/98	ADDED 4-4" IRRIGATION SLEEVES	4
1/20/98	MISC. CONDUITS ADJUSTMENTS FOR PHONE	3
1/12/98	REVISED CONDUITS	2
10/3/97	ISSUED FOR CONSTRUCTION	N/A
9/26/97	REVISED QUANTITY OF CONDUITS	N/A
7/14/97	ISSUED FOR BID	N/A

SLEEVING PLAN						
ADDISON CIRCLE						
PHASE II PUBLIC INFRASTRUCTURE						
TOWN OF ADDISON, TEXAS						
Huitt-Zollars, Inc./Engineering/Architecture Dallas, Fort Worth, Houston, El Paso, Phoenix, Tustin, Ontario						
DESIGN	DRAWN	APPR.	SCALE	DATE	PROJECT NO.	NO.
HZ1	HZ1	DEM	1"=50'	JUN. 97	01-1822-21	P24