



ADV-D1

6" U.C. WHITE LETTERS
4-1/2" L.C. WHITE LETTERS
5" U.C. WHITE LETTERS (DIRECTION)
ON GREEN BACKGROUND
9' X 7' PANEL

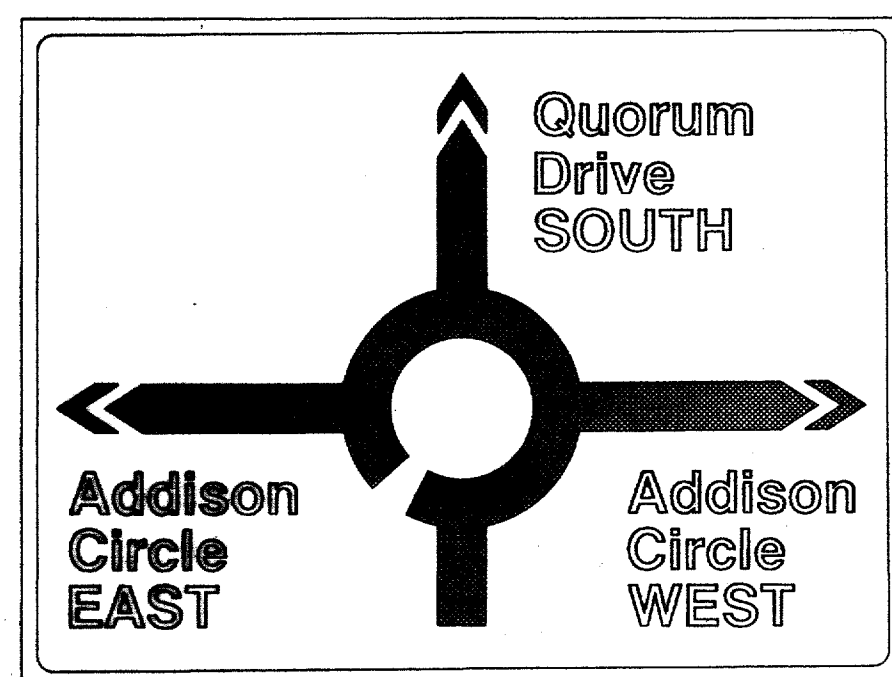


ADV-D2

6" U.C. WHITE LETTERS
4-1/2" L.C. WHITE LETTERS
5" U.C. WHITE LETTERS (DIRECTION)
ON GREEN BACKGROUND
9' X 7' PANEL

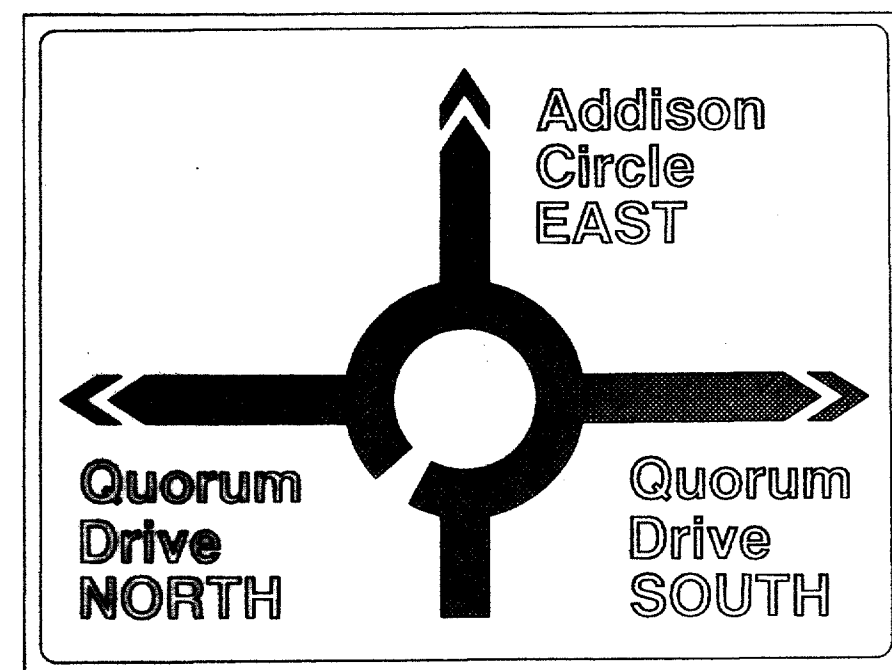


ADV-D3

6" U.C. WHITE LETTERS
4-1/2" L.C. WHITE LETTERS
5" U.C. WHITE LETTERS (DIRECTION)
ON GREEN BACKGROUND
9' X 7' PANEL

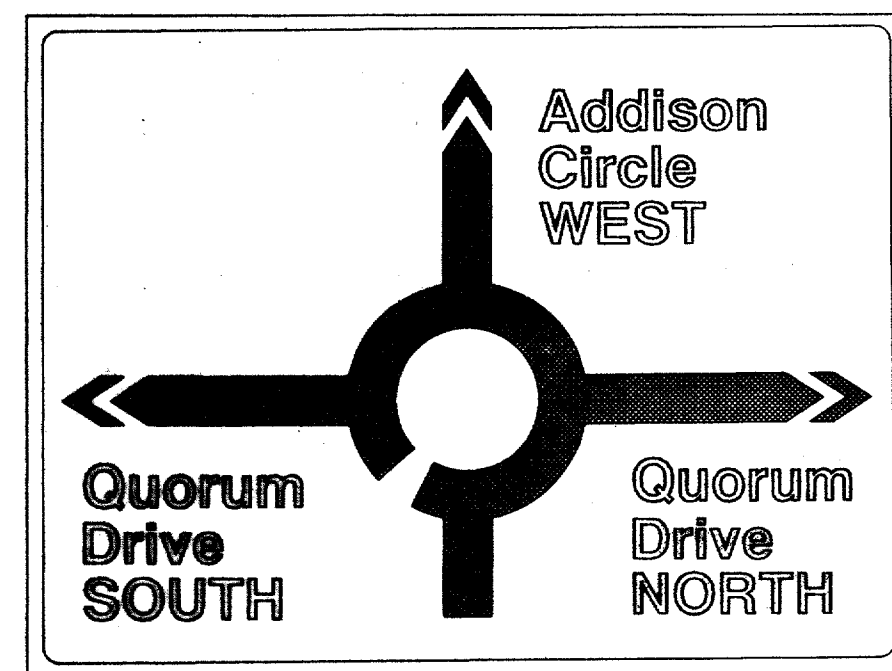


ADV-D4

6" U.C. WHITE LETTERS
4-1/2" L.C. WHITE LETTERS
5" U.C. WHITE LETTERS (DIRECTION)
ON GREEN BACKGROUND
9' X 7' PANEL

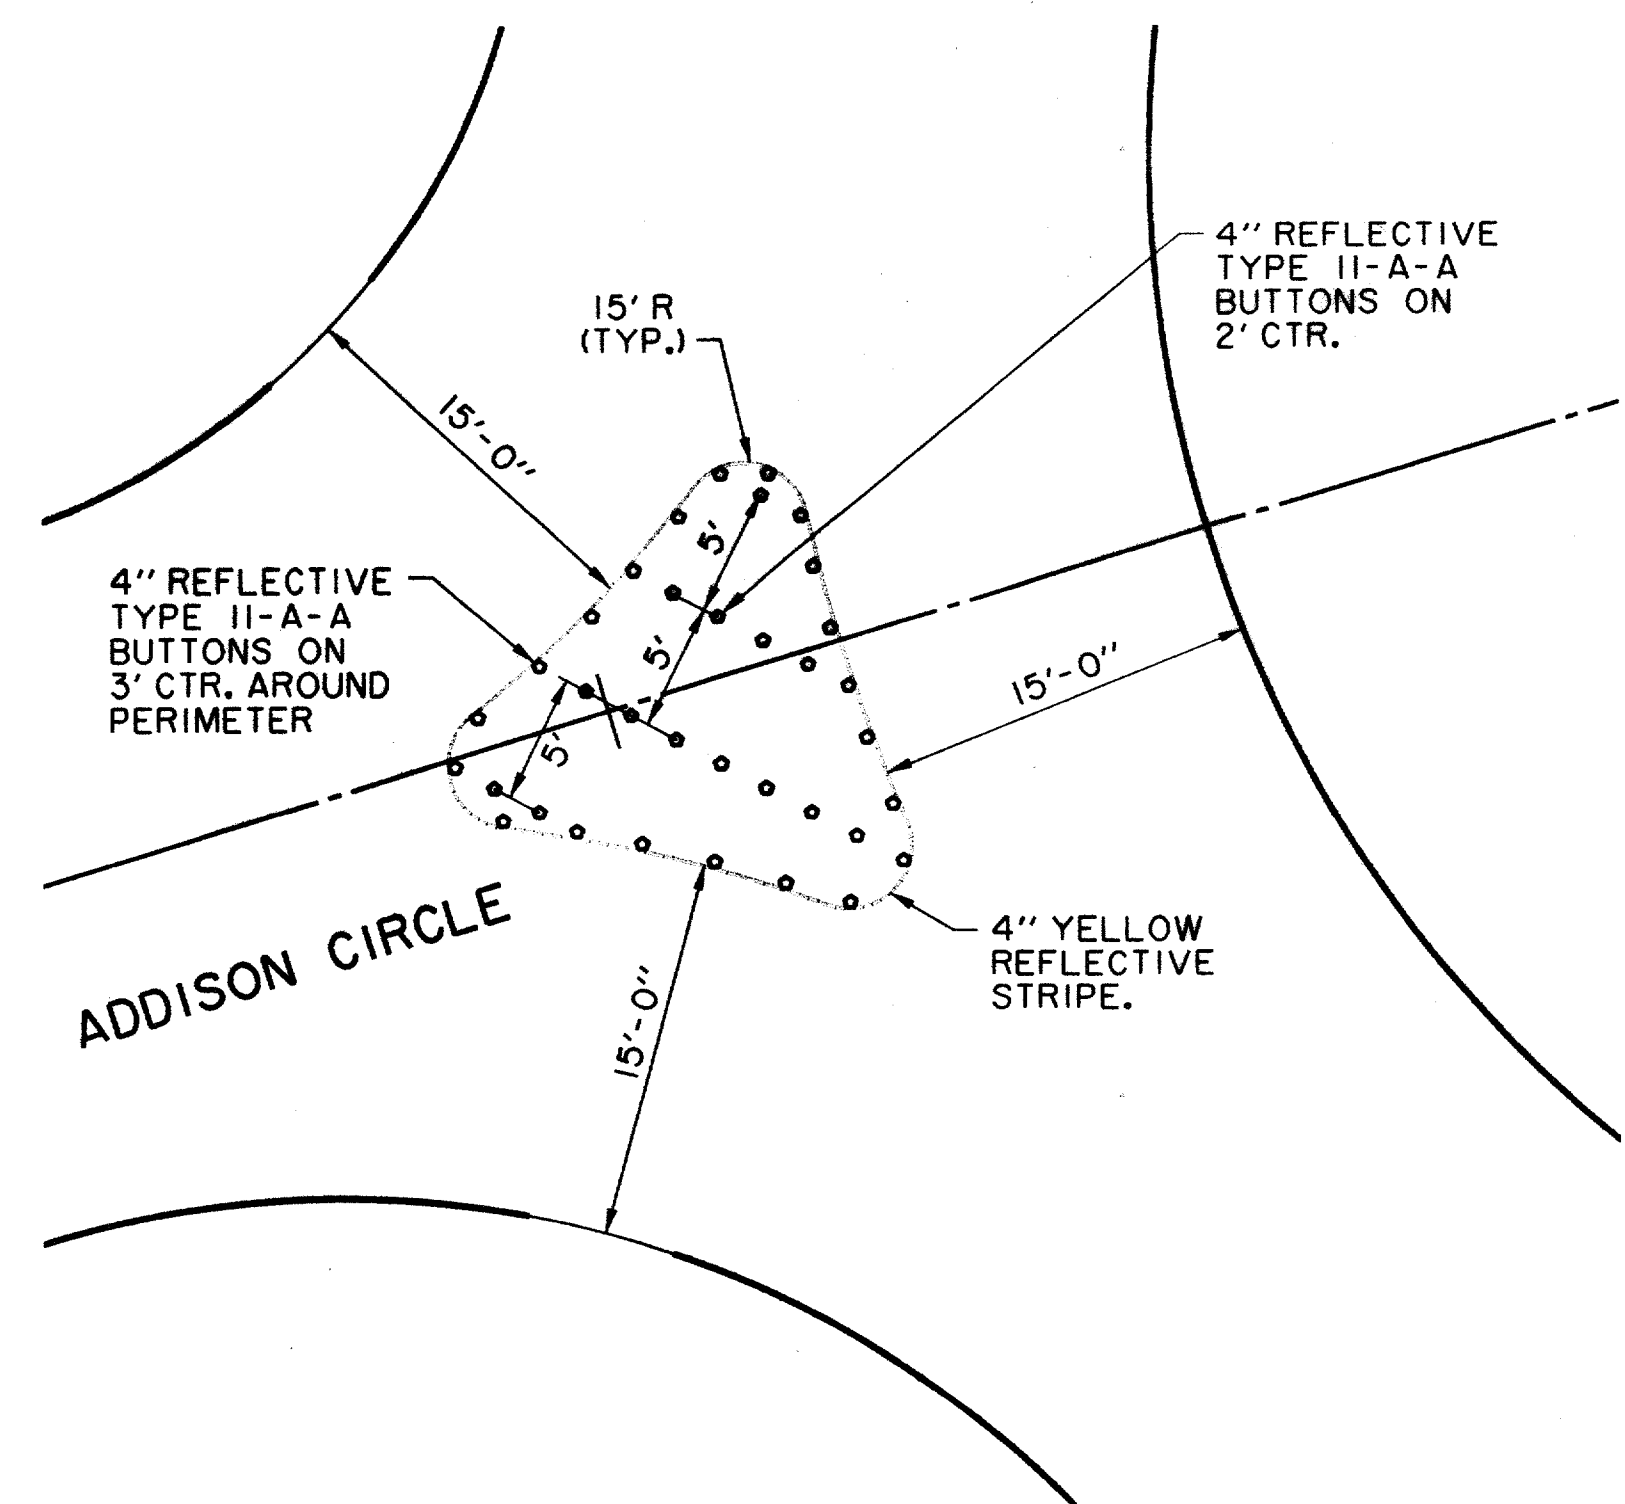


FLUSH ISLAND DETAIL

N.T.S.
(AT WEST END OF PARK)

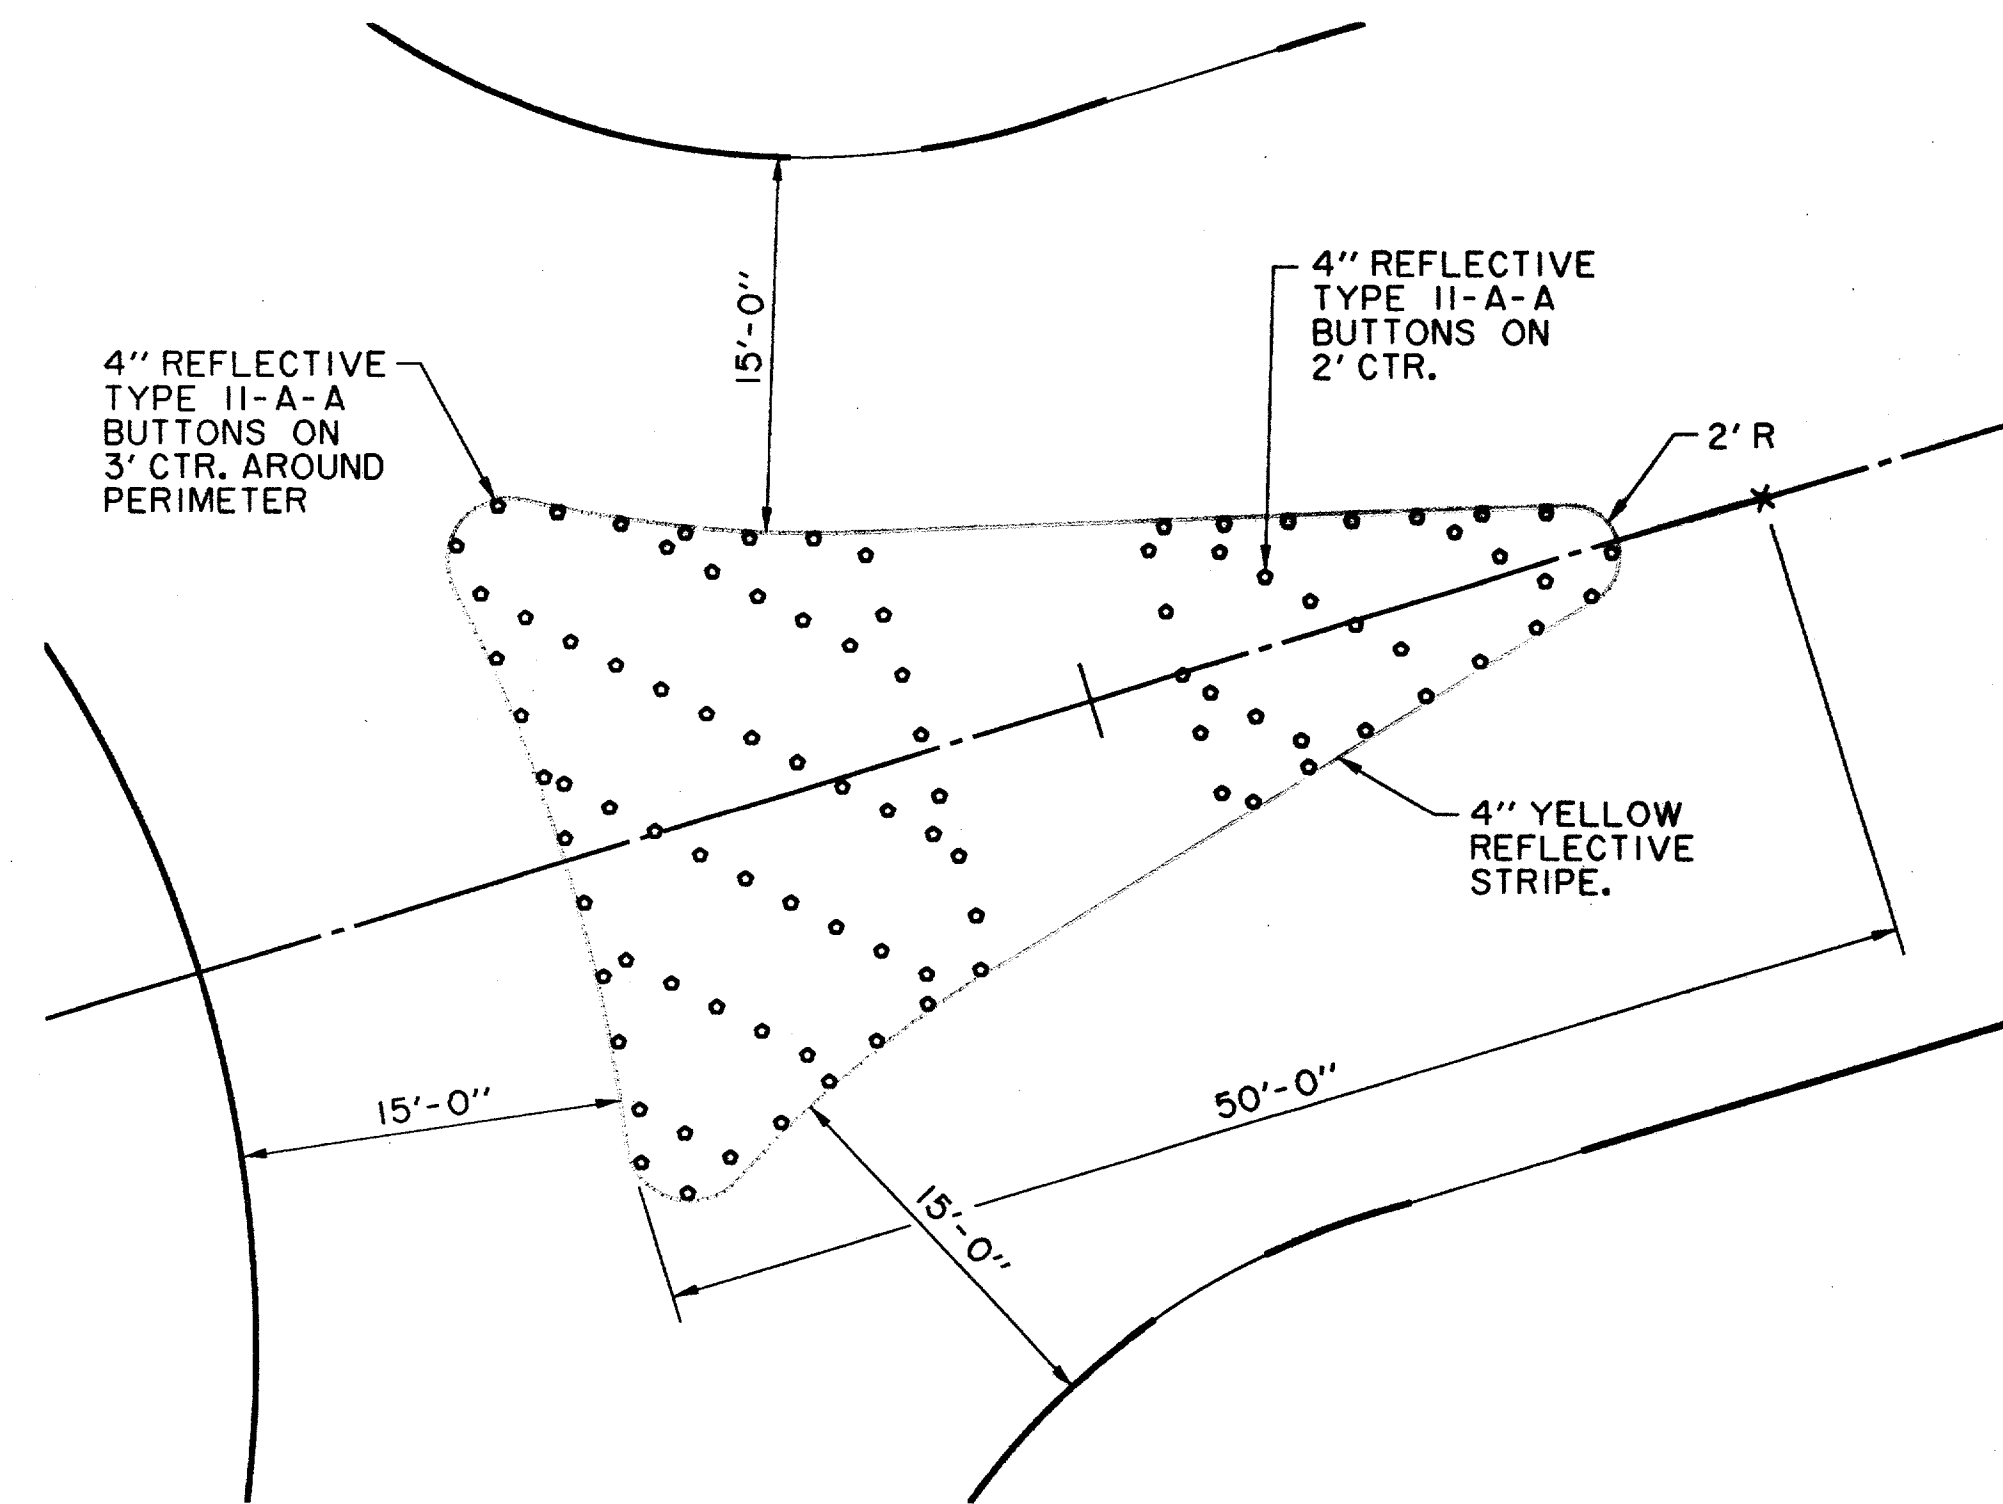

FLUSH ISLAND DETAIL


N.T.S.
(AT EAST END OF PARK)

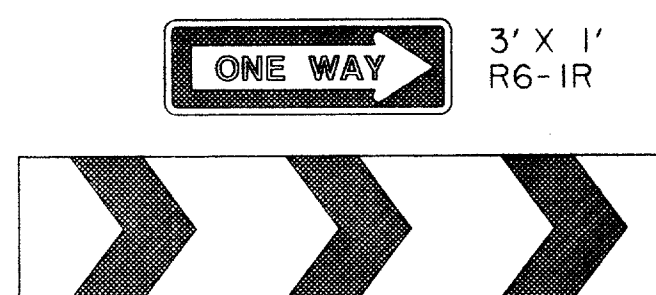

W-CHEV WITH RIO

ON CENTRAL ISLANDS
OPPOSITE EVERY ENTRY

BLACK ON YELLOW
6.75' X 1.5' PANEL
MWI-8A (MOD.)

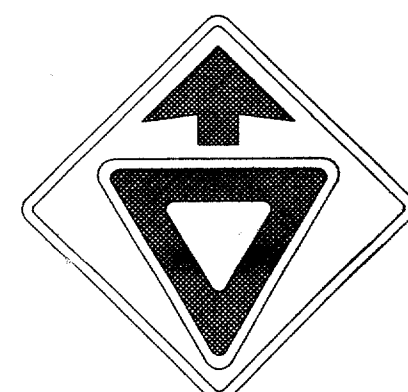


YIELD AT
ROUNDBOUT

RI-2

3' x 3' PANEL
W3-2A

4" BLACK LETTERS
4' x 18" PANEL
ADV-D5

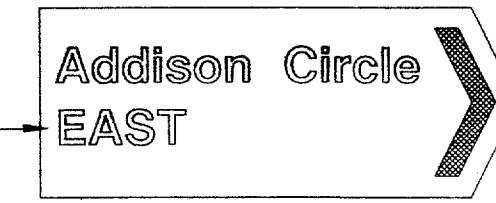


4" WHITE LETTERS

ST-1

5" U.C. WHITE LETTERS
4" L.C. WHITE LETTERS
ON GREEN BACKGROUND
5' x 2' PANEL

THE SEAL APPEARING ON THIS DOCUMENT WAS AUTHORIZED BY DAVID E. MEYERS, P.E. 81512

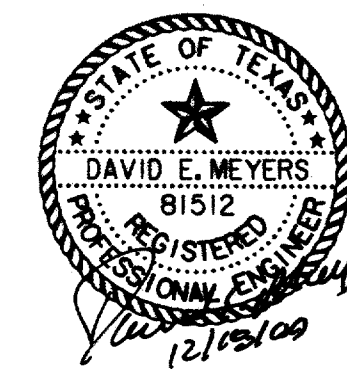

RECORD
DRAWING

DATE	DESCRIPTION	REF NO.
10/3/97	ISSUED FOR CONSTRUCTION	N/A
7/14/97	ISSUED FOR BID	N/A

TRAFFIC SIGN DETAILS

ADDISON CIRCLE

PHASE II PUBLIC INFRASTRUCTURE

TOWN OF ADDISON, TEXAS

Hull-Zollars, Inc./Engineering/Architecture
Dallas, Fort Worth, Houston, El Paso, Phoenix, Tustin, Ontario

DESIGN	DRAWN	APPR.	SCALE	DATE	PROJECT NO.	NO.
HZI	HZI	DEM	N.T.S.	OCT. 97	01-1822-21	P6