


ALL DIMENSIONS ARE IN FEET AND DECIMALS THEREOF. ALL DIMENSIONS SHALL BE TO THE CENTERLINE OF THE ROAD OR TO THE FACE OF THE CURB OR TO THE FACE OF THE WALL OR TO THE FACE OF THE CONCRETE OR TO THE FACE OF THE BRICK OR TO THE FACE OF THE BLOCK OR TO THE FACE OF THE TILE OR TO THE FACE OF THE SLAB OR TO THE FACE OF THE JOINT OR TO THE FACE OF THE FINISH SURFACE UNLESS OTHERWISE SPECIFIED. ALL DIMENSIONS SHALL BE TO THE CENTERLINE OF THE ROAD OR TO THE FACE OF THE CURB OR TO THE FACE OF THE WALL OR TO THE FACE OF THE CONCRETE OR TO THE FACE OF THE BRICK OR TO THE FACE OF THE BLOCK OR TO THE FACE OF THE TILE OR TO THE FACE OF THE SLAB OR TO THE FACE OF THE JOINT OR TO THE FACE OF THE FINISH SURFACE UNLESS OTHERWISE SPECIFIED.

RECORD DRAWING

THE SEAL APPEARING ON THIS DOCUMENT WAS AUTHORIZED BY DAVID E. MEYERS, P.E. 81512

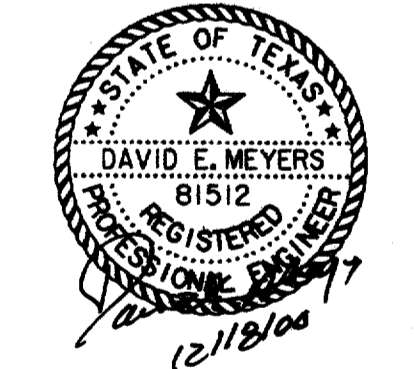

DATE	DESCRIPTION	REF. NO.
10/3/97	ISSUED FOR CONSTRUCTION	N/A
7/14/97	ISSUED FOR BID	N/A

PAVING SITE PLAN						
ADDISON CIRCLE						
PHASE II PUBLIC INFRASTRUCTURE						
TOWN OF ADDISON, TEXAS						
Hullitt-Zollars, Inc./Engineering/Architecture Dallas, Fort Worth, Houston, El Paso, Phoenix, Tustin, Ontario						
DESIGN	DRAWN	APPR.	SCALE	DATE	PROJECT NO.	NO.
HZI	HZI	DEM	1"=50'	OCT. 97	01-1822-21	P7