


SEE SHEET P21 FOR PAVING AND GRADING GENERAL NOTES.

RECORD DRAWING

LEGEND

ELECTRIC — ONE —	MISC.
○ LIGHT POLE	48" RCP EX. STORM SEWER
PP POWER POLE	— CHAIN LINK FENCE
— GUY WIRE	— WOOD FENCE
TELEPHONE — T —	— EXISTING ASPHALT
TELEPHONE MANHOLE	— EXISTING DIRT OR GRAVEL
TELEPHONE PEDESTAL	— EX. CONCRETE
TELEPHONE SIGN	— EXISTING CURB
GAS — G —	— TREE/TREE LINE
GAS METER	— PROP. CURB
GAS SIGN	— PROP. EDGE OF PAVEMENT NO CURB
LAND USE	— EX. PROPERTY LINE
RAILROAD SIGN	— PROP. CENTERLINE
SIGN	— PROP. R.O.W.
SURVEY	— PROP. INLET
FOUND IRON ROD	T.P. TOP OF PAVEMENT
BENCHMARK	T.C. TOP OF CURB
WASTEWATER — WW —	CR CURB RETURN
WASTEWATER MANHOLE	EX. G EXISTING GUTTER
CLEANOUT	EX. T.C. EXISTING TOP OF CURB
WATER — W —	B-20 BORING LOCATION
FIRE HYDRANT	— EXISTING BRICKS
METER	— PAVEMENT REMOVAL
WATER VALVE	

BENCHMARKS:
 BM#1
 "C" CUT AT CENTER BACK OF CURB OF INLET, 190 FEET SOUTH FROM THE CENTERLINE INTERSECTION OF ADDISON CIRCLE, WEST SIDE OF QUORUM DRIVE. ELEV. 621.89
 BM#4
 "C" CUT AT CENTER OF CURB INLET, 1015 FEET NORTH FROM THE CENTERLINE INTERSECTION OF ADDISON CIRCLE, WEST SIDE OF QUORUM DRIVE. ELEV. 629.36

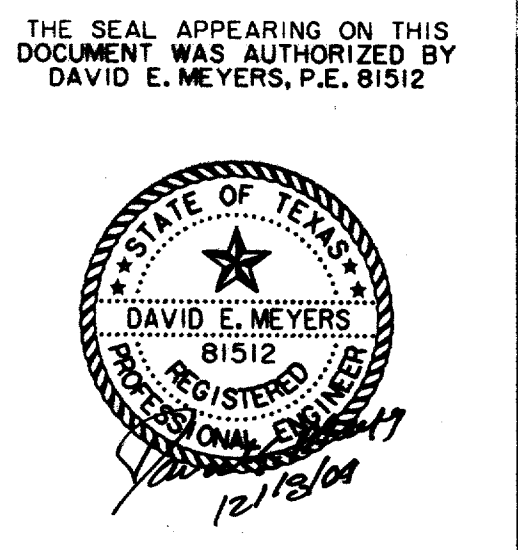

DATE	DESCRIPTION	REF. NO.
2/13/98	REVISED RAMP; REVISED PLANTING LEAVEOUTS	3
12/15/97	ADDED CURB CUTS FOR TRASH PICK UP; REVISED 6" CONC. SUB-BASE AREA	2
10/3/97	ISSUED FOR CONSTRUCTION	N/A
8/4/97	REVISED RADIUS AT SW CORNER	1
7/14/97	M-3/QUORUM DR.	N/A
7/14/97	ISSUED FOR BID	N/A

PAVING PLAN					
QUORUM DRIVE					
ADDISON CIRCLE					
PHASE II PUBLIC INFRASTRUCTURE					
TOWN OF ADDISON, TEXAS					
Hull-H-Zollars, Inc./Engineering/Architecture Dallas, Fort Worth, Houston, El Paso, Phoenix, Tustin, Ontario					
DESIGN	DRAWN	APPR.	SCALE	DATE	PROJECT NO.
HZI	HZI	DEM	1"=20'	OCT. 97	01-1822-21
					NO.
					P8

THE SEAL APPEARING ON THIS DOCUMENT WAS AUTHORIZED BY DAVID E. MEYERS, P.E., 81512
 REGISTERED PROFESSIONAL ENGINEER, STATE OF TEXAS, 12/13/04
 PROJECT NO. 01-1822-21-08
 SHEET P8 OF 10
 DATE: 10/20/97
 DRAWN BY: HZI
 CHECKED BY: DEM
 APPROVED BY: HZI
 TITLE: PAVING PLAN
 PROJECT: PHASE II PUBLIC INFRASTRUCTURE
 LOCATION: QUORUM DRIVE, ADDISON CIRCLE, TOWN OF ADDISON, TEXAS