

SEE SHEET P21 FOR PAVING AND GRADING GENERAL NOTES.

RECORD DRAWING


LEGEND

ELECTRIC — ONE —	MISC.
○ LIGHT POLE	48" RCP EX. STORM SEWER
PP POWER POLE	CHAIN LINK FENCE
— GUY WIRE	WOOD FENCE
TELEPHONE — T —	EXISTING ASPHALT
TELEPHONE MANHOLE	EXISTING DIRT OR GRAVEL
TELEPHONE PEDESTAL	EX. CONCRETE
TELEPHONE SIGN	EXISTING CURB
GAS — G —	TREE/TREE LINE
GAS METER	PROP. CURB
GAS SIGN	PROP. EDGE OF PAVEMENT NO CURB
LAND USE	EX. PROPERTY LINE
RAILROAD SIGN	PROP. CENTERLINE
SIGN	PROP. R.O.W.
SURVEY	PROP. INLET
FOUND IRON ROD	T.P. TOP OF PAVEMENT
BENCHMARK	T.C. TOP OF CURB
WASTEWATER — WW —	CR CURB RETURN
WASTEWATER MANHOLE	EX. G EXISTING GUTTER
CLEANOUT	EX. T.C. EXISTING TOP OF CURB
WATER — W —	B-20 BORING LOCATION
FIRE HYDRANT	EXISTING BRICKS
METER	PAVEMENT REMOVAL
WATER VALVE	

BENCHMARKS:

BM#1
"C" CUT AT CENTER BACK OF CURB OF INLET, 190 FEET SOUTH FROM THE CENTERLINE INTERSECTION OF ADDISON CIRCLE, WEST SIDE OF QUORUM DRIVE. ELEV. 621.89

BM#4
"C" CUT AT CENTER OF CURB INLET, 1015 FEET NORTH FROM THE CENTERLINE INTERSECTION OF ADDISON CIRCLE, WEST SIDE OF QUORUM DRIVE. ELEV. 629.36

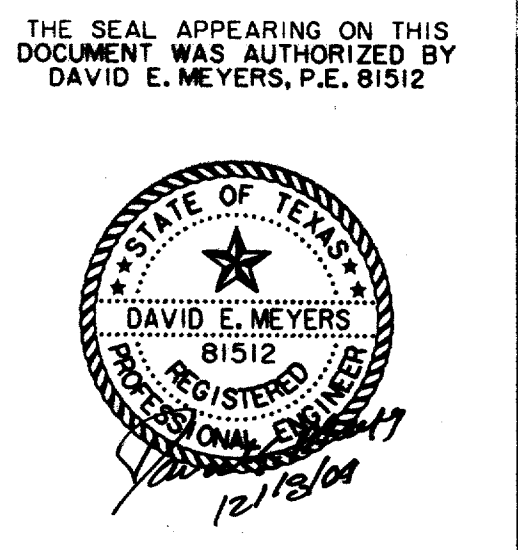

DATE	DESCRIPTION	REF. NO.
2/13/98	REVISED RAMP; REVISED PLANTING LEAVEOUTS	3
12/15/97	ADDED CURB CUTS FOR TRASH PICK UP; REVISED 6" CONC. SUB-BASE AREA	2
10/3/97	ISSUED FOR CONSTRUCTION	N/A
8/4/97	REVISED RADIUS AT SW CORNER	1
7/14/97	M-3/QUORUM DR.	N/A
7/14/97	ISSUED FOR BID	N/A

PAVING PLAN
QUORUM DRIVE
ADDISON CIRCLE
PHASE II PUBLIC INFRASTRUCTURE
TOWN OF ADDISON, TEXAS

Hull-H-Zollars, Inc./Engineering/Architecture
Dallas, Fort Worth, Houston, El Paso, Phoenix, Tustin, Ontario

DESIGN	DRAWN	APPR.	SCALE	DATE	PROJECT NO.	NO.
HZI	HZI	DEM	1"=20'	OCT. 97	01-1822-21	P8

PROJECT NO. 01-1822-21
 SHEET NO. P8
 DATE: OCT. 97
 DRAWN BY: HZI
 CHECKED BY: DEM
 APPROVED BY: [Signature]
 TITLE: [Title]
 FIRM: HULL-H-ZOLLARS, INC.