


H:\PROJECTS\ADDISON\ADDISON.DWG  
 PLOT DATE: 10/14/97  
 PLOT SCALE: 1/4"=20'  
 PLOT SHEET: 1 OF 2  
 PLOT AREA: 11.5 X 17.5  
 PLOT ORIGIN: 10.0, 17.5  
 PLOT SCALE: 1/4"=20'  
 PLOT SHEET: 1 OF 2  
 PLOT AREA: 11.5 X 17.5  
 PLOT ORIGIN: 10.0, 17.5

THE SEAL APPEARING ON THIS DOCUMENT WAS AUTHORIZED BY KAREN W. KOERTH, L.A. 1594

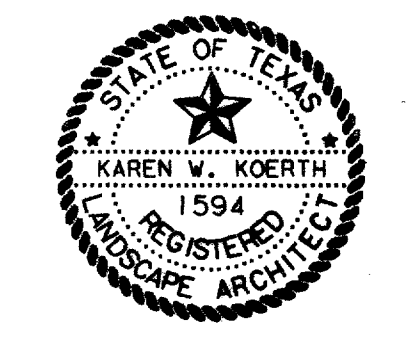

# RECORD DRAWING

DATE	DESCRIPTION	REF. NO.
10/3/97	ISSUED FOR CONSTRUCTION	N/A
7/14/97	ISSUED FOR BID	N/A

**PLANTING & FURNITURE PLAN**  
**SPECTRUM DRIVE**  
**ADDISON CIRCLE**  
**PHASE II PUBLIC INFRASTRUCTURE**  
**TOWN OF ADDISON, TEXAS**  
 Huiit-Zollars, Inc./Engineering/Architecture  
 Dallas, Fort Worth, Houston, El Paso, Phoenix, Tustin, Ontario

DESIGN	DRAWN	APPR.	SCALE	DATE	PROJECT NO.	NO.
HZ1	HZ1	KWK	1"=20'	OCT. 97	01-1822-21	<b>PF5</b>