


J SPECIAL DETAIL
SEE SHEET SP9

RECORD DRAWING

LEGEND

	ELECTRIC — O —		MISC.
	POWER POLE		EX. STORM SEWER
	GUY WIRE		CHAIN LINK FENCE
	TELEPHONE — T —		WOOD FENCE
	TELEPHONE MANHOLE		EXISTING ASPHALT
	TELEPHONE PEDESTAL		EXISTING DIRT OR GRAVEL
	GAS — G —		EX. CONCRETE
	GAS METER		TREE/TREE LINE
	GAS SIGN		EXISTING CURB
	LAND USE		PROP. CURB
	RAILROAD SIGN		PROP. EDGE OF PAVEMENT NO CURB
	SIGN		EX. PROPERTY LINE
	SURVEY		PROP. CENTERLINE
	FOUND IRON ROD		PROP. R.O.W.
	BENCHMARK		PROP. INLET
	WASTEWATER — WW —		T.P. TOP OF PAVEMENT
	WASTEWATER MANHOLE		T.C. TOP OF CURB
	CLEANOUT		CR CURB RETURN
	WATER — W —		EX. G. EXISTING GUTTER
	FIRE HYDRANT		EX. T.C. EXISTING TOP OF CURB
	METER		B-20 BORING LOCATION
	WATER VALVE		EXISTING BRICKS
			PAVEMENT REMOVAL

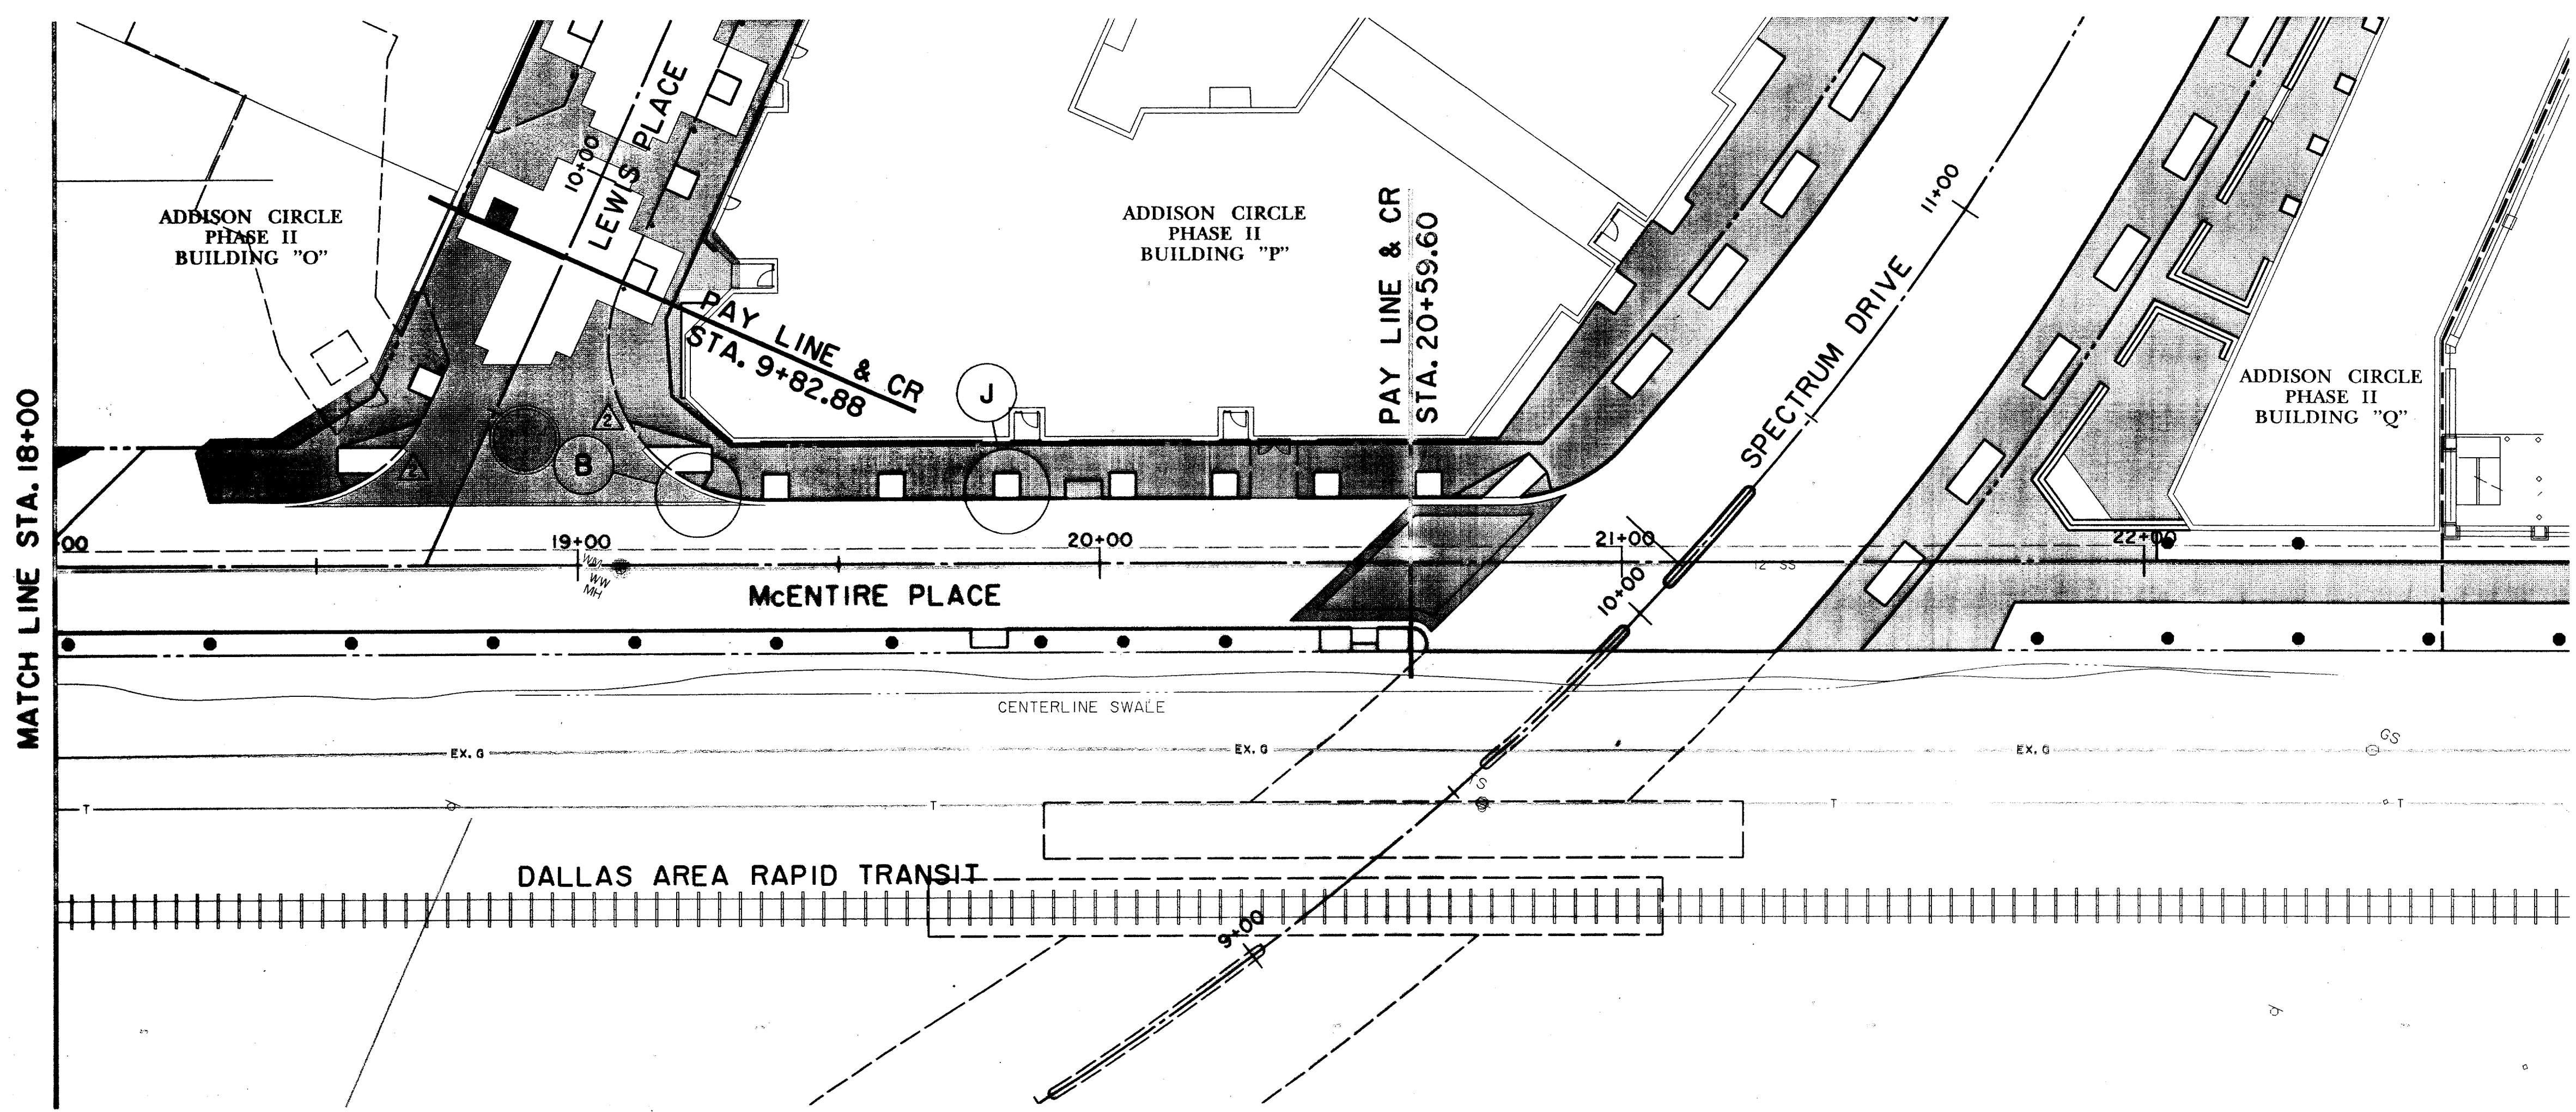

BENCHMARKS:
 BM#1
 "C" CUT AT CENTER BACK OF CURB OF INLET, 190 FEET SOUTH FROM THE CENTERLINE INTERSECTION OF ADDISON CIRCLE, WEST SIDE OF QUORUM DRIVE. ELEV. 621.89
 BM#4
 "C" CUT AT CENTER OF CURB INLET, 1015 FEET NORTH FROM THE CENTERLINE INTERSECTION OF ADDISON CIRCLE, WEST SIDE OF QUORUM DRIVE. ELEV. 629.36

THE SEAL APPEARING ON THIS DOCUMENT WAS AUTHORIZED BY DAVID E. MEYERS, P.E. 81512

DATE	DESCRIPTION	REF. NO.
2/13/98	REVISED PATTERNING AT SHIFTED RAMPS	
12/15/97	SHIFTED DRIVE	
10/3/97	ISSUED FOR CONSTRUCTION	N/A
7/14/97	ISSUED FOR BID	N/A

SURFACE PATTERNING PLAN
M-3

ADDISON CIRCLE
PHASE II PUBLIC INFRASTRUCTURE
TOWN OF ADDISON, TEXAS

Huiji-Zollars, Inc./Engineering/Architecture
Dallas, Fort Worth, Houston, El Paso, Phoenix, Tustin, Ontario

DESIGN	DRAWN	APPR.	SCALE	DATE	PROJECT NO.	NO.
HZI	HZI	DEM	1"=20'	OCT. 97	01-1822-21	SP8