


# RECORD DRAWING

THE SEAL APPEARING ON THIS DOCUMENT WAS AUTHORIZED BY DAVID E. MEYERS, P.E. 81512

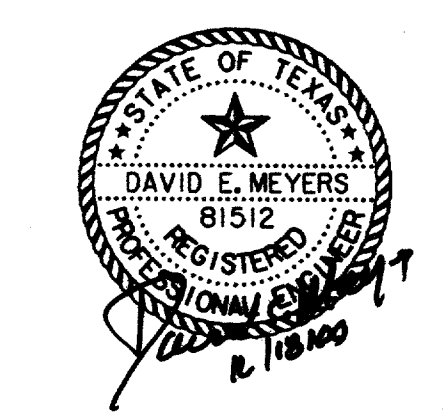

NOTE:  
STREETS M-2 SOUTH AND M-2 NORTH WILL HAVE HANGING LIGHTS. STREET M-3 WILL HAVE WALL MOUNTED LIGHTS. SEE ARCHITECTURAL PLANS FOR TIES TO THE BUILDINGS. HANGING LIGHTS AND WALL LIGHTS TO BE INSTALLED UNDER A SEPARATE CONTRACT.

DATE	DESCRIPTION	REF. NO.
10/3/97	ISSUED FOR CONSTRUCTION	N/A
7/14/97	ISSUED FOR BID	N/A

<b>STREETSCAPE SITE PLAN</b>						
<b>ADDISON CIRCLE</b>						
<b>PHASE II PUBLIC INFRASTRUCTURE</b>						
<b>TOWN OF ADDISON, TEXAS</b>						
<small>Huitt-Zollars, Inc./Engineering/Architecture Dallas, Fort Worth, Houston, El Paso, Phoenix, Tustin, Ontario</small>						
DESIGN	DRAWN	APPR.	SCALE	DATE	PROJECT NO.	NO.
HZI	HZI	DEM	1"=50'	OCT. 97	01-1822-21	STI