
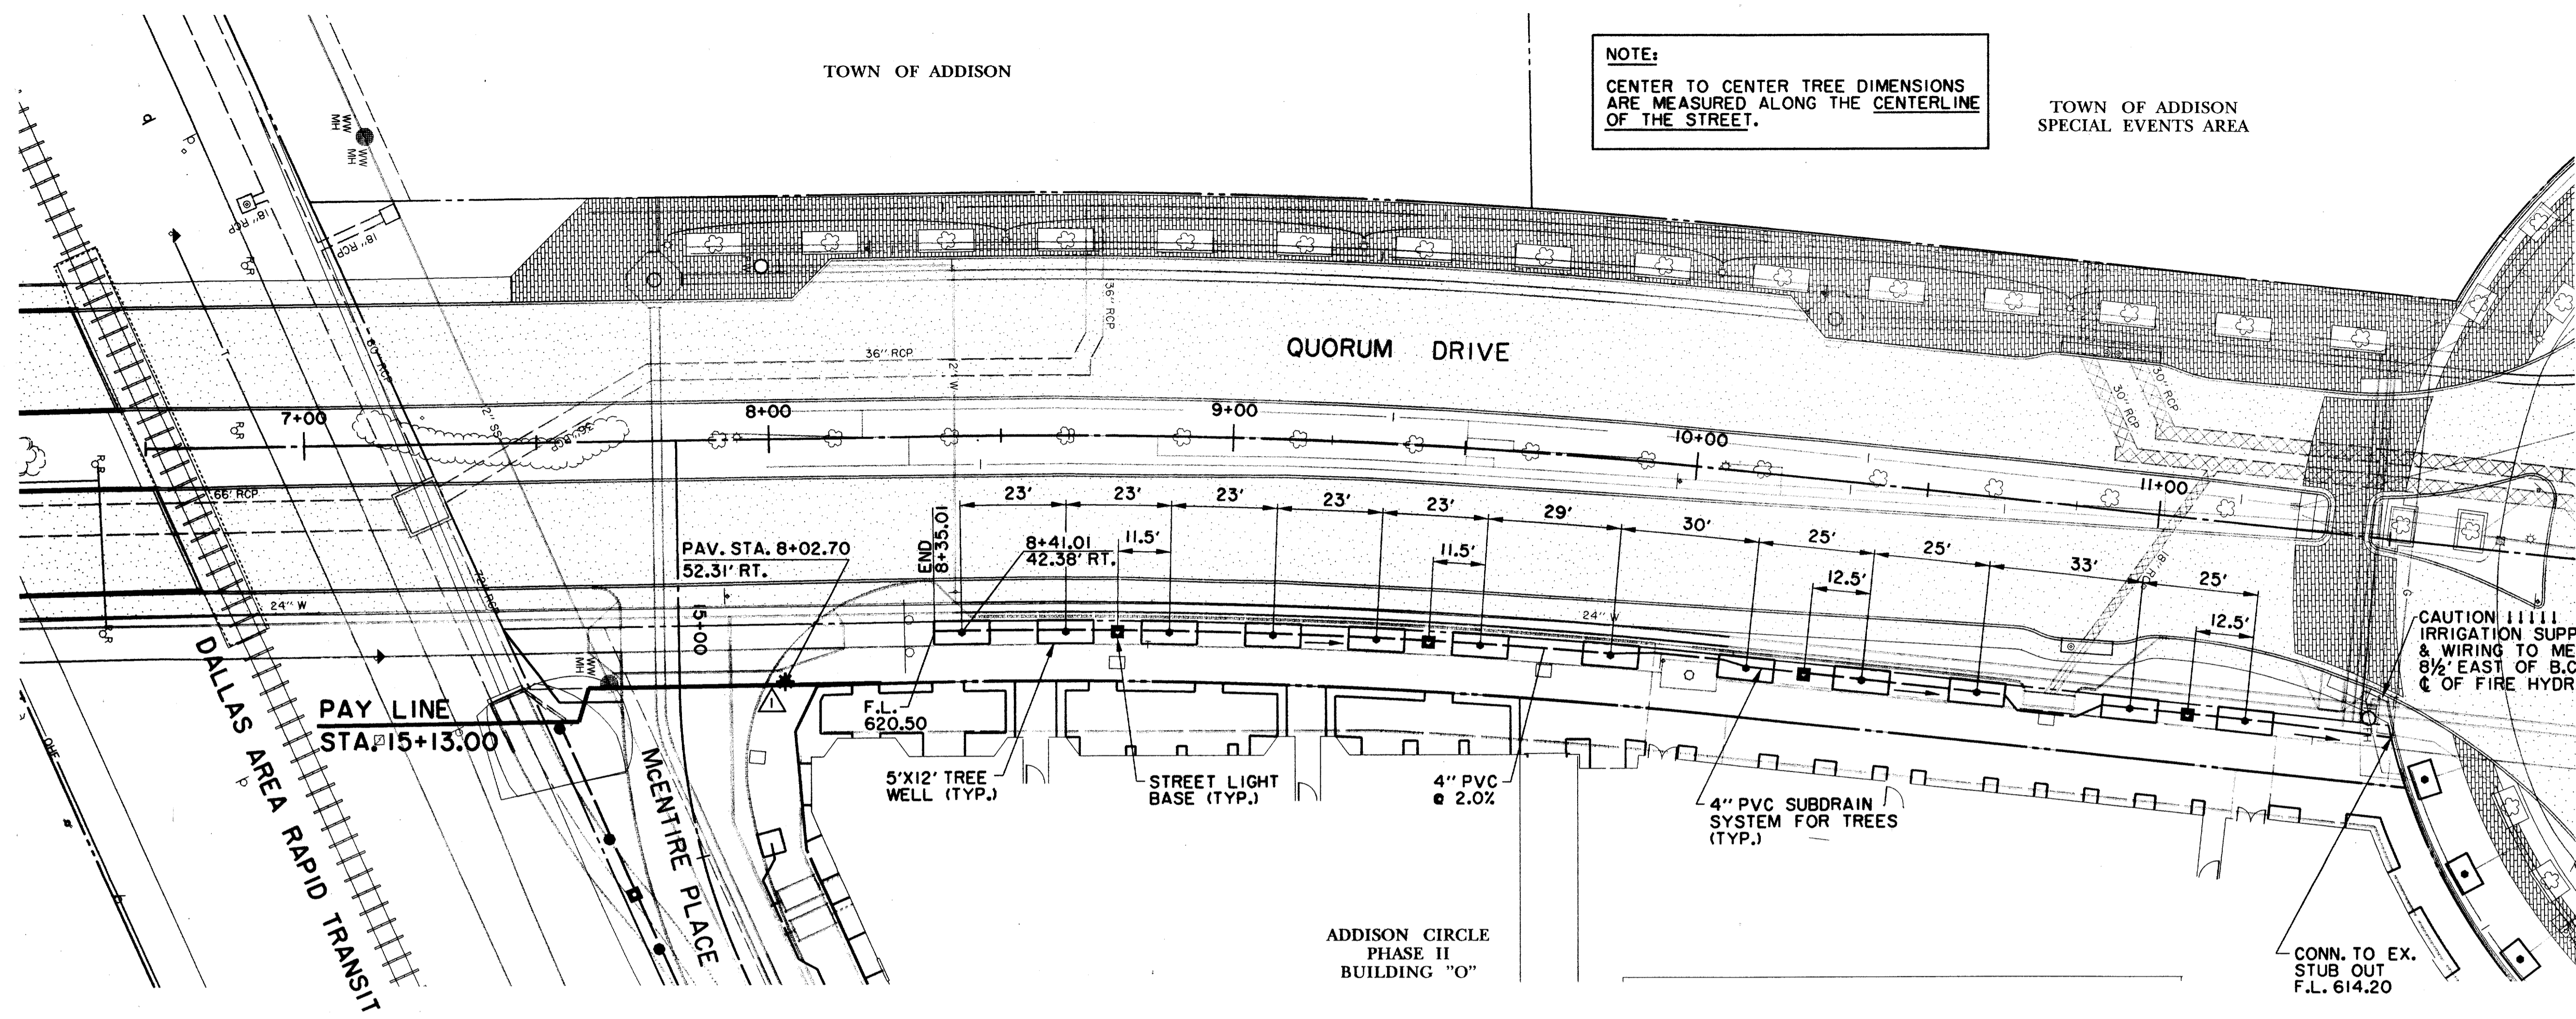


TOWN OF ADDISON

NOTE:
CENTER TO CENTER TREE DIMENSIONS
ARE MEASURED ALONG THE CENTERLINE
OF THE STREET.


TOWN OF ADDISON
SPECIAL EVENTS AREA

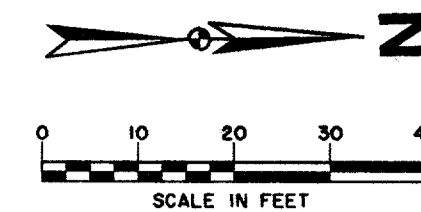

RECORD DRAWING

LEGEND

	ELECTRIC — ONE		MISC. 48" RCP
	○ LIGHT POLE		EX. STORM SEWER
	PP POWER POLE		CHAIN LINK FENCE
	← GUY WIRE		WOOD FENCE
	TELEPHONE — T		EXISTING ASPHALT
	TELEPHONE MANHOLE		EXISTING DIRT OR GRAVEL
	TELEPHONE PEDESTAL		EX. CONCRETE
	TELEPHONE SIGN		TREE/TREE LINE
	GAS — G		EXISTING CURB
	GAS METER		PROP. CURB
	GAS SIGN		PROP. EDGE OF PAVEMENT NO CURB
	LAND USE		EX. PROPERTY LINE
	RAILROAD SIGN		PROP. CENTERLINE
	SIGN		PROP. R.O.W.
	SURVEY		PROP. INLET
	FOUND IRON ROD		T.P. TOP OF PAVEMENT
	BENCHMARK		T.C. TOP OF CURB
	WASTEWATER — WW		C.R. CURB RETURN
	WASTEWATER MANHOLE		EX. G EXISTING GUTTER
	CLEANOUT		EX. T.C. EXISTING TOP OF CURB
	WATER — W		B-20 BORING LOCATION
	FIRE HYDRANT		EXISTING BRICKS
	METER		PAVEMENT REMOVAL
	WATER VALVE		

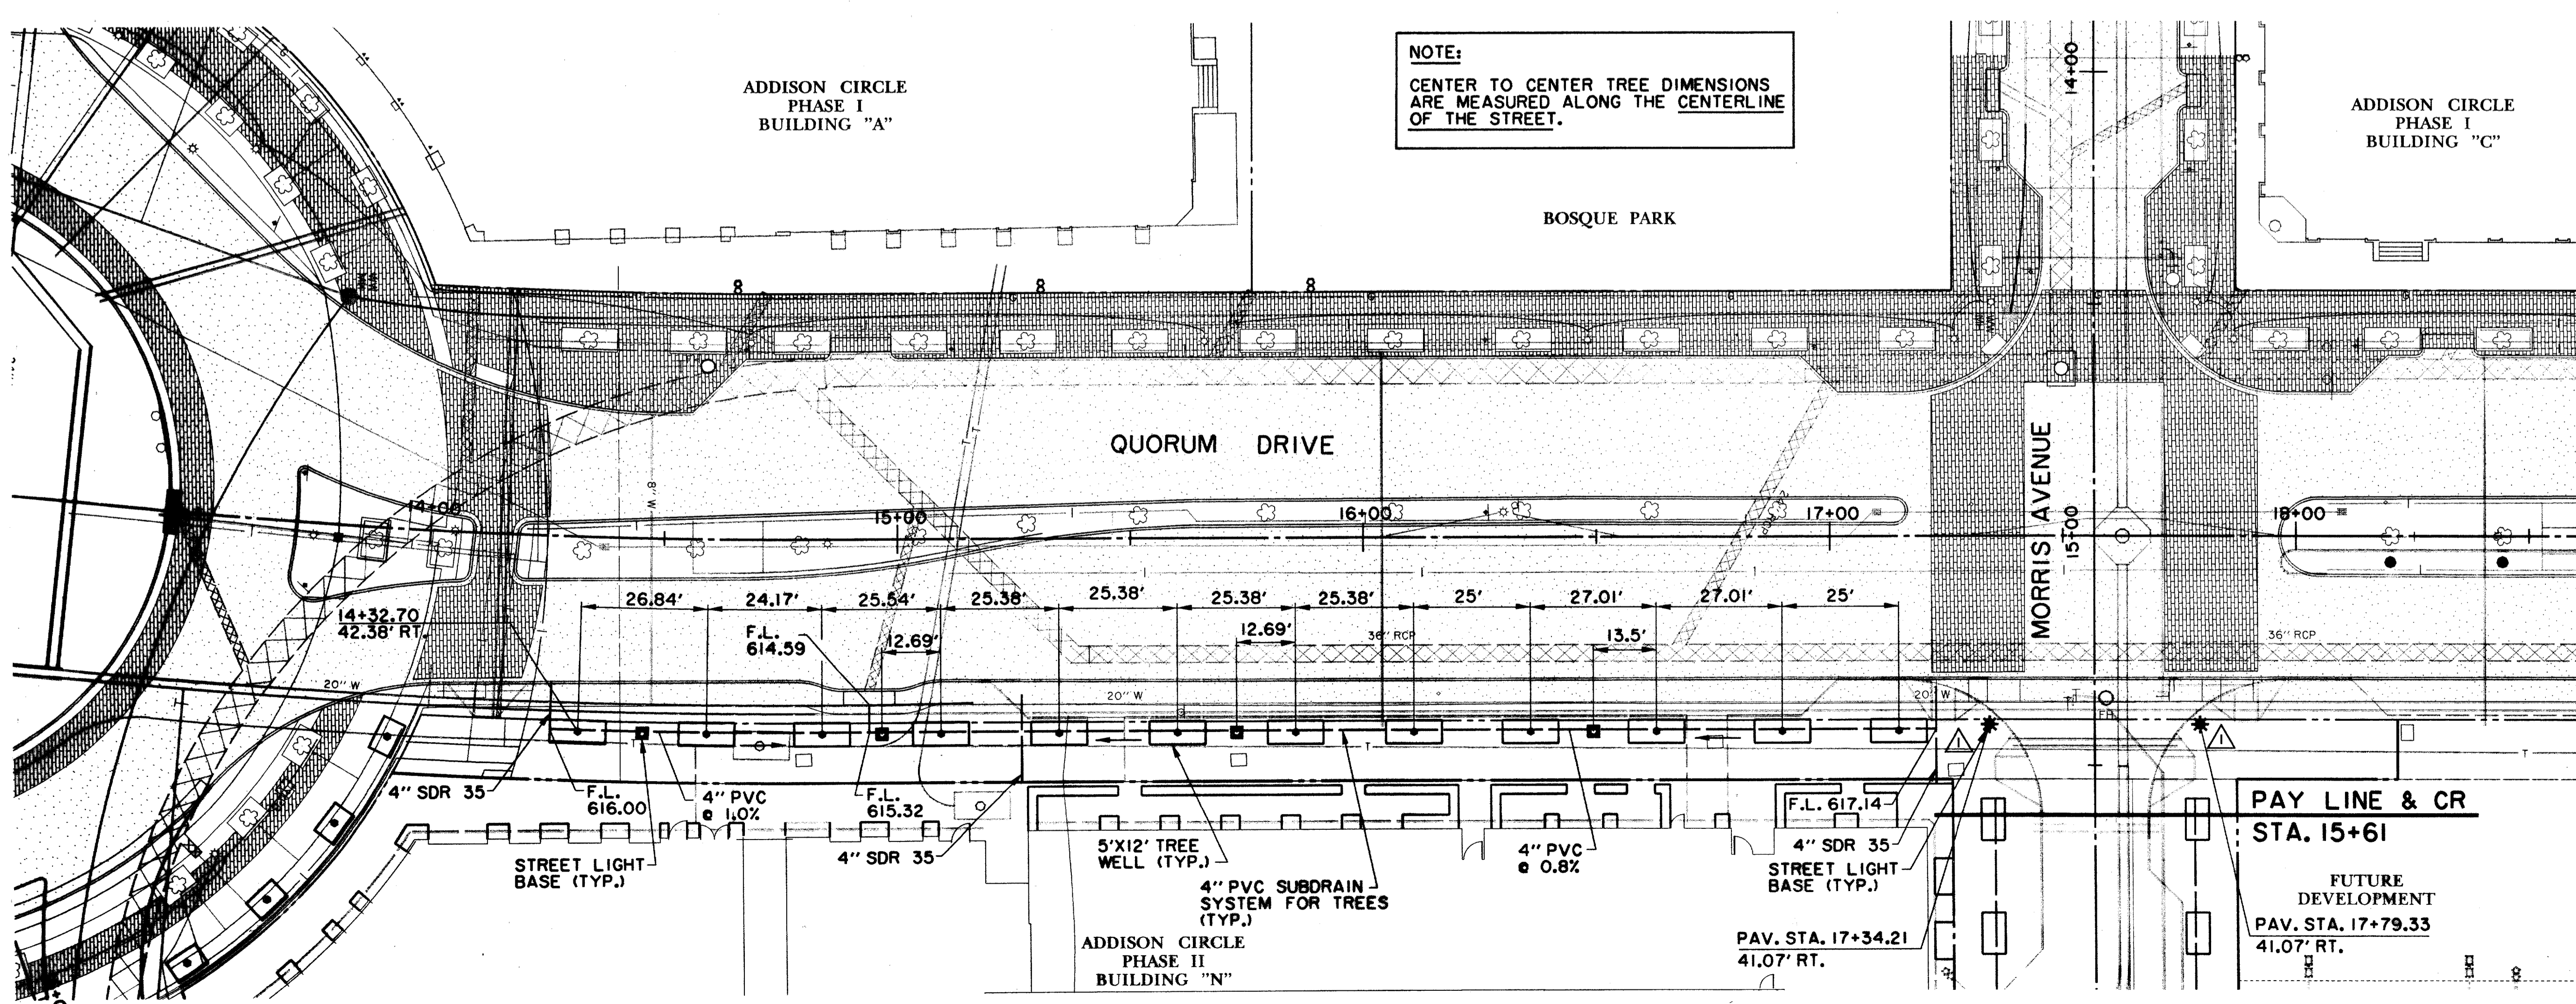

NOTE:
CENTER TO CENTER TREE DIMENSIONS
ARE MEASURED ALONG THE CENTERLINE
OF THE STREET.

BENCHMARKS:
BM#1
"1" CUT AT CENTER BACK OF CURB OF INLET, 190 FEET SOUTH FROM THE CENTERLINE INTERSECTION OF ADDISON CIRCLE, WEST SIDE OF QUORUM DRIVE. ELEV. 621.89
BM#4
"1" CUT AT CENTER OF CURB INLET, 1015 FEET NORTH FROM THE CENTERLINE INTERSECTION OF ADDISON CIRCLE, WEST SIDE OF QUORUM DRIVE. ELEV. 629.36

THE SEAL APPEARING ON THIS DOCUMENT WAS AUTHORIZED BY DAVID E. MEYERS, P.E. 81512

DATE	DESCRIPTION	REF. NO.
10/3/97	ISSUED FOR CONSTRUCTION	N/A
7/14/97	ISSUED FOR BID	N/A
	SHIFTED TREE; CHANGED LIGHT LOCATION AND TYPE	

STREETScape PLAN	
QUORUM DRIVE	
ADDISON CIRCLE	
PHASE II PUBLIC INFRASTRUCTURE	
TOWN OF ADDISON, TEXAS	
Huitt-Zollars, Inc./Engineering/Architecture Dallas, Fort Worth, Houston, El Paso, Phoenix, Tustin, Ontario	
DESIGN	HZI
DRAWN	HZI
APPR.	DEM
SCALE	1"=20'
DATE	OCT. 97
PROJECT NO.	01-1822-21
NO.	ST2

THE INFORMATION CONTAINED HEREIN IS THE PROPERTY OF HUIIT-ZOLLARS, INC. AND IS NOT TO BE REPRODUCED OR TRANSMITTED IN ANY FORM OR BY ANY MEANS, ELECTRONIC OR MECHANICAL, INCLUDING PHOTOCOPYING, RECORDING, OR BY ANY INFORMATION STORAGE AND RETRIEVAL SYSTEM, WITHOUT THE WRITTEN PERMISSION OF HUIIT-ZOLLARS, INC.