


NOTE:
CENTER TO CENTER TREE DIMENSIONS
ARE MEASURED ALONG THE CENTERLINE
OF THE STREET.

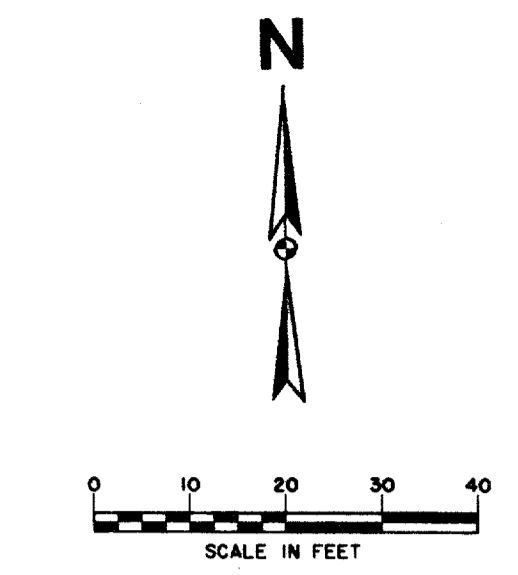

RECORD DRAWING



LEGEND

ELECTRIC	MISC.
○ LIGHT POLE	48" RCP EX. STORM SEWER
pp POWER POLE	— CHAIN LINK FENCE
— GUY WIRE	— WOOD FENCE
TELEPHONE	— EXISTING ASPHALT
● TELEPHONE MANHOLE	— EXISTING DIRT OR GRAVEL
□ TELEPHONE PEDESTAL	— EX. CONCRETE
TS TELEPHONE SIGN	— TREE/TREE LINE
GAS	— EXISTING CURB
GM GAS METER	— PROP. CURB
GS GAS SIGN	— PROP. EDGE OF PAVEMENT NO CURB
LAND USE	— EX. PROPERTY LINE
RR RAILROAD SIGN	— PROP. CENTERLINE
□ SIGN	— PROP. R.O.W.
SURVEY	— PROP. INLET
I.R. FOUND IRON ROD	T.P. TOP OF PAVEMENT
□ BENCHMARK	T.C. TOP OF CURB
WASTEWATER	CR CURB RETURN
WW WASTEWATER MANHOLE	EX. G EXISTING GUTTER
MH CLEANOUT	EX. T.C. EXISTING TOP OF CURB
WATER	B-20 BORING LOCATION
FH FIRE HYDRANT	— EXISTING BRICKS
WM METER	— PAVEMENT REMOVAL
T WATER VALVE	

BENCHMARKS:

BM#1
"C" CUT AT CENTER BACK OF CURB OF INLET, 190 FEET SOUTH FROM THE CENTERLINE INTERSECTION OF ADDISON CIRCLE, WEST SIDE OF QUORUM DRIVE. ELEV. 621.89

BM#4
"C" CUT AT CENTER OF CURB INLET, 1015 FEET NORTH FROM THE CENTERLINE INTERSECTION OF ADDISON CIRCLE, WEST SIDE OF QUORUM DRIVE. ELEV. 629.36

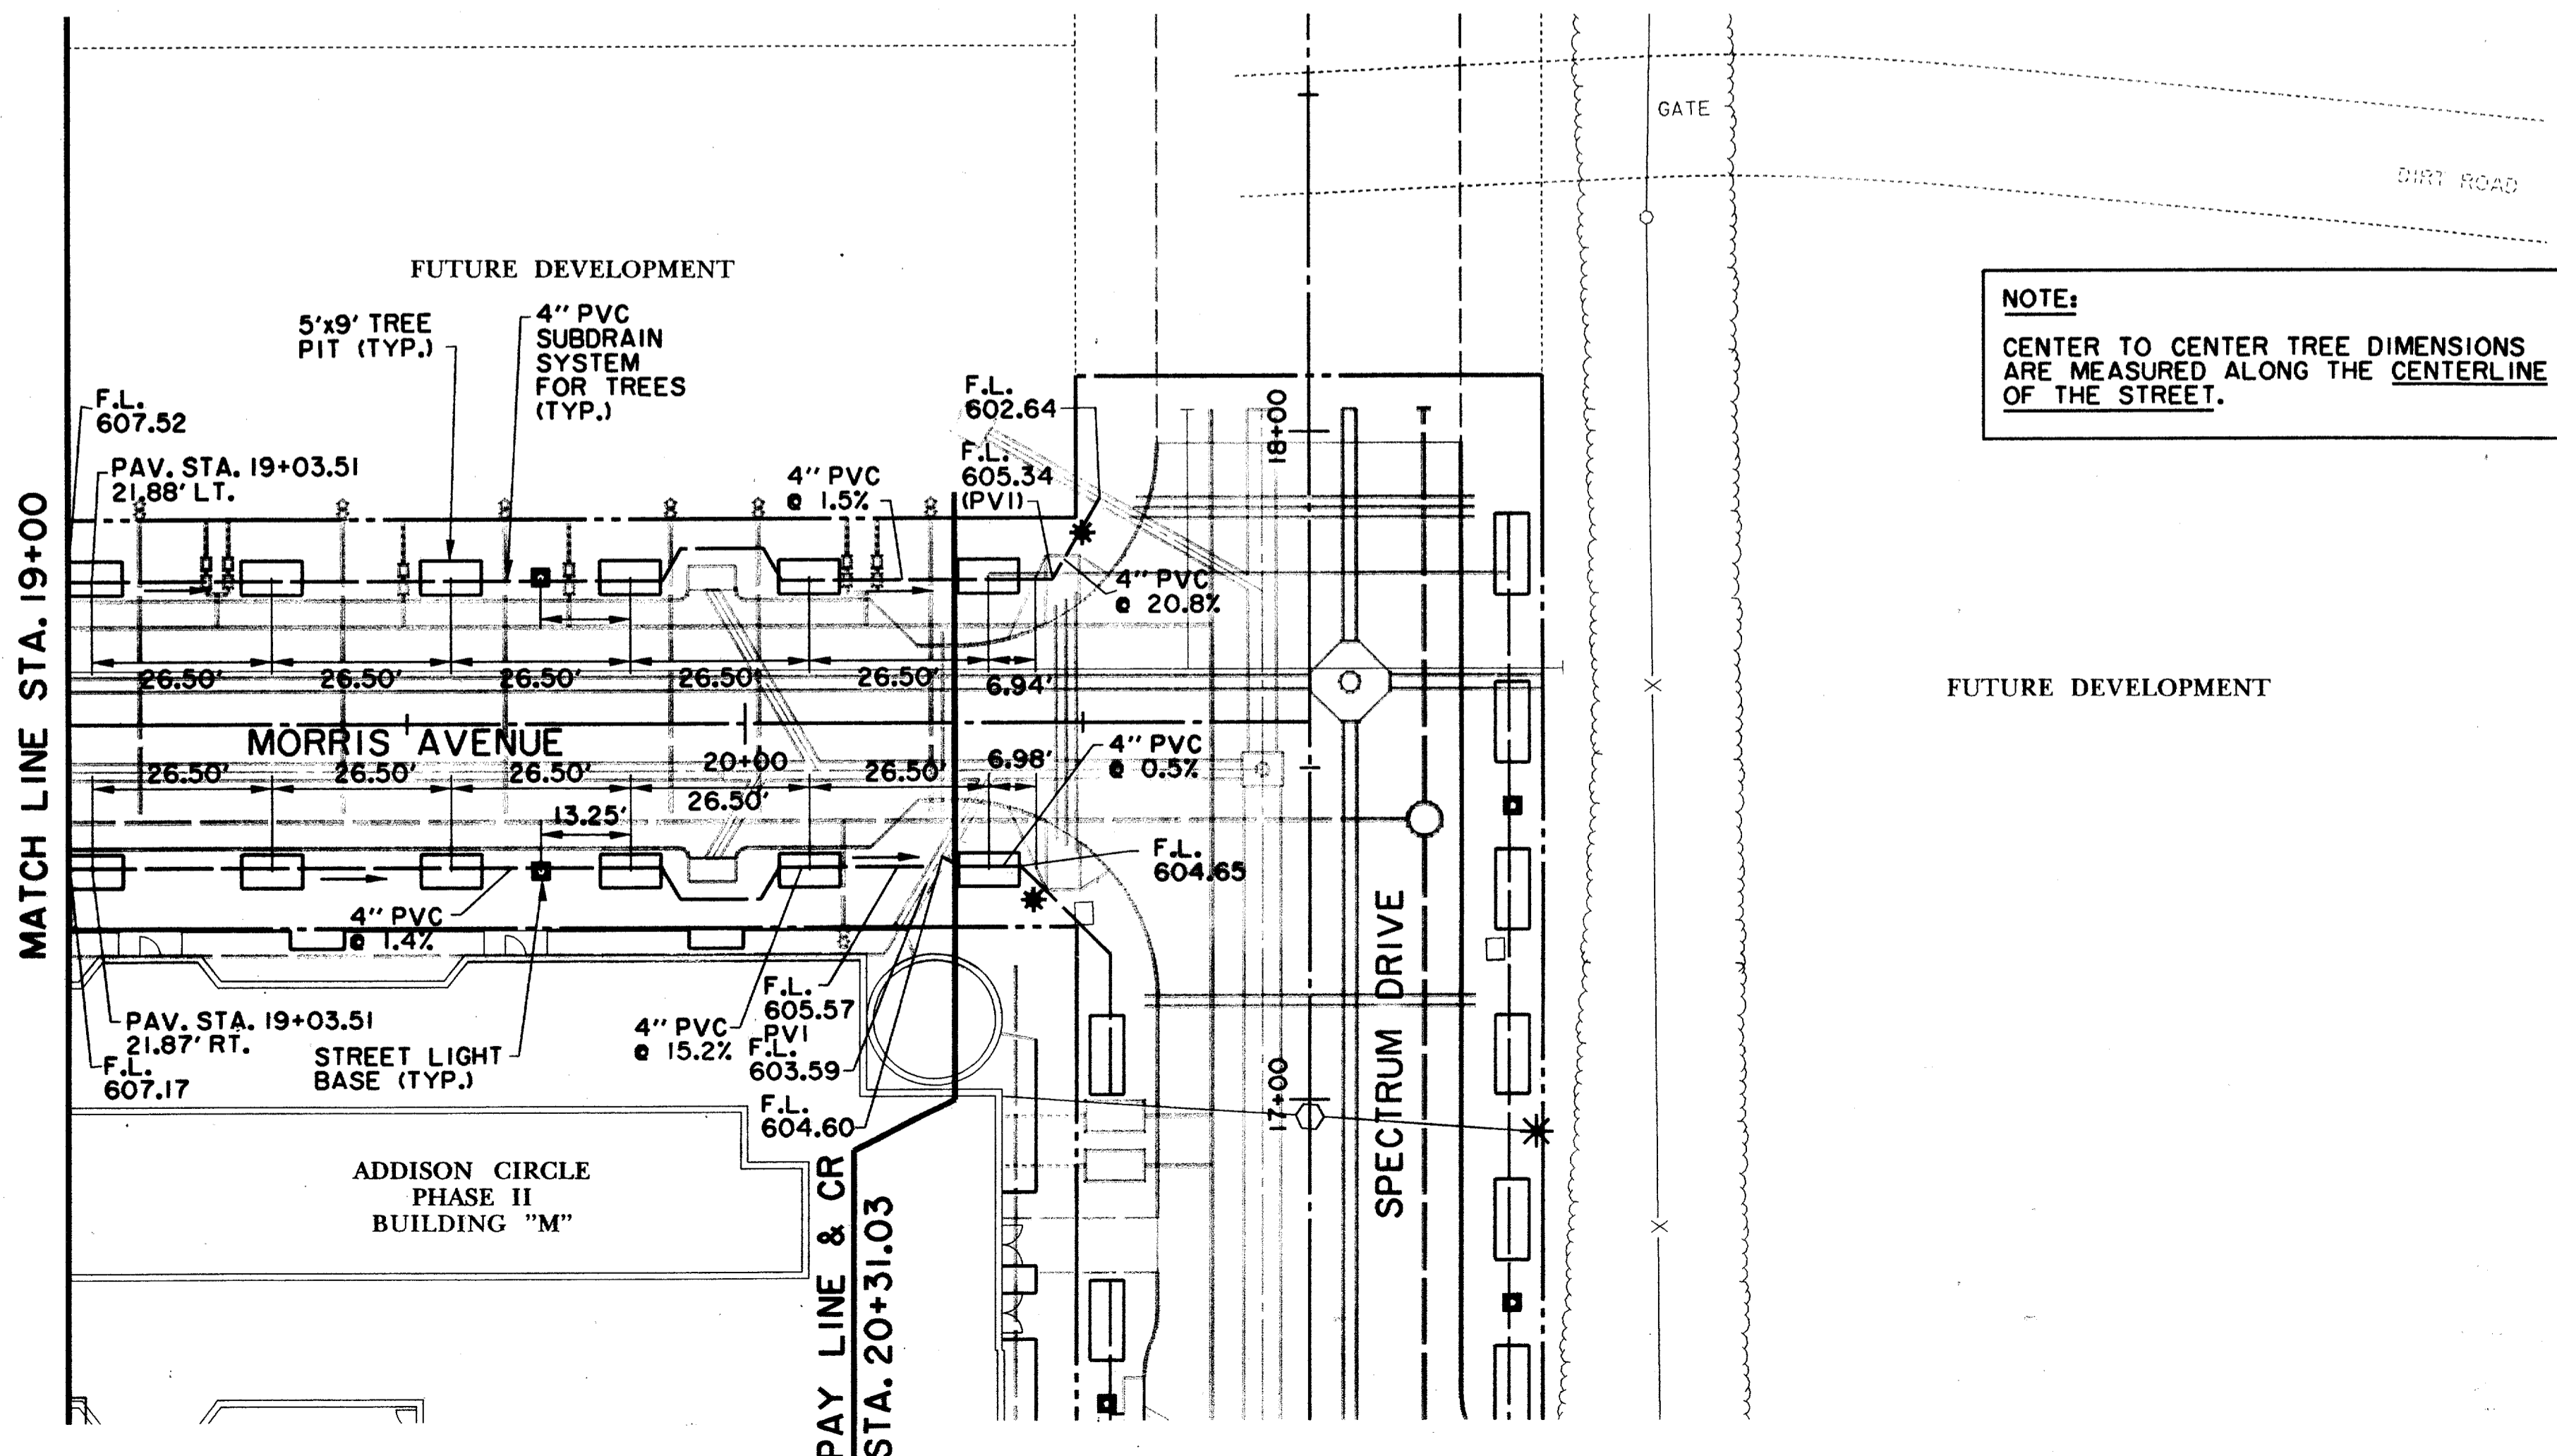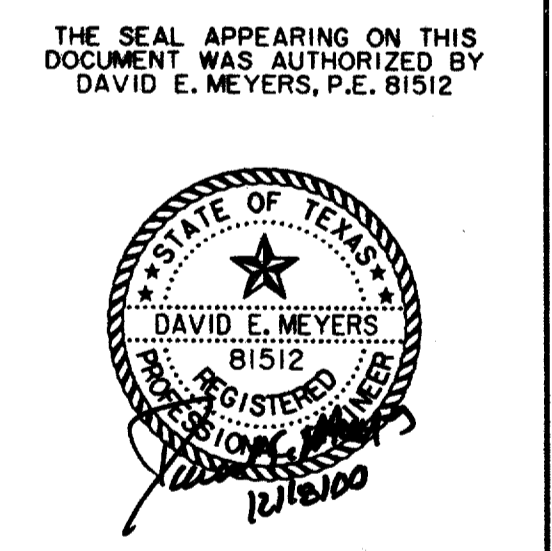

NOTE:
CENTER TO CENTER TREE DIMENSIONS
ARE MEASURED ALONG THE CENTERLINE
OF THE STREET.

DATE	DESCRIPTION	REF. NO.
2/13/98	SHIFTED TREES	▲
10/3/97	ISSUED FOR CONSTRUCTION	N/A
7/14/97	ISSUED FOR BID	N/A

STREETSCAPE PLAN MORRIS AVENUE						
ADDISON CIRCLE						
PHASE II PUBLIC INFRASTRUCTURE						
TOWN OF ADDISON, TEXAS						
<small>Huiit-Zollars, Inc./Engineering/Architecture Dallas, Fort Worth, Houston, El Paso, Phoenix, Tustin, Ontario</small>						
DESIGN	DRAWN	APPR.	SCALE	DATE	PROJECT NO.	NO.
HZI	HZI	DEM	1"=20'	OCT. 97	01-1822-21	ST7

HUIIT-ZOLLARS, INC. ENGINEERING/ARCHITECTURE
 1100 WEST 11TH STREET, SUITE 1000
 FORT WORTH, TEXAS 76102
 TEL: 817-335-1100 FAX: 817-335-1101
 WWW.HUIIT-ZOLLARS.COM

THIS DRAWING IS THE PROPERTY OF HUIIT-ZOLLARS, INC. AND IS NOT TO BE REPRODUCED OR TRANSMITTED IN ANY FORM OR BY ANY MEANS, ELECTRONIC OR MECHANICAL, INCLUDING PHOTOCOPYING, RECORDING, OR BY ANY INFORMATION STORAGE AND RETRIEVAL SYSTEM, WITHOUT THE WRITTEN PERMISSION OF HUIIT-ZOLLARS, INC.