


LEGEND

	ELECTRIC — ONE		MISC.
	LIGHT POLE		EX. STORM SEWER
	POWER POLE		CHAIN LINK FENCE
	GUY WIRE		WOOD FENCE
	TELEPHONE — T		EXISTING ASPHALT
	TELEPHONE MANHOLE		EXISTING DIRT OR GRAVEL
	TELEPHONE PEDESTAL		EX. CONCRETE
	GAS — G		TREE/TREE LINE
	GAS METER		EXISTING CURB
	GAS SIGN		PROP. CURB
	LAND USE		PROP. EDGE OF PAVEMENT NO CURB
	RAILROAD SIGN		EX. PROPERTY LINE
	SIGN		PROP. CENTERLINE
	SURVEY FOUND IRON ROD		PROP. R.O.W.
	BENCHMARK		PROP. INLET
	WASTEWATER MANHOLE		T.P. TOP OF PAVEMENT
	CLEANOUT		T.C. TOP OF CURB
	WATER — W		CR CURB RETURN
	FIRE HYDRANT		EX. G. EXISTING GUTTER
	METER		EXISTING TOP OF CURB
	WATER VALVE		B-20 BORING LOCATION
			EXISTING BRICKS
			PAVEMENT REMOVAL

MATCH LINE PAV. STA. 14+52.23 = LINE 'L' STA. 1+50.00

RECORD DRAWING

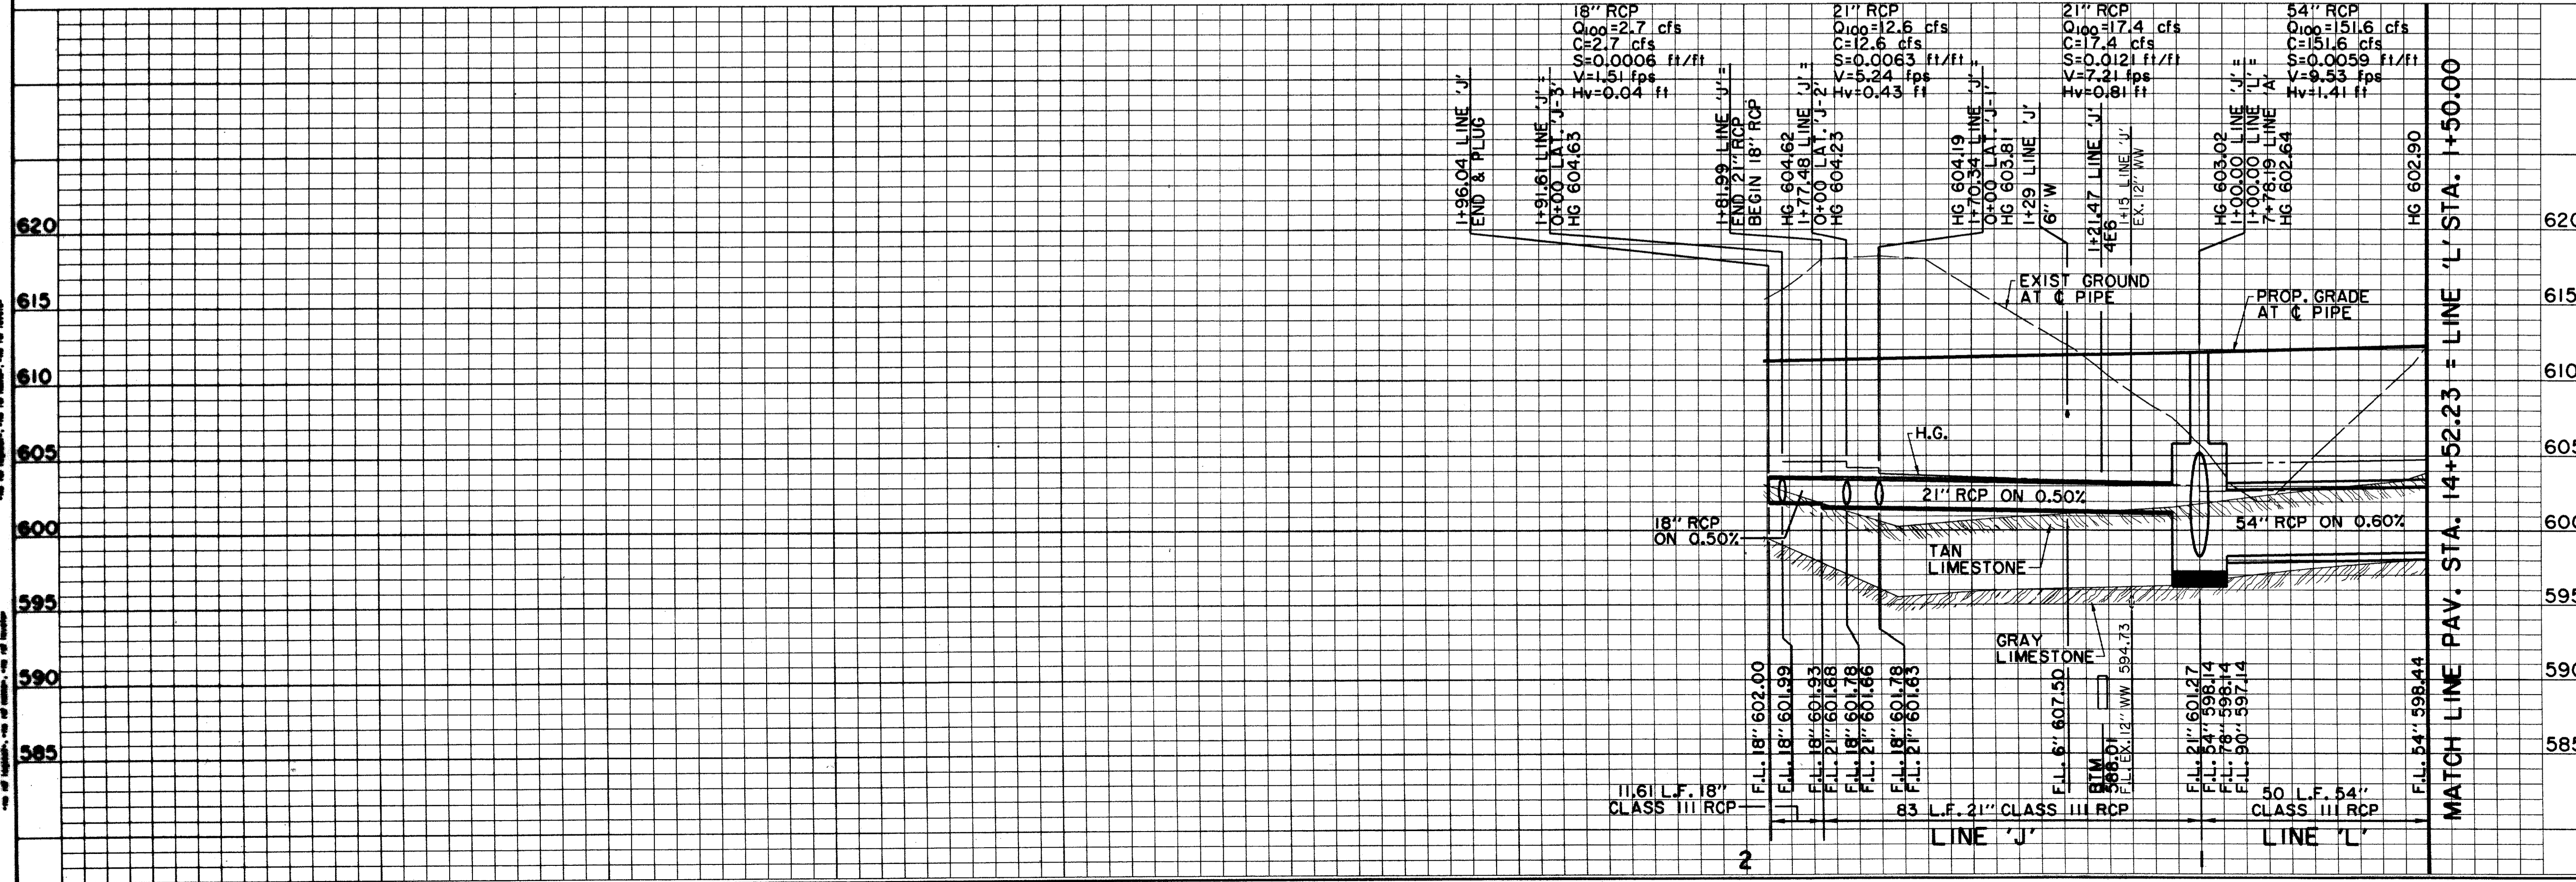

BENCHMARKS:

BM#5
"C" CUT AT NORTHWEST CORNER OF NORTH HDWL. OF 7'x7' BOX CULVERT UNDER RAILROAD, ±180' WEST OF DALLAS PARKWAY SOUTHBOUND. ELEV. 610.49

BM#6
"C" CUT AT CENTER FRONT OF 18' REC. INLET SECOND INLET NORTH OF RAILROAD TRACKS ON THE WEST SIDE OF DALLAS PARKWAY SOUTHBOUND. ELEV. 605.67

THE SEAL APPEARING ON THIS DOCUMENT WAS AUTHORIZED BY DAVID E. MEYERS, P.E. 81512

DATE	DESCRIPTION	REF. NO.
10/3/97	ISSUED FOR CONSTRUCTION	N/A
7/14/97	ISSUED FOR BID	N/A

STORM WATER PLAN & PROFILE
LINE 'J' & LINE 'L' STA. 1+00 TO STA. 1+50

ADDISON CIRCLE
PHASE II PUBLIC INFRASTRUCTURE
TOWN OF ADDISON, TEXAS

Hull-Zollars, Inc./Engineering/Architecture
Dallas, Fort Worth, Houston, El Paso, Phoenix,ustin, Ontario

DESIGN	DRAWN	APPR.	SCALE	DATE	PROJECT NO.	NO.
HZI	HZI	DEM	H ₁ 1"=20' V ₁ 1"=6'	OCT. 97	01-1822-21	SWI5

HULL-ZOLLARS, INC.
 11111 W. LAKELAND BLVD., SUITE 100
 FORT WORTH, TEXAS 76147
 (817) 336-1111
 FAX (817) 336-1112
 WWW.HULLZOLLARS.COM