

**NOTE:**  
METERS, METER CANS, VAULTS AND BACKFLOW PREVENTION ASSEMBLIES TO BE INSTALLED AND TESTED PER TOWN OF ADDISON GENERAL REQUIREMENTS.

**LEGEND**


ELECTRIC — O —	48" RCP	EX. STORM SEWER
LIGHT POLE	CHAIN LINK FENCE	WOOD FENCE
POWER POLE	EXISTING ASPHALT	EXISTING DIRT OR GRAVEL
GUY WIRE	EX. CONCRETE	TREE/TREE LINE
TELEPHONE — T —	EXISTING CURB	PROP. CURB
TELEPHONE MANHOLE	PROP. EDGE OF PAVEMENT NO CURB	EX. PROPERTY LINE
TELEPHONE PEDESTAL	PROP. CENTERLINE	PROP. R.O.W.
TELEPHONE SIGN	PROP. INLET	T.P. TOP OF PAVEMENT
GAS — G —	T.C. TOP OF CURB	CR CURB RETURN
GAS METER	EX. G. EXISTING GUTTER	EX. T.C. EXISTING TOP OF CURB
GAS SIGN	B-20 BORING LOCATION	EXISTING BRICKS
LAND USE	PAVEMENT REMOVAL	
RAILROAD SIGN		
SIGN		
SURVEY		
FOUND IRON ROD		
BENCHMARK		
WASTEWATER — WW —		
WASTEWATER MANHOLE CLEANOUT		
WATER — W —		
FIRE HYDRANT		
METER		
WATER VALVE		

LINE 4 STA. 21+01.83 =  
LINE 2 STA. 10+11.96 =  
PAV. STA. 10+11.82  
INSTALL:  
1 - 8" GATE VALVE/BOX  
1 - 8" 45° HORIZONTAL BEND  
CONCRETE BLOCKING

**CAUTION I:**  
EXISTING 12" HIGH PRESSURE PETROLEUM. DEPTH MUST BE VERIFIED PRIOR TO ANY CONSTRUCTION WITH EXPLORER REPRESENTATIVE ON SITE. CONTACT JACK PHILLIPS WITH EXPLORER PIPELINE AT THE FOLLOWING NUMBERS:  
OFFICE 817-481-4040,  
PAGER 817-432-0153,  
MOBILE 214-808-3286

**CAUTION II:**  
EXISTING FIBER OPTIC CABLE IN THIS AREA. CONTACT T.E.S.S. ONE CALL AT (800) 344-8337 AT LEAST 48 HOURS PRIOR TO CONSTRUCTION. IN CASE OF EMERGENCY CALL SPRINT AT (800) 521-0579.

**RECORD DRAWING**

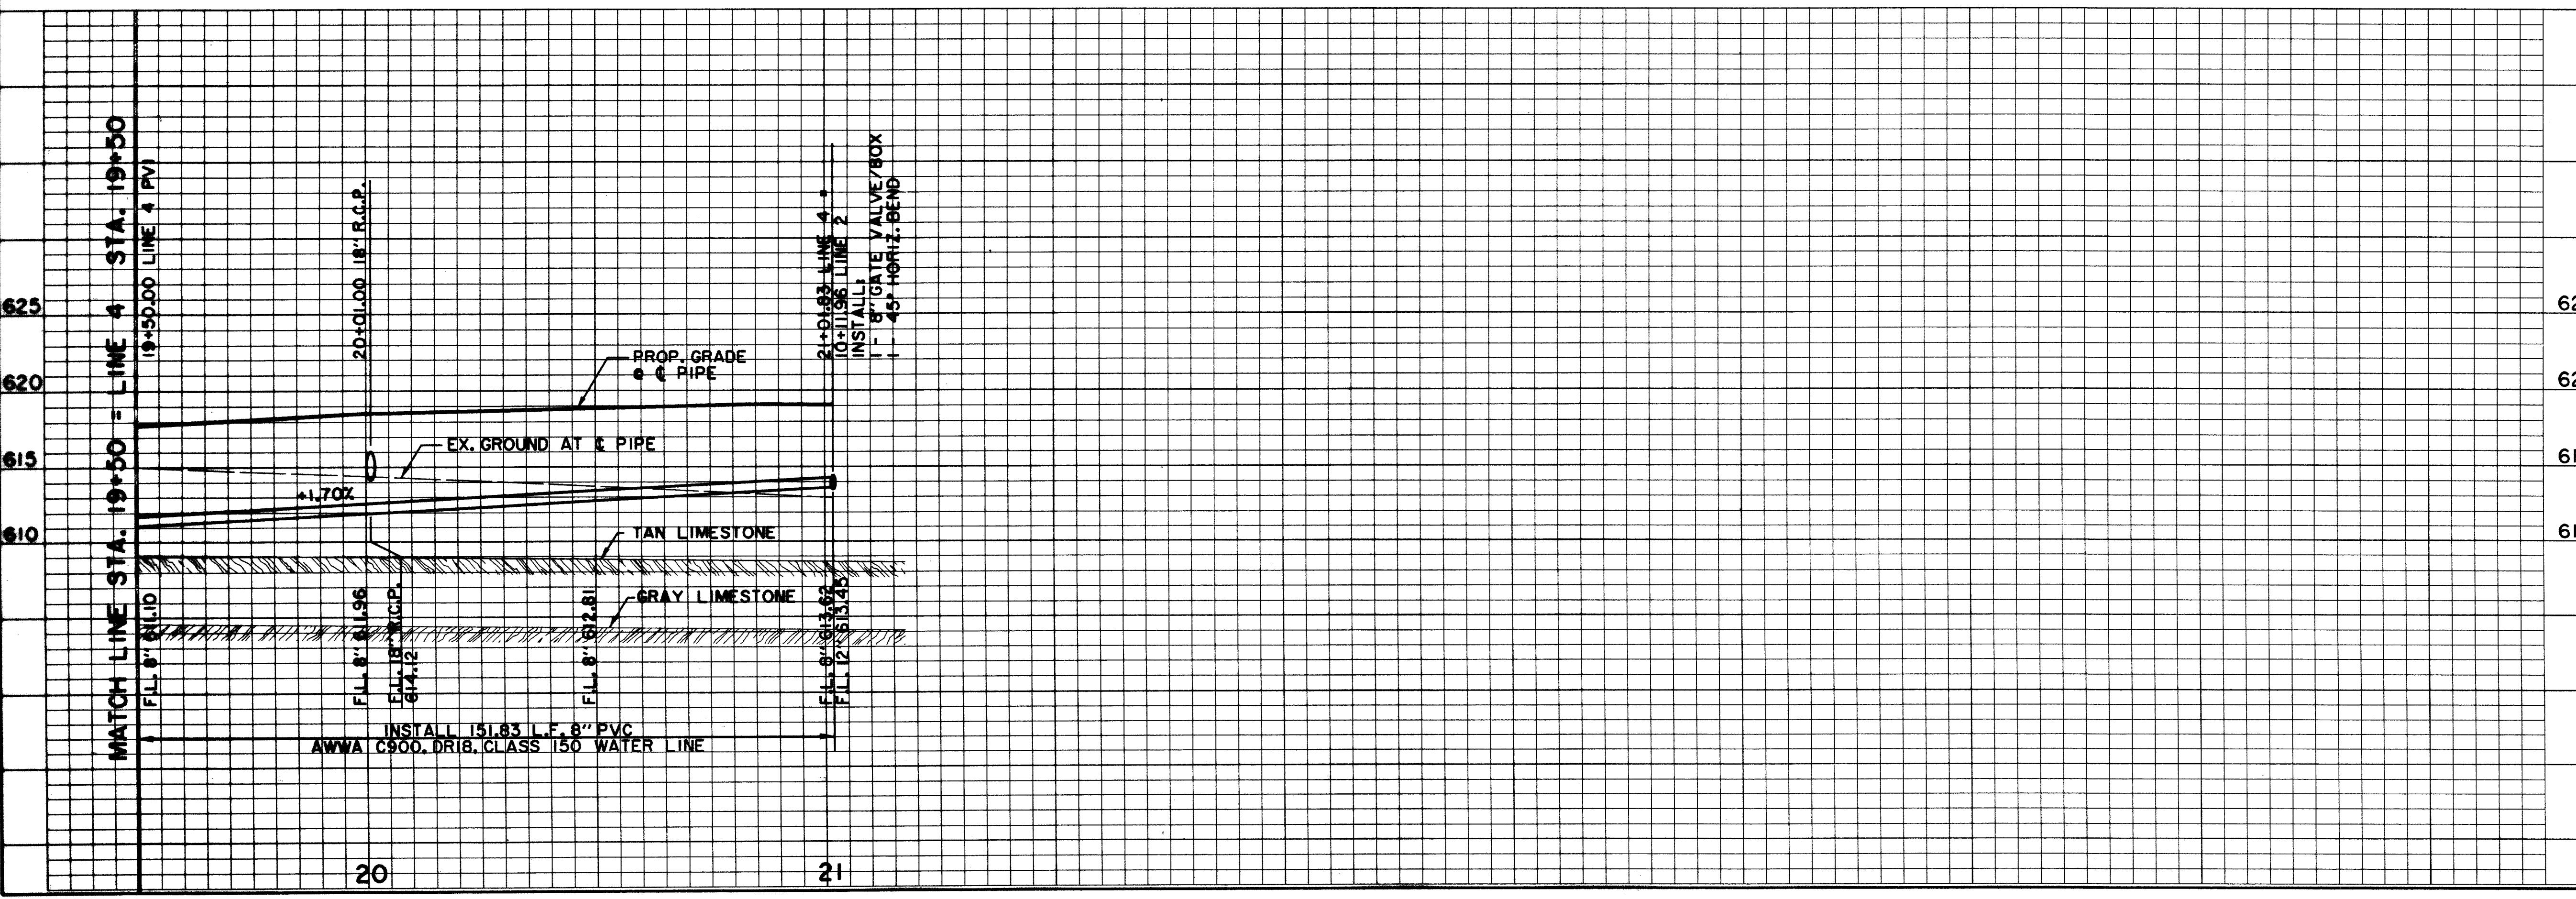

**BENCHMARKS:**  
BM#1  
"I" CUT AT CENTER BACK OF CURB OF INLET, 190 FEET SOUTH FROM THE CENTERLINE INTERSECTION OF MILDRED STREET, WEST SIDE OF QUORUM DRIVE. ELEV. 621.89  
BM#4  
"I" CUT AT CENTER OF CURB INLET, 1015 FEET NORTH FROM THE CENTERLINE INTERSECTION OF MILDRED STREET, WEST SIDE OF QUORUM DRIVE. ELEV. 629.36

THE SEAL APPEARING ON THIS DOCUMENT WAS AUTHORIZED BY DAVID E. MEYERS, P.E. 81512

DATE	DESCRIPTION	REF. NO.
10/3/97	ISSUED FOR CONSTRUCTION	N/A
7/14/97	ISSUED FOR BID	N/A

**WATER PLAN & PROFILE**  
LINE 4 - M-3

**ADDISON CIRCLE**  
PHASE II PUBLIC INFRASTRUCTURE  
TOWN OF ADDISON, TEXAS

Huitt-Zollars, Inc./Engineering/Architecture  
Dallas, Fort Worth, Houston, El Paso, Phoenix, Tustin, Ontario

DESIGN	DRAWN	APPR.	SCALE	DATE	PROJECT NO.	NO.
HZ1	HZ1	DEM	H:V = 20':1"	OCT. 97	01-1822-21	WIO

PROJECT NO. 01-1822-21  
 SHEET NO. 20 OF 21  
 DATE: 10/3/97  
 DRAWN BY: HZ1  
 CHECKED BY: DEM  
 APPROVED BY: [Signature]  
 HUIITT-ZOLLARS, INC.  
 1100 WEST WILSON AVENUE, SUITE 100  
 DALLAS, TEXAS 75207  
 TEL: 214-343-1100  
 FAX: 214-343-1101  
 WWW: WWW.HUIITT-ZOLLARS.COM